

Nº 2105

"PONNY"

QUARTER WHEEL MOTOR VESSELS

FOR

INLAND WATER TRANSPORT BOARD, BURMA.



CONSTRUCTIONAL SECTIONS (AS FITTED).

SCALE: $\frac{1}{2}$ - 1 FOOT.



| | |
|-----------------------|---------|
| LENGTH OVERALL | 148'-6" |
| LENGTH HULL EX TONGUE | 134'-0" |
| LENGTH WATERLINE | 130'-0" |
| BREADTH MOULDED | 34'-0" |
| DEPTH | 5'-6" |
| LOAD DRAUGHT | 4'-0" |

EQUIPMENT :-
ONE STOCKLESS ANCHOR - 6 CHTS.
45 FATHOMS $\frac{7}{8}$ STUD LINK CABLE
IN THREE 15 FATHOM LENGTHS.

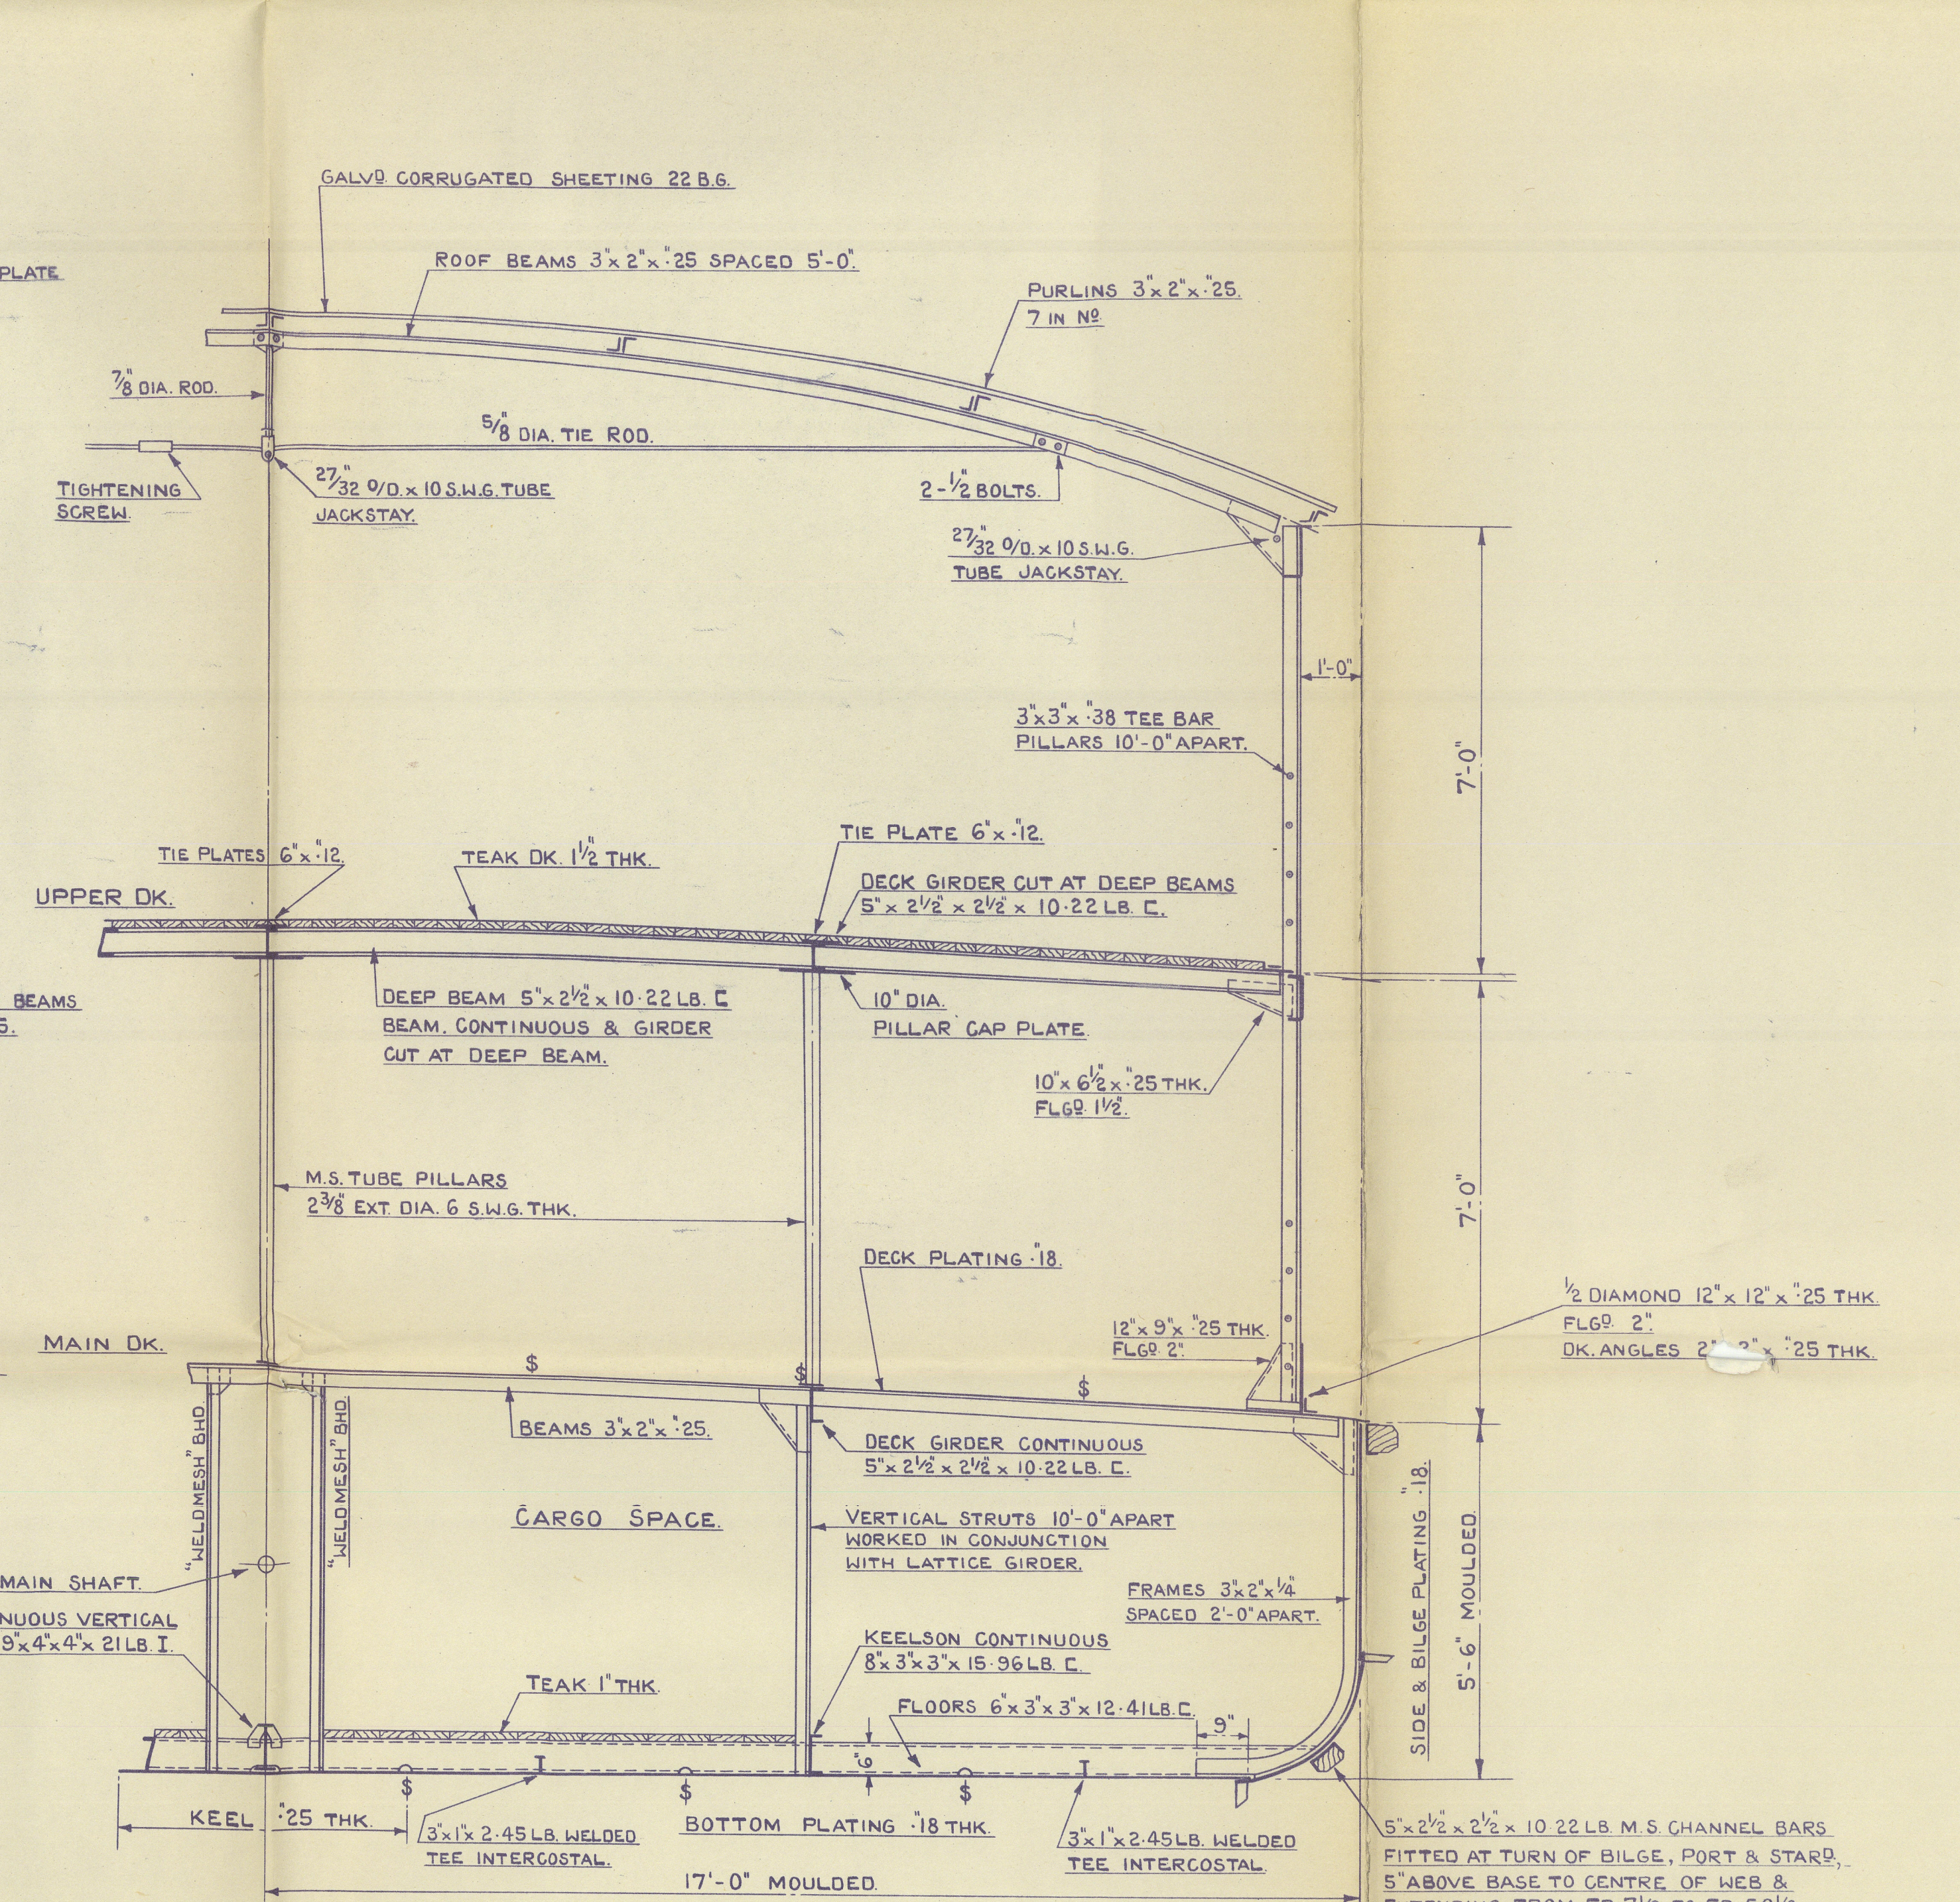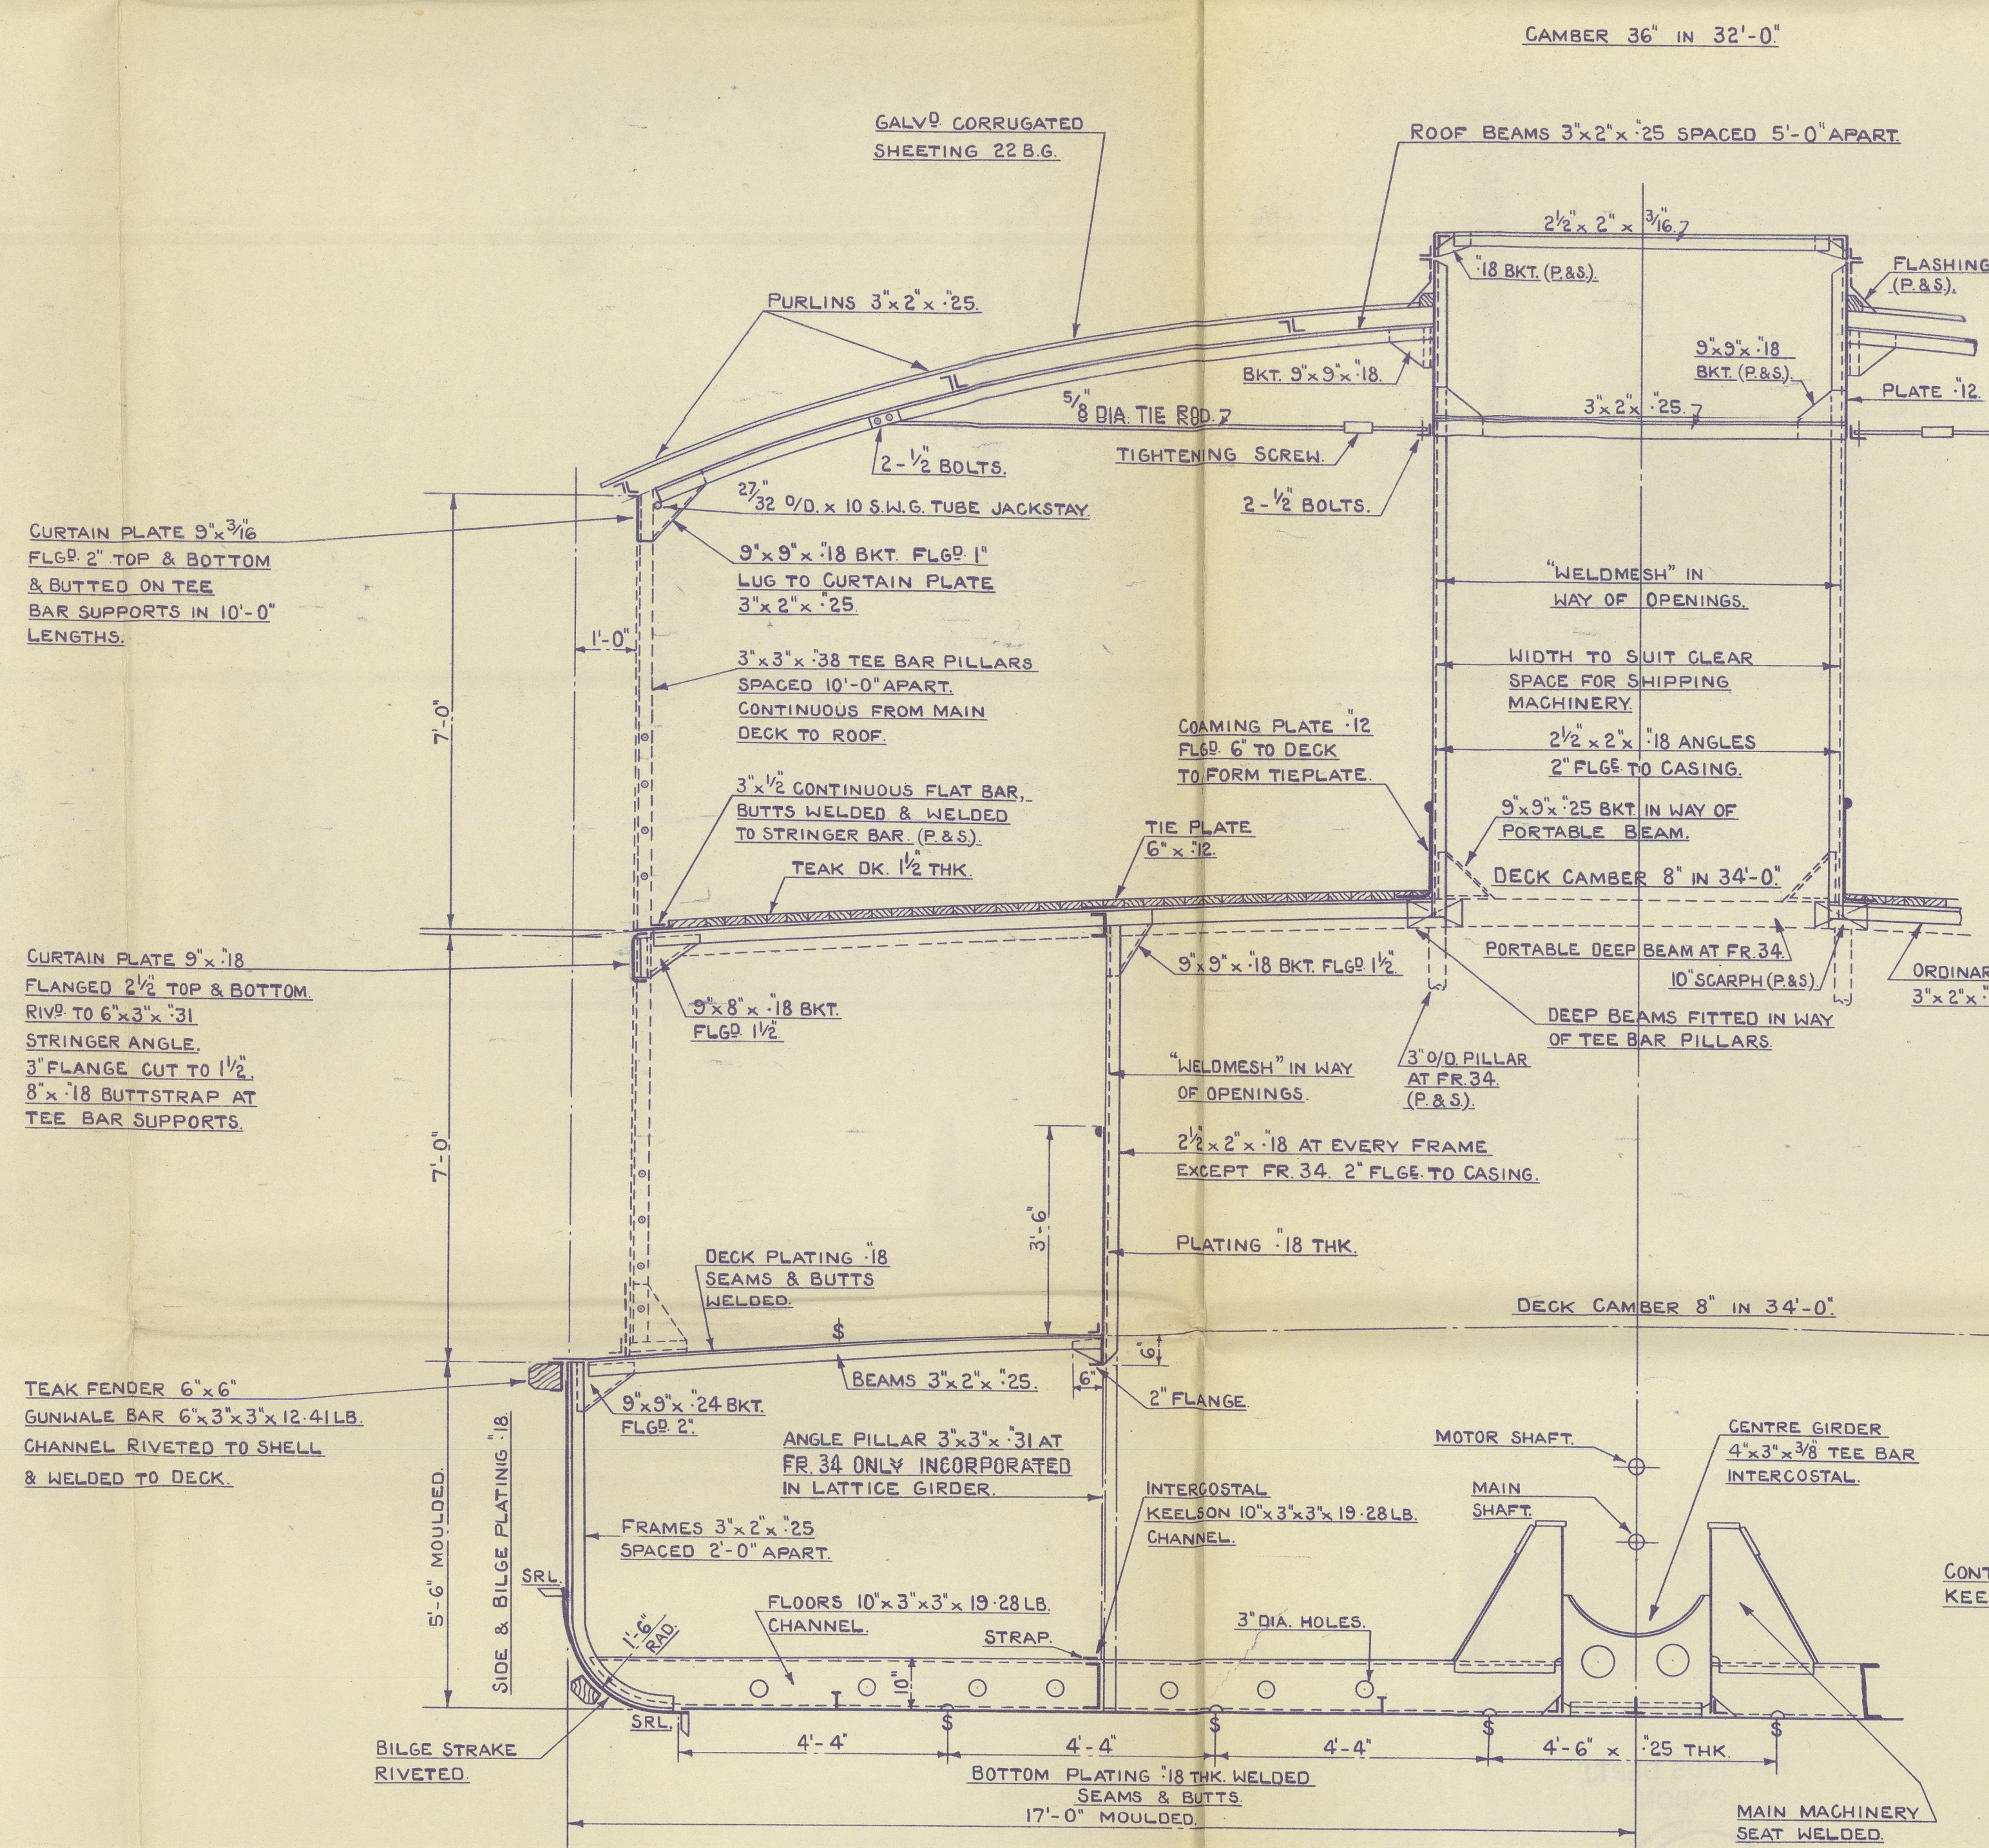


Nº 40788.

Nº 40788.

011636-011645-0046

PONNYA ★

RECORDS DEPT.
LONDON.

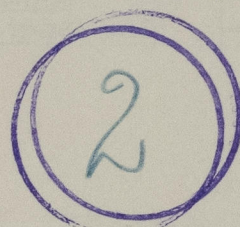

RECORDS DEPT.
LONDON.

Midship Section
as fitted