

NOTE:-

F.T. = FOLDING TABLE.



W.B. = WASH BASIN.

S.H. = SHOWER.

S. = SINK.

M.S. = MEAT SAFE.

L. = LOCKER.

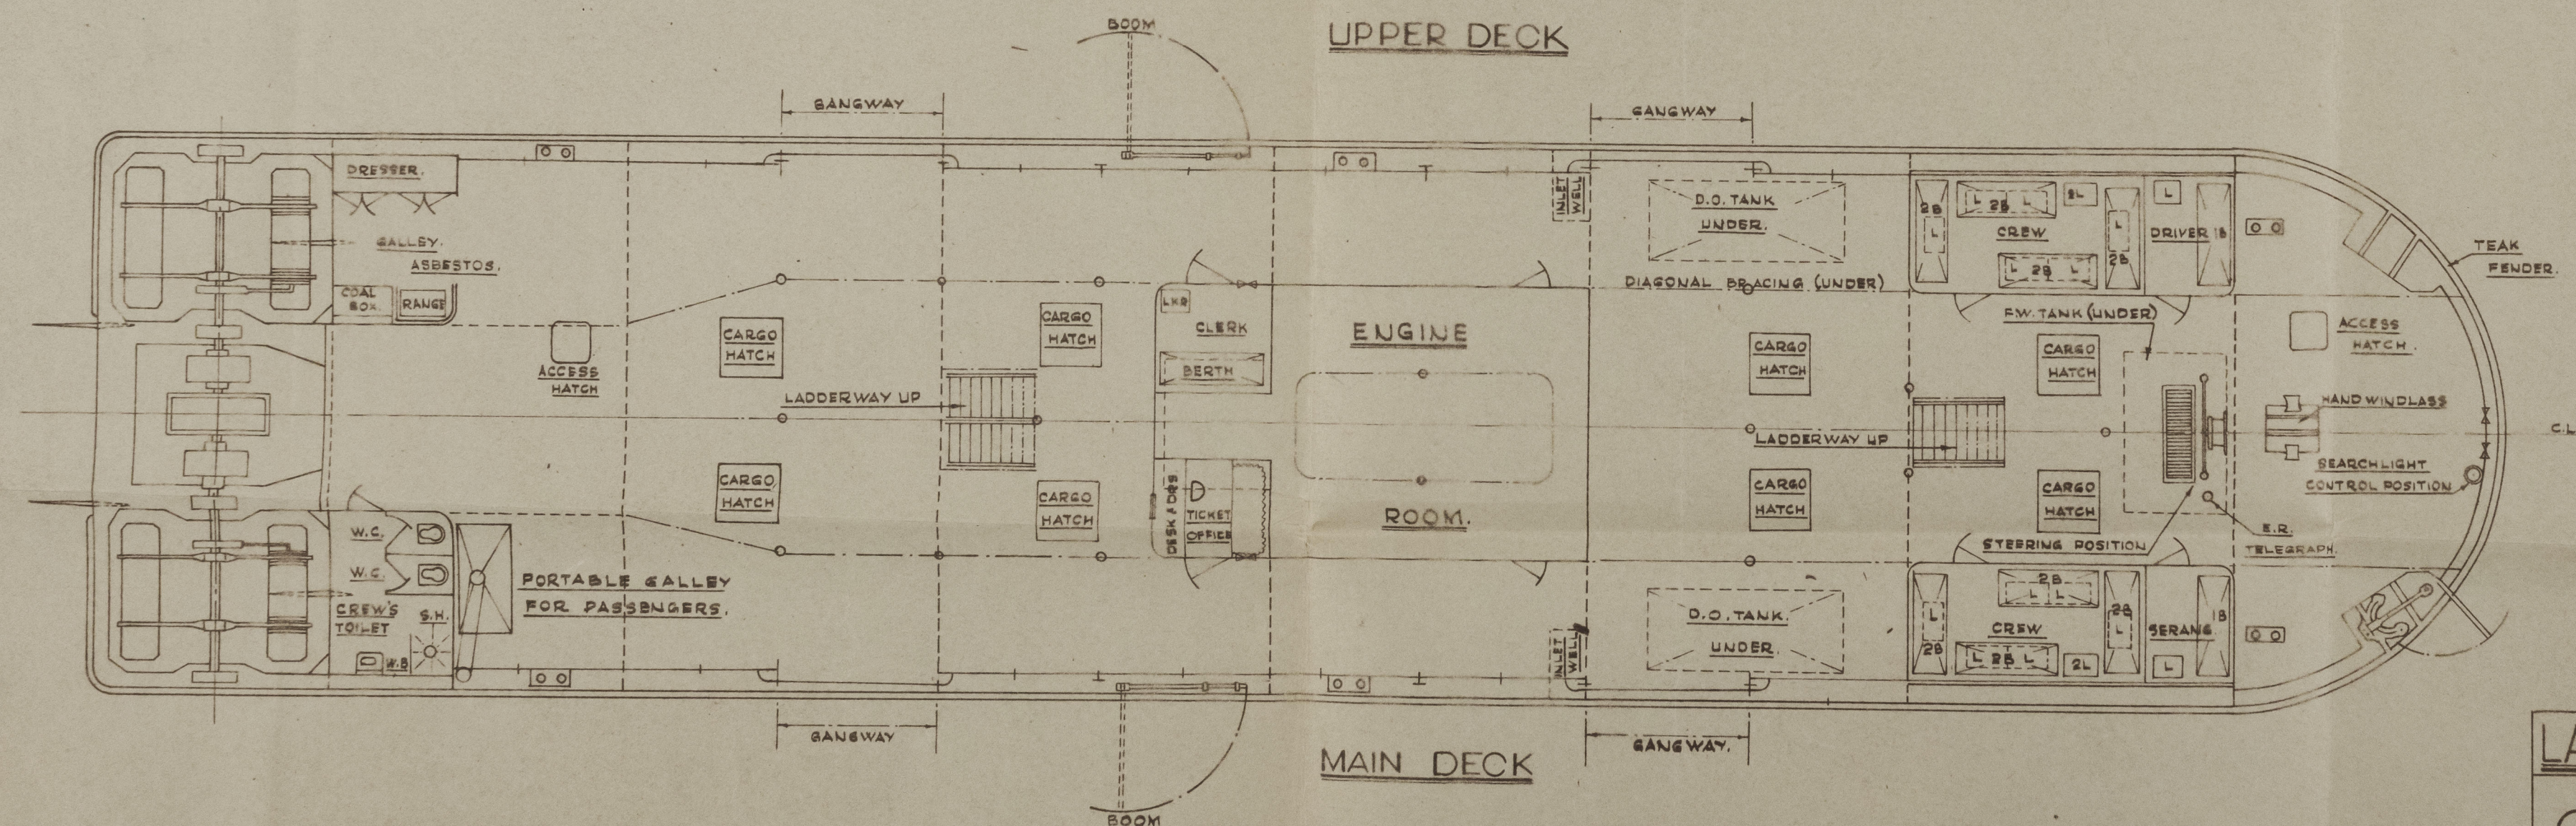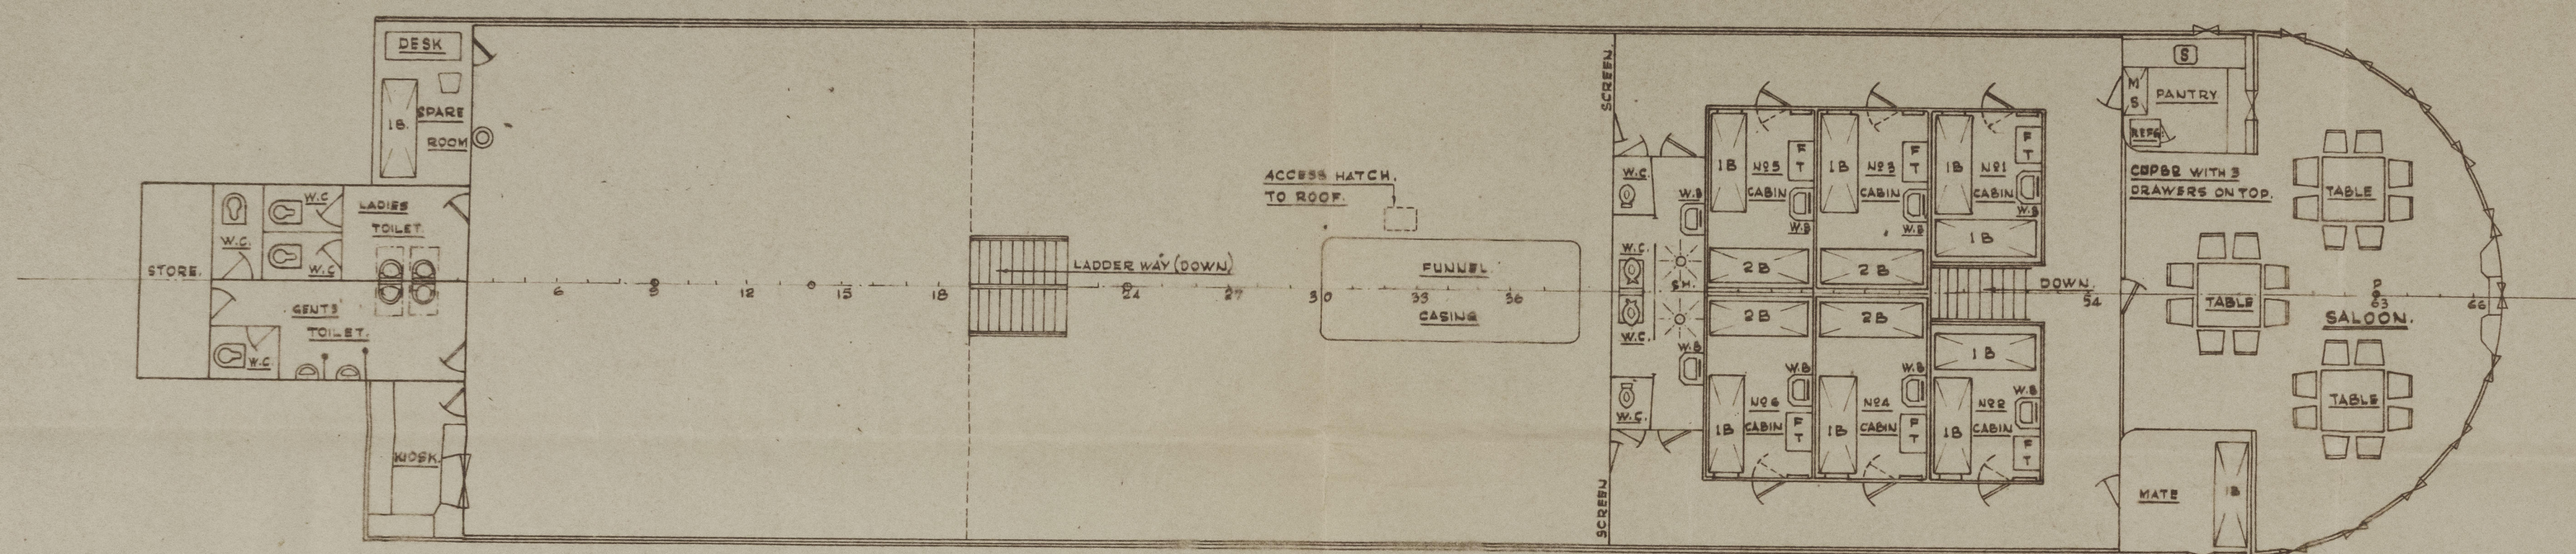

LARGE QUARTER WHEELER (130'x34'x3.6')

GENERAL ARRANGEMENT

AS FINISHED PLAN

DRAWN BY *M. G. C.* TRACED BY *M. G. C.* CHECKED BY *M. G. C.*  
DATE 12.12.31 DATE 22.1.32 DATE 1.2.32

SCALE:- 1/8" = 1 FOOT DRAWING NO. R/404

011636-011645-0079



Reg 2147.

"PONNYA"

011636-011645-0079



© 2021

Lloyd's Register  
Foundation