

PROFILE

NOTE:-

F.T. = FOLDING TABLE.


W.B. = WASH BASIN.

S.H. = SHOWER.


S. = SINK.

M.S. = MEAT SAFE.

L. = LOCKER.

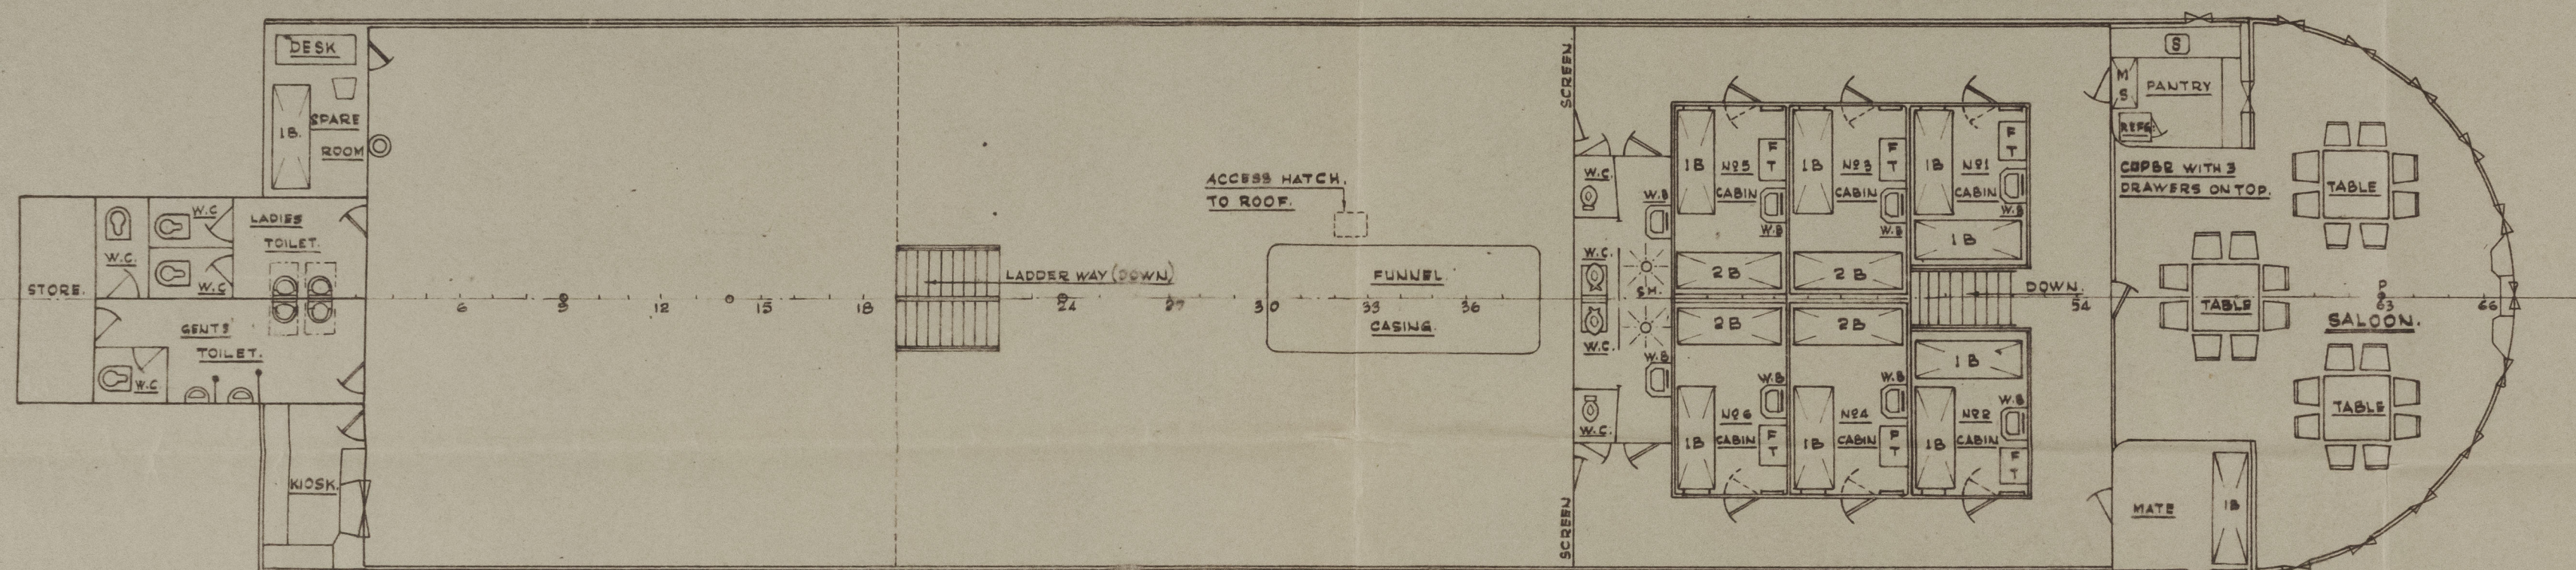

UPPER DECK

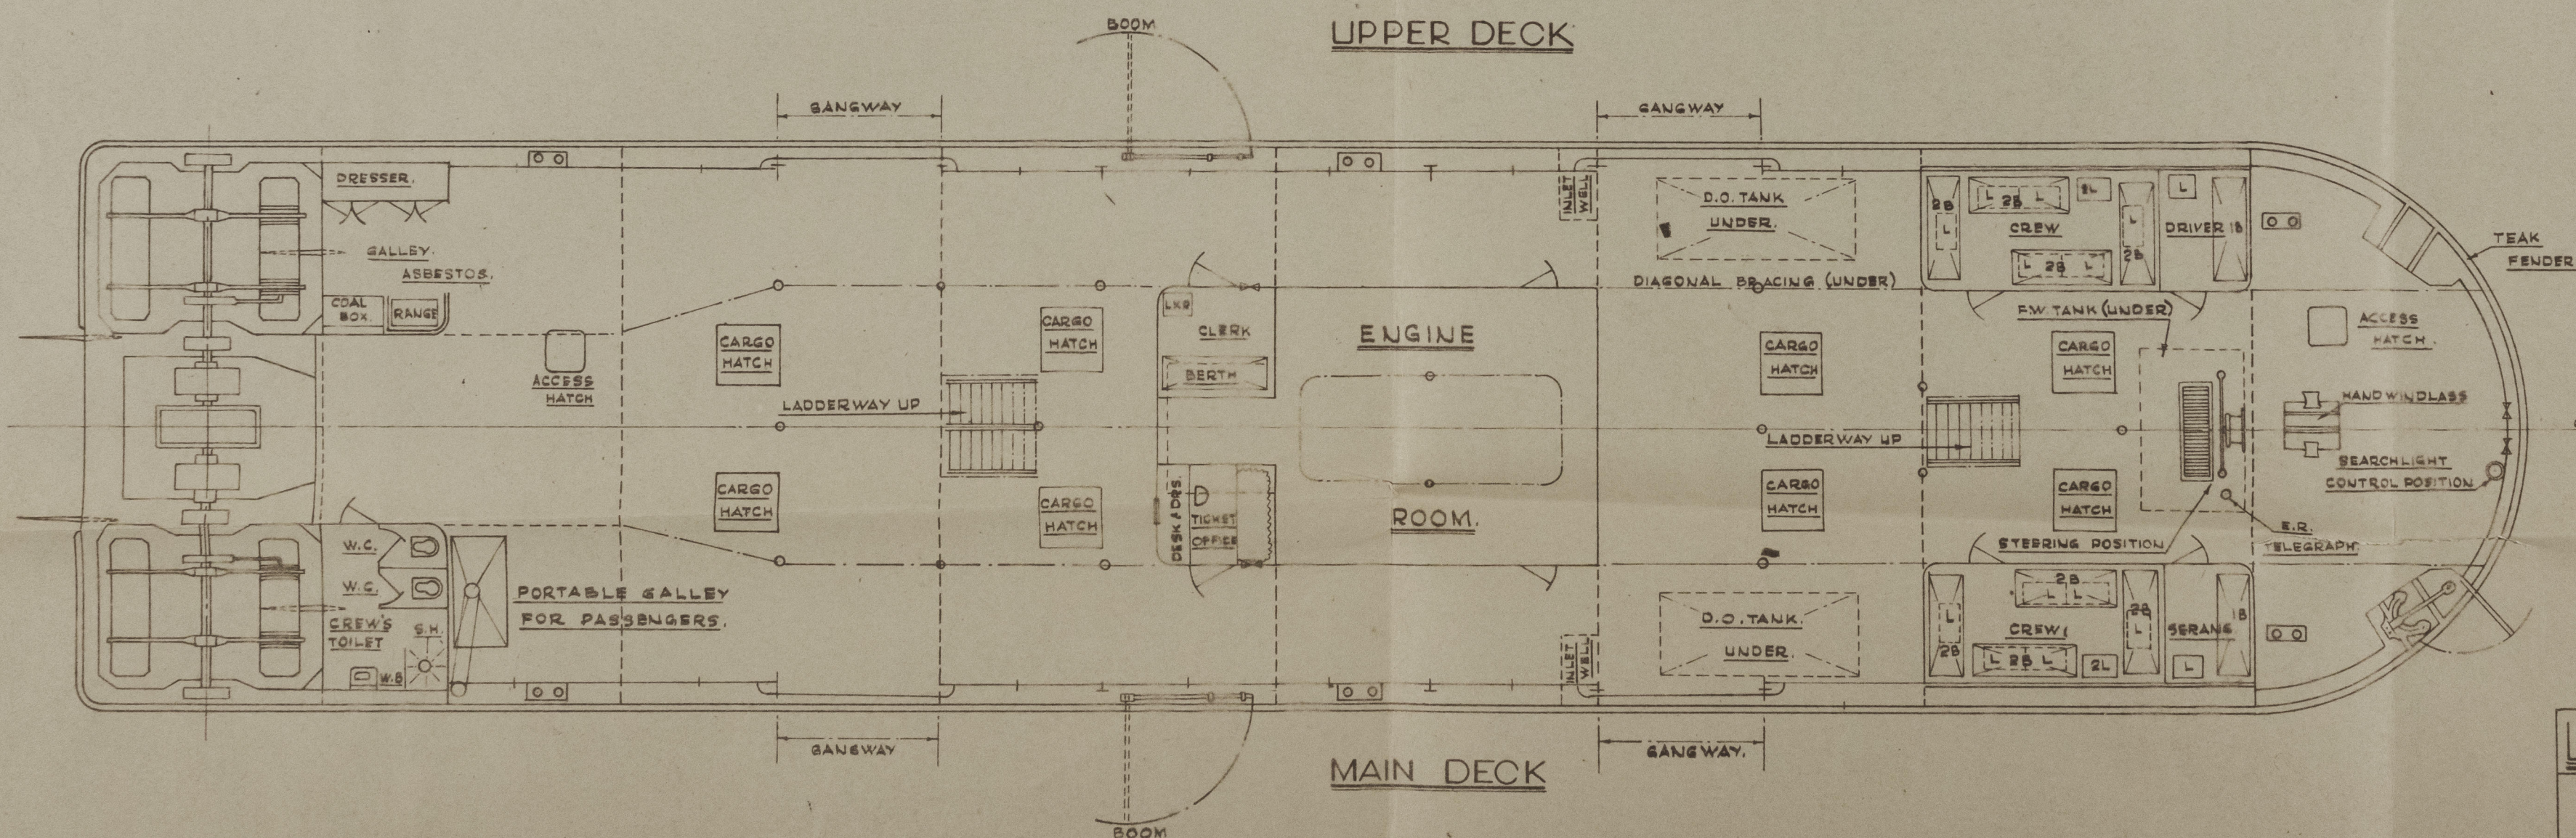

MAIN DECK

LARGEQUARTER WHEELER (130'x34'x3.6')

GENERAL ARRANGEMENT

AS FINISHED PLAN

DRAWN BY *M. G. L.* TRACED BY *M. G. L.* CHECKED BY *M. G. L.*

DATE 12.12.57 DATE 22.1.58 DATE

SCALE:- 1/8" = 1 FOOT DRAWING NO. R/404

011636-011645-0262



REN 2149.

"PONDALUNG"

---

General arrangement.



© 2021

Lloyd's Register

Foundation

011636-01645-6262