

PONDAUNG, PONNYA, PADASHIN, PADAMYA & PADAPYAN.

QUARTER WHEEL MOTOR VESSELS

FOR

INLAND WATER TRANSPORT BOARD, BURMA.


CONSTRUCTIONAL SECTIONS. (AS FITTED).

SCALE: $\frac{1}{2}$ " = 1 FOOT.




LENGTH OVERALL	148'-6"
LENGTH HULL EX TONGUE	134'-0"
LENGTH WATERLINE	130'-0"
BREADTH MOULDED	34'-0"
DEPTH	5'-6"
LOAD DRAUGHT	4'-0"

EQUIPMENT:-
ONE STOCKLESS ANCHOR - 6 CHTS.
45 FATHOMS $\frac{7}{8}$ " STUD LINK CABLE
IN THREE 15 FATHOM LENGTHS.

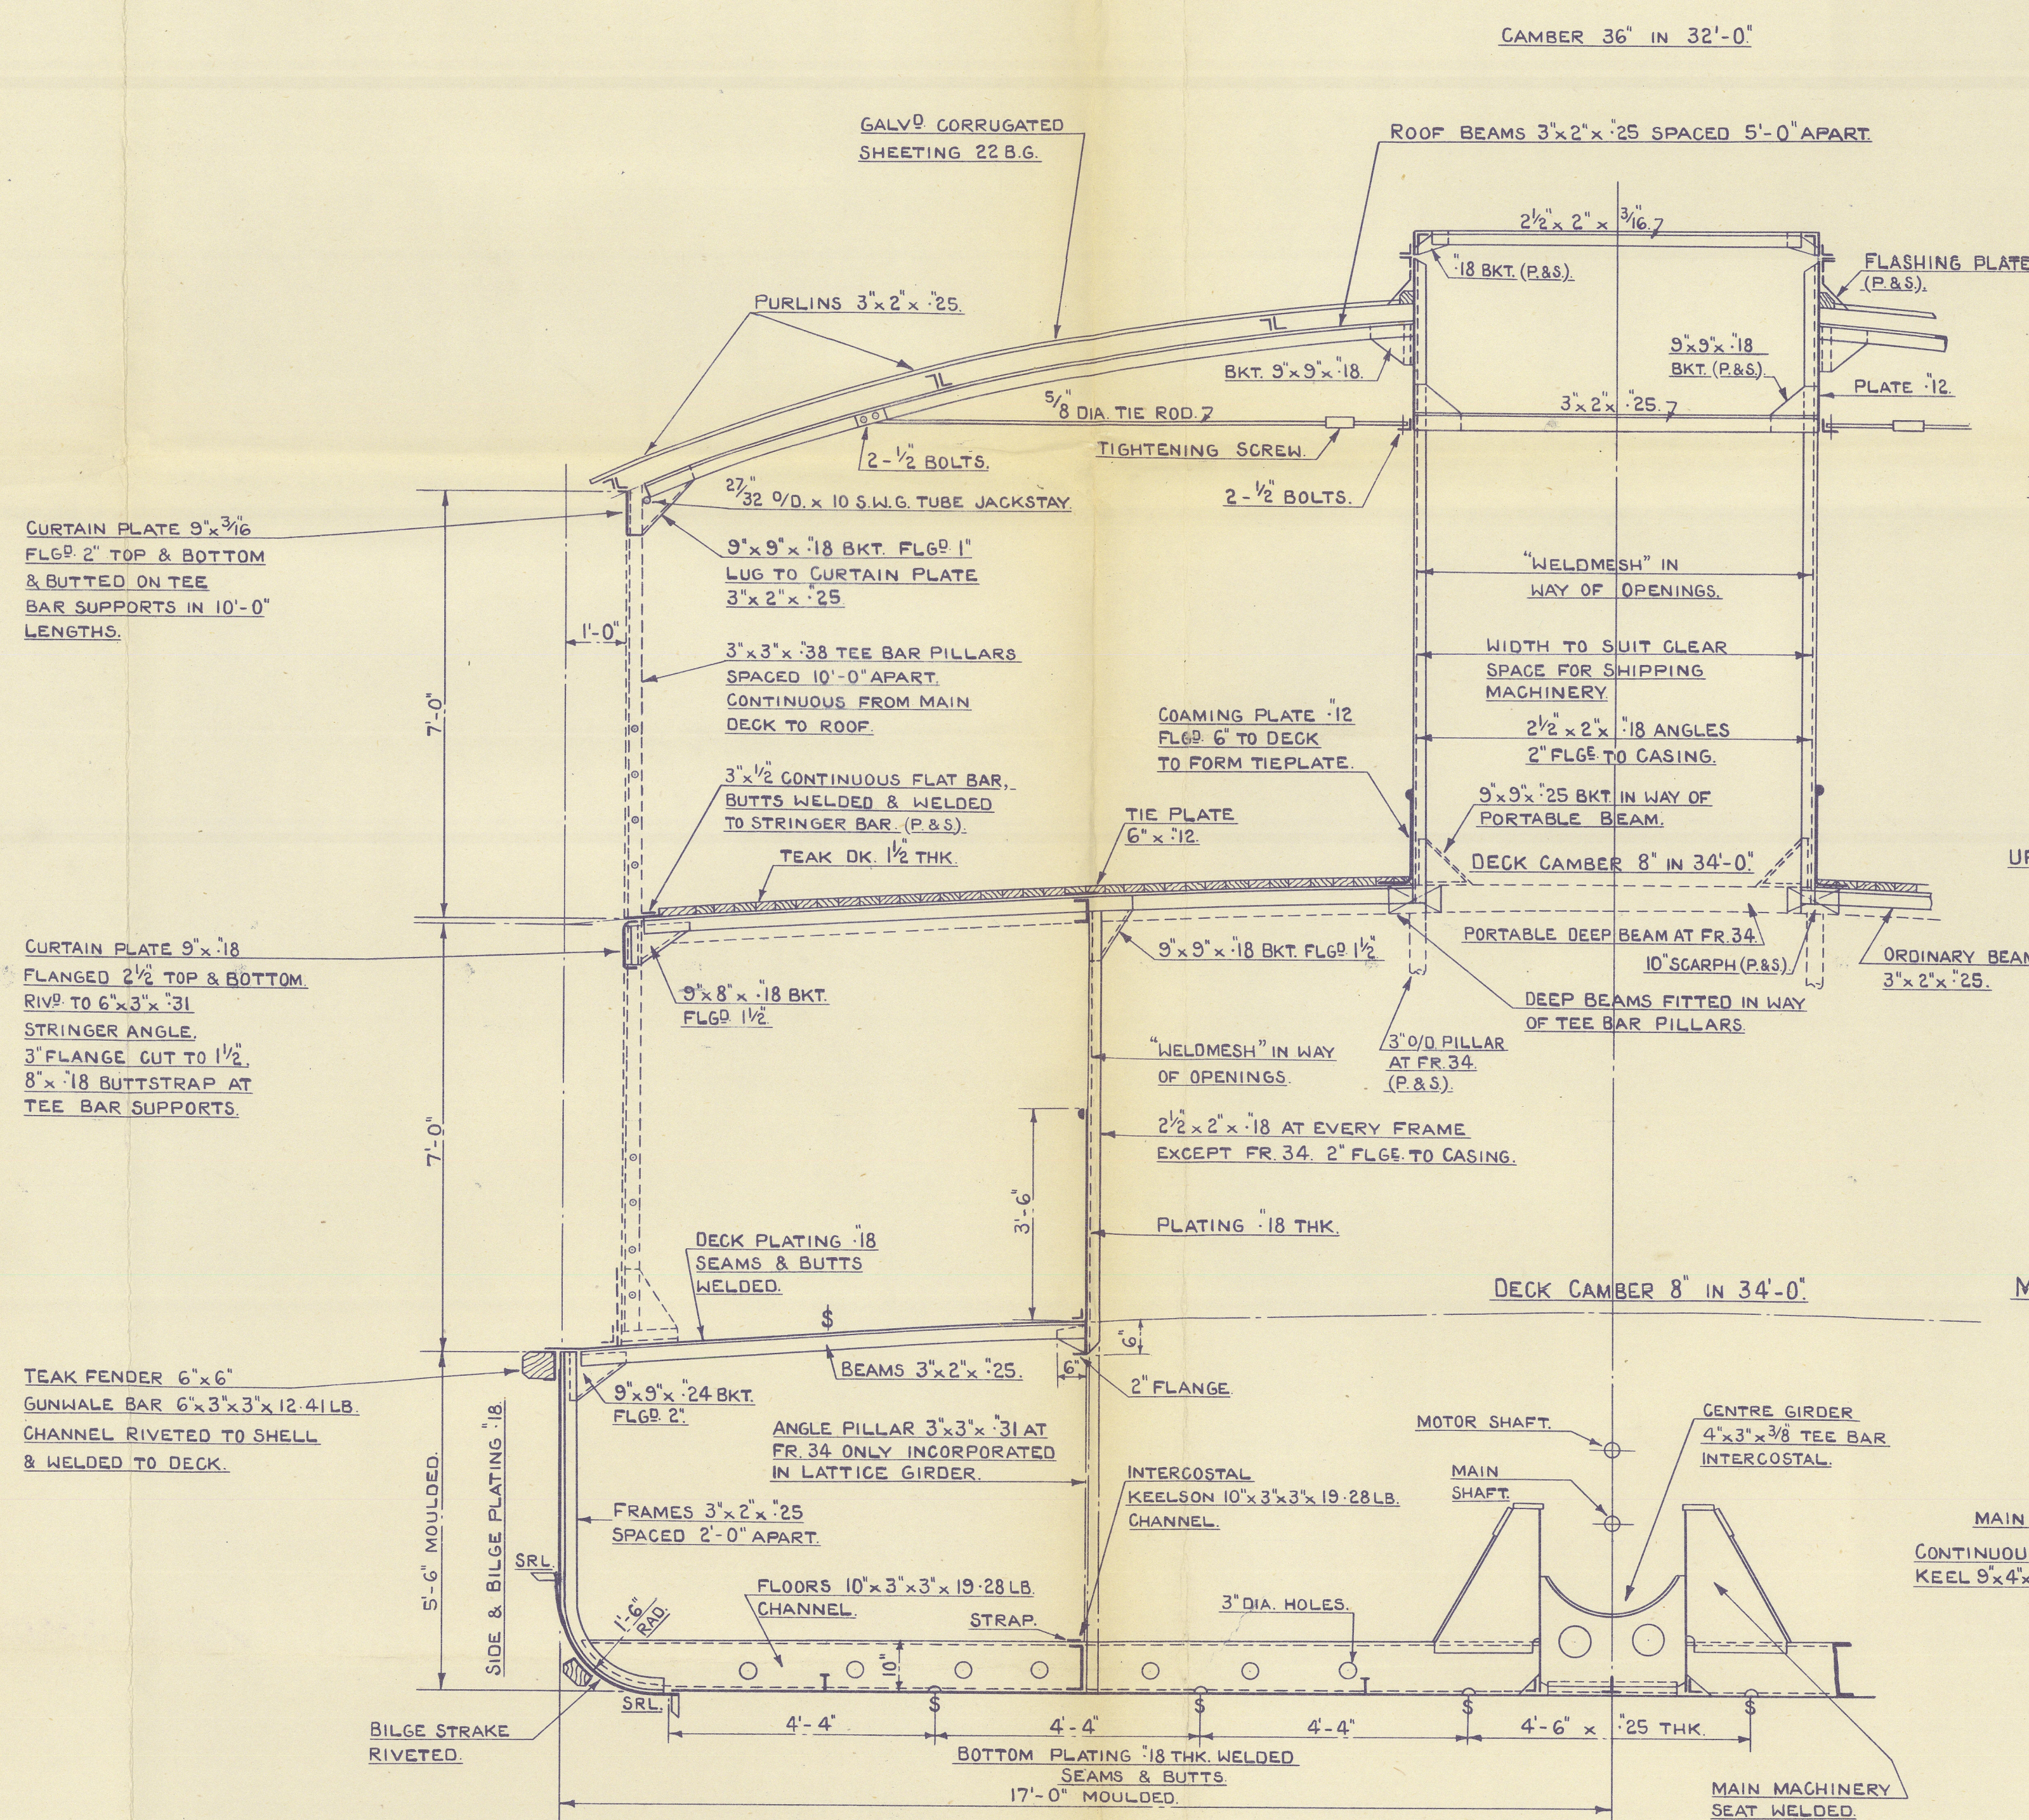

SECTION IN WAY OF MACH'Y SPACE.

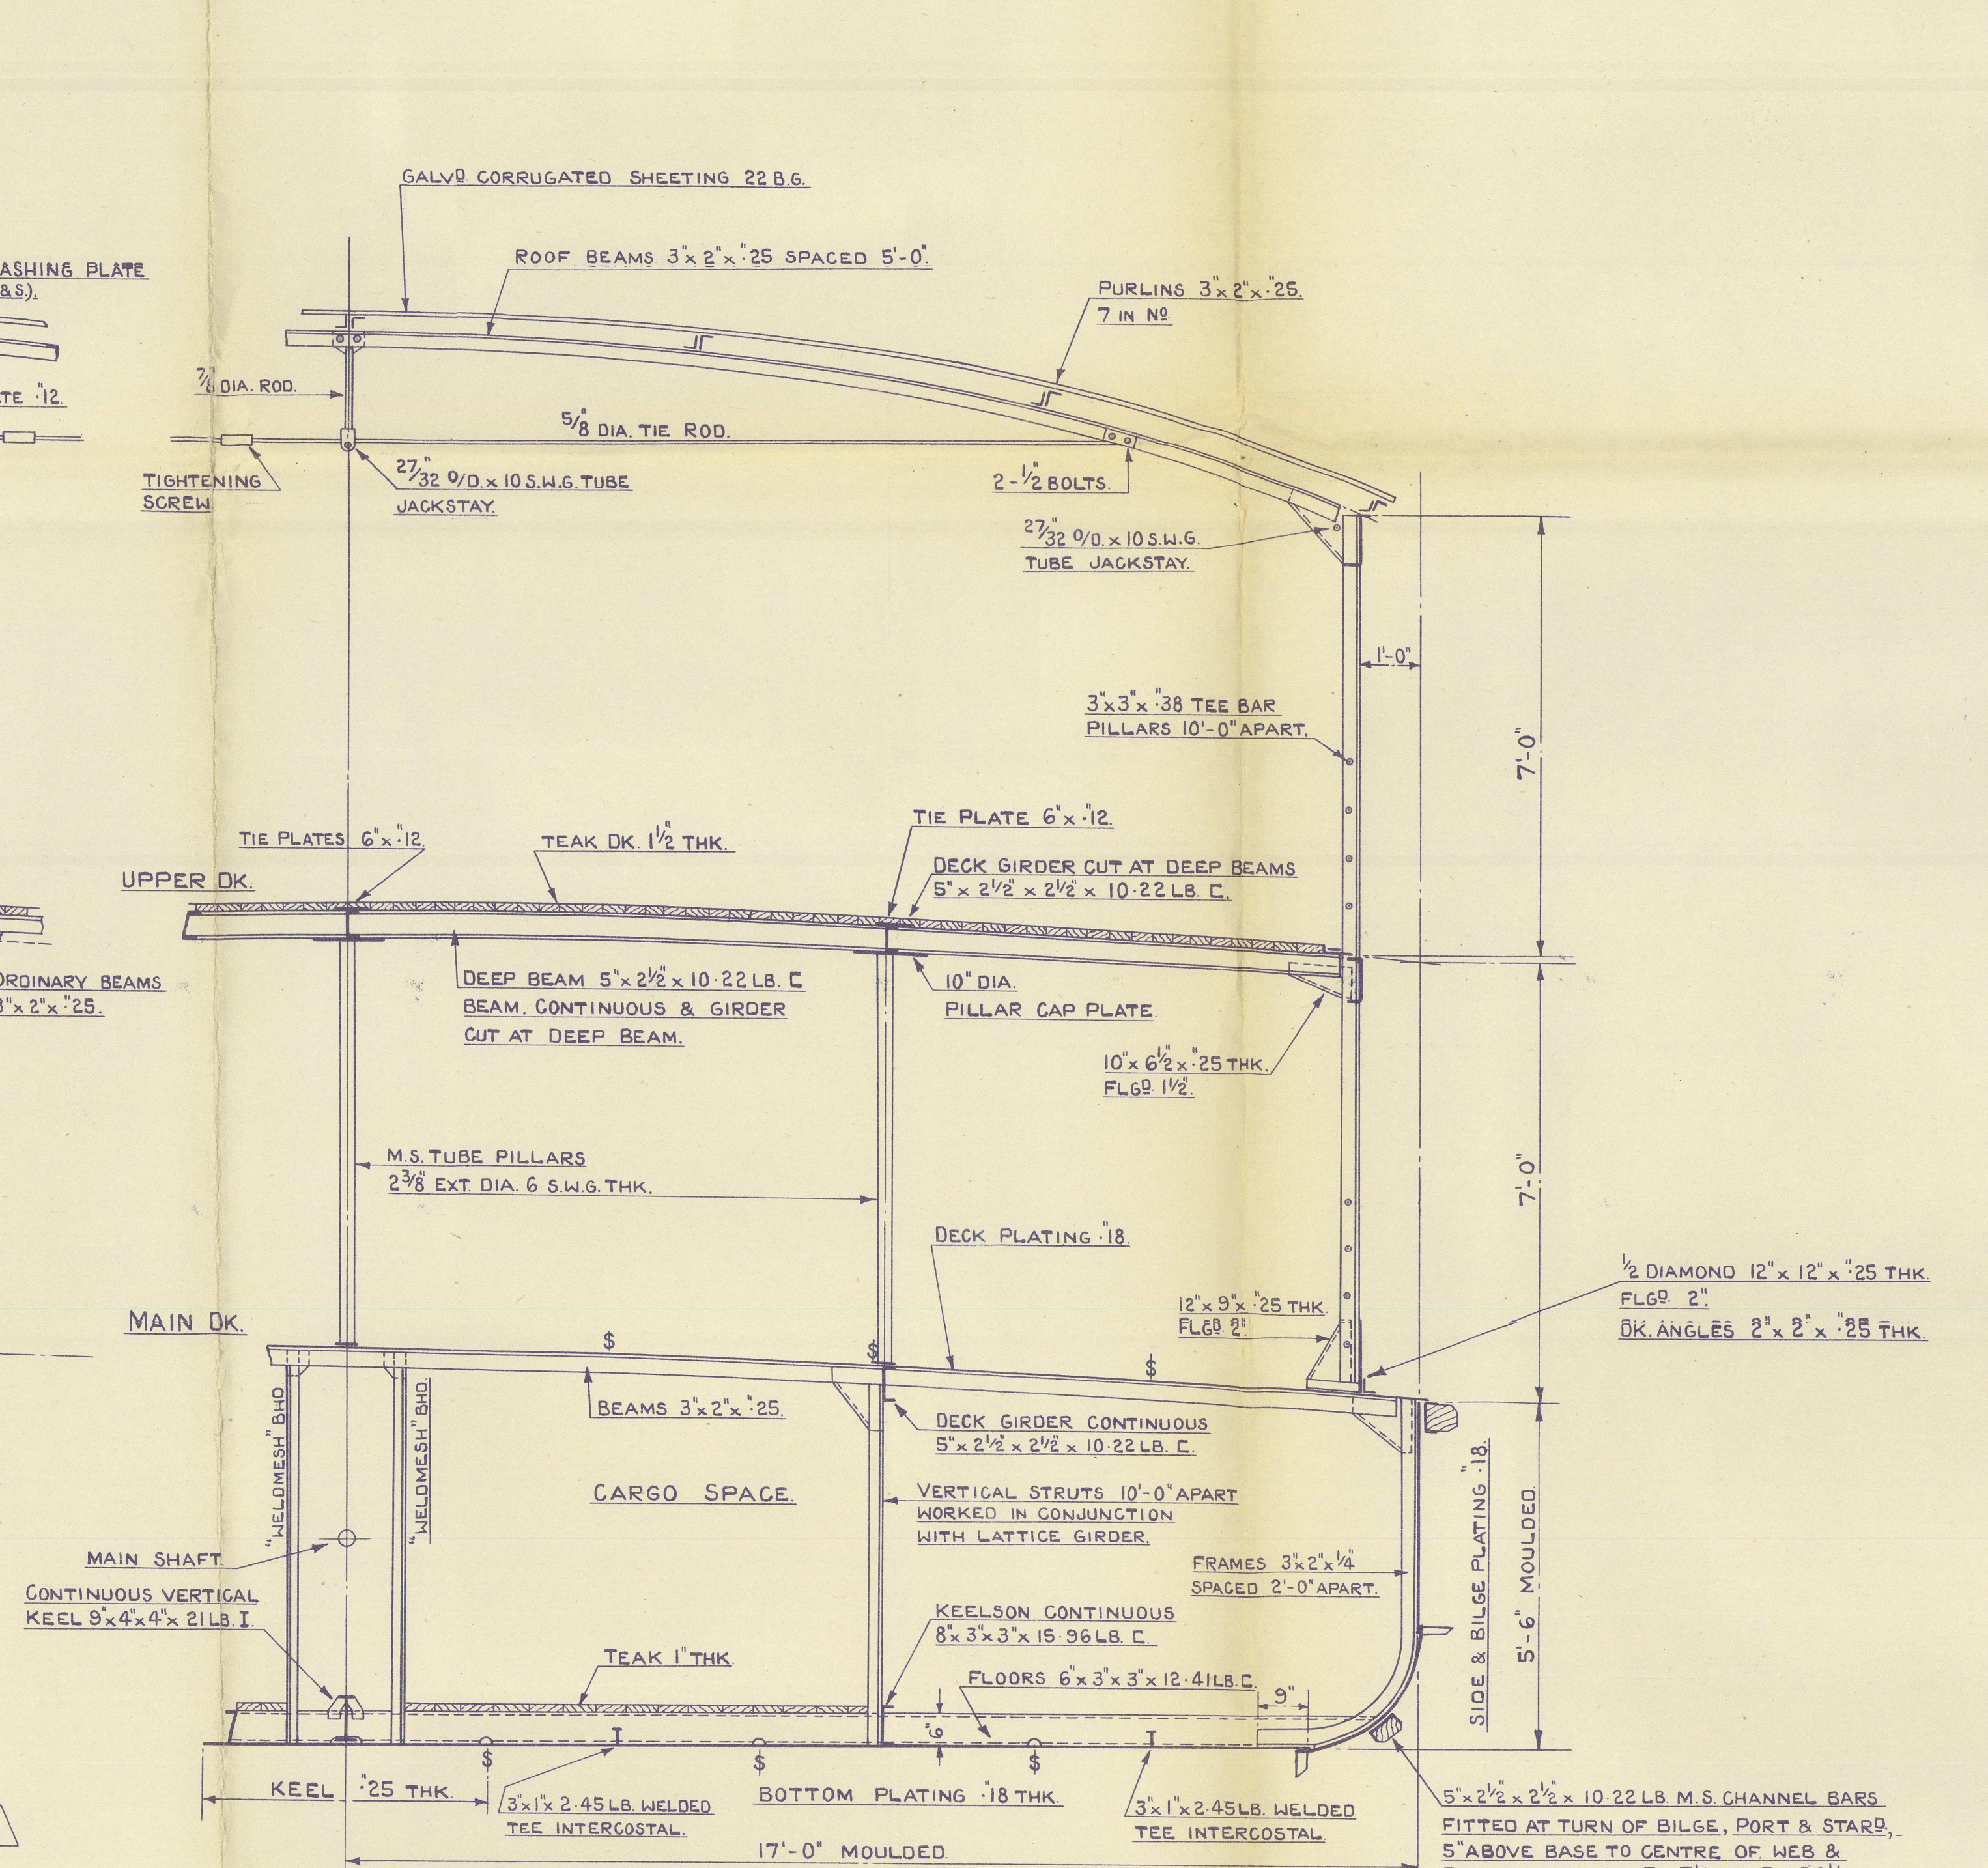


SECTION AFT OF MACH'Y SPACE.

No 40788.

No 40788.

011636-011645-0264

"PONDAUNG" 


GLASGOW REPORT No. 85051

YARROW & Co.

No. 2104

CONSTRUCTIONAL
SECTIONS
(AS FITTED)

RECORDS DEPT.,
LONDON.

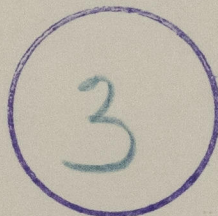

© 2021

Lloyd's Register
Foundation

011636 611645 6264