


M.S. N° 157.
 PROFILE AND DECK PLANS.

SCALE 1/4"=1'

N.Y. BOELEN'S SCHEEPSWERYEN EN MACHINEFABRIEK.
 BOLNES (HOLLAND).

PRINCIPAL DIMENSIONS.

LENGTH BETWEEN PP 120'-0"
 BREADTH MOULDED 24'-0"
 DEPTH MOULDED 9'-0"
 CLASS *BY*

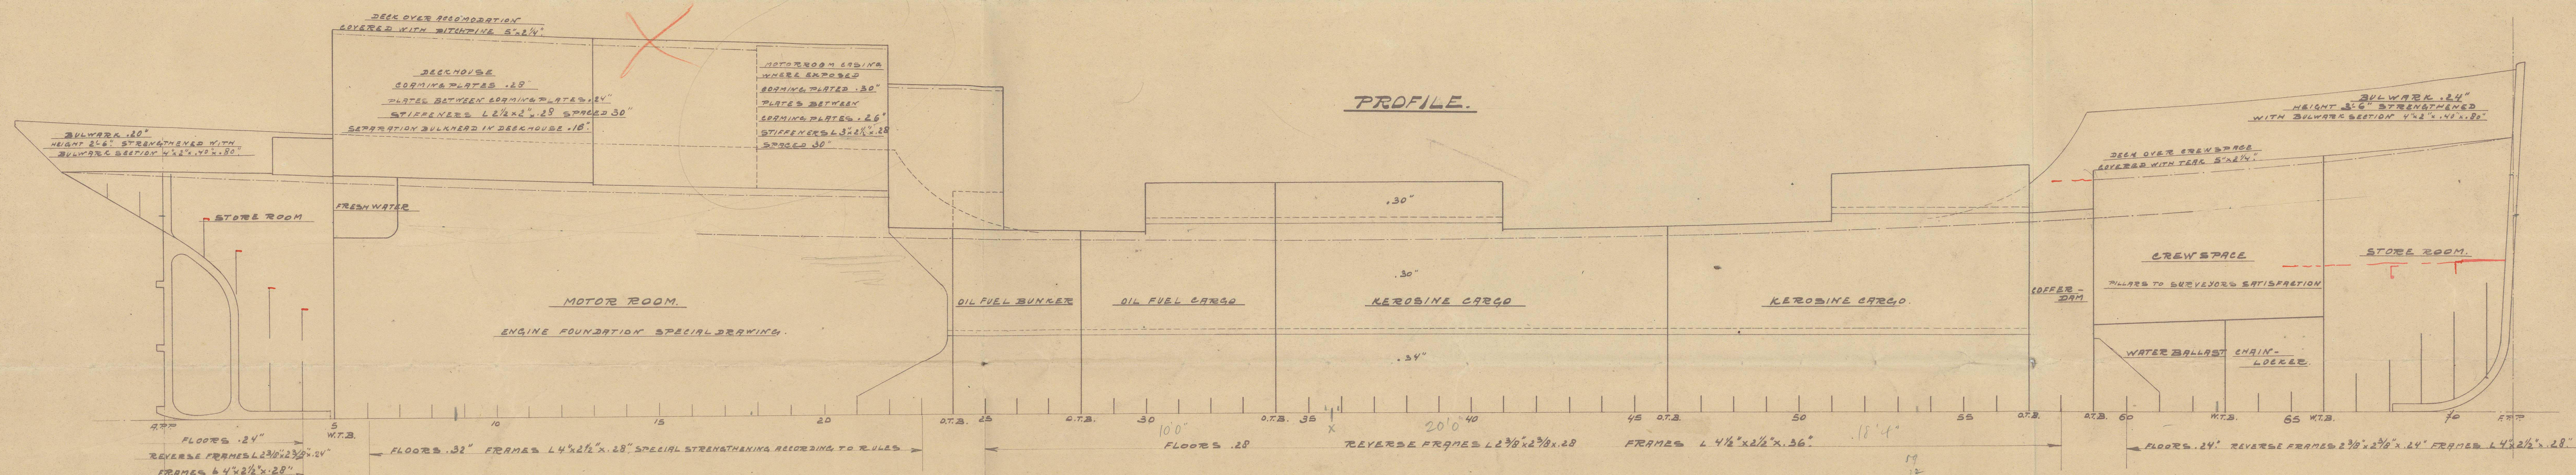


RAISED DECK AFT.

STRENGTHENING AT BEAK OF RAISED DECK
 ACCORDING TO SPECIAL DRAWING

MAIN DECK.

RAISED DECK FORWARD.

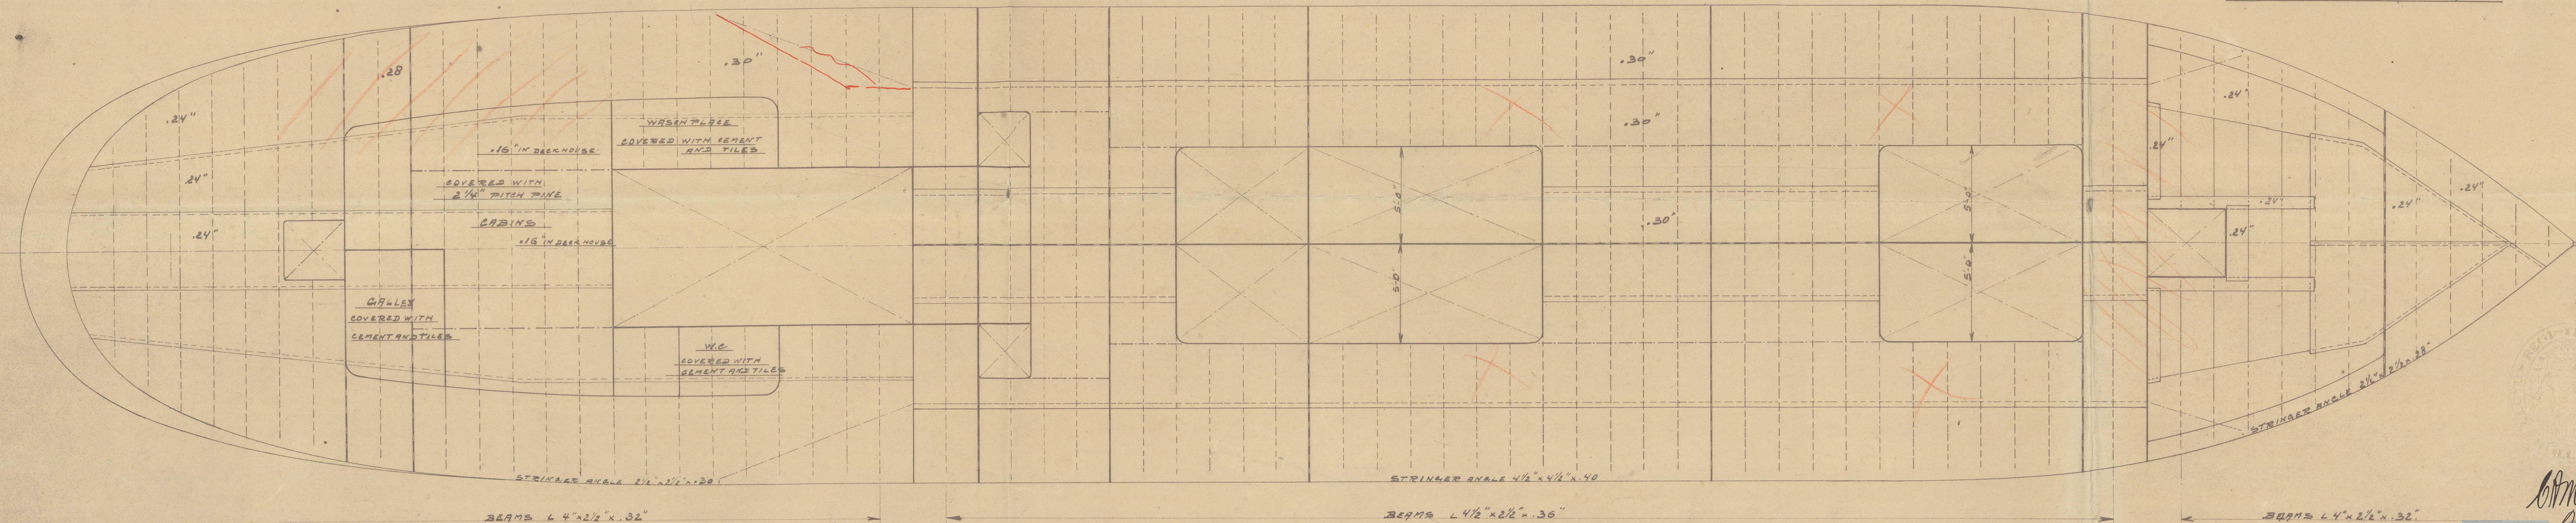

Messrs Bock's Schep & Mach.

Yard No 157

Profile & Decks.

Shaza

Roll. 16309^a



© 2021

Lloyd's Register
Foundation

01646-01656-0266