


off 102

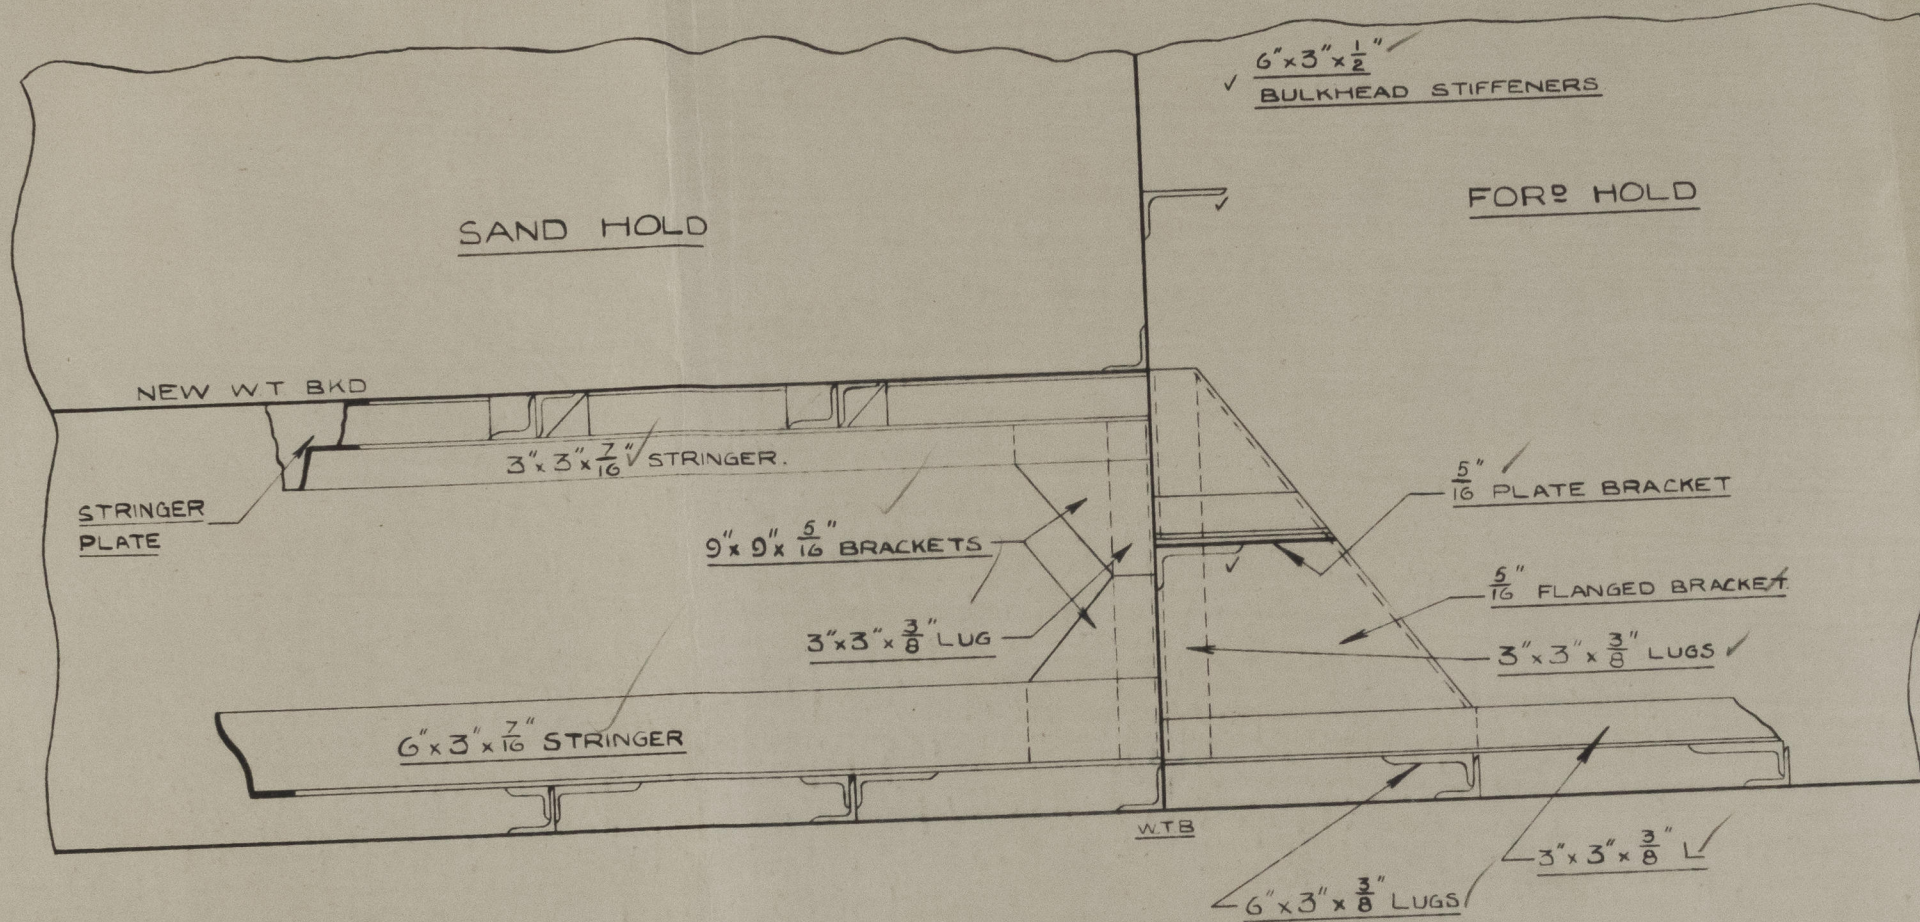

DETAILS OF STRINGER ENDS IN SIDE TANKS  
& COMPENSATING BRACKETS TO BULKHEADS WHERE STIFFENER'S  
BROKEN IN WAY OF W/T MANHOLES.

SCALE:- 1" TO 1'-0"

AM  
9.7.47

RISDON BEAZLEY LTD.,  
NORTHAM BRIDGE,  
SOUTHAMPTON

FLY TO DRW R50/P202