



# Lloyd's Register of Shipping.

Ship's Name "SAND SKIPPER"

Official No. 169092.

Memorandum of alterations reported since ship was surveyed for assignment of Load Lines in .....

ALTERATIONS CARRIED OUT AT SOUTHAMPTON. SEPTEMBER, 1947.

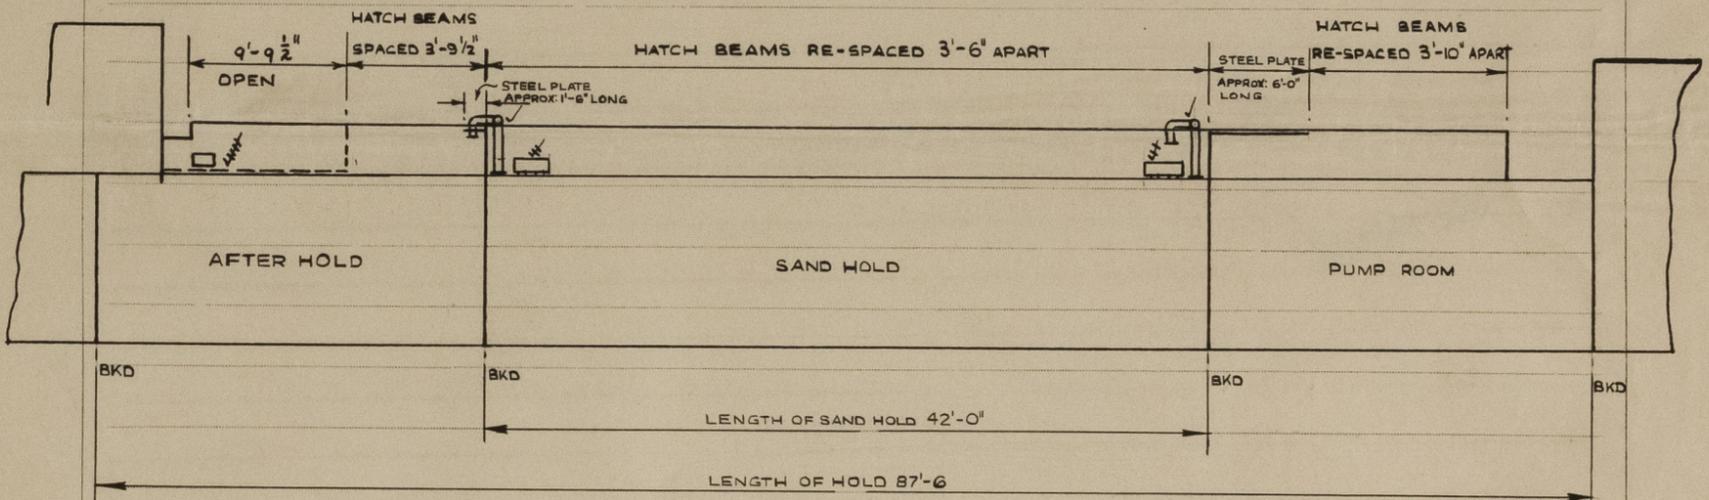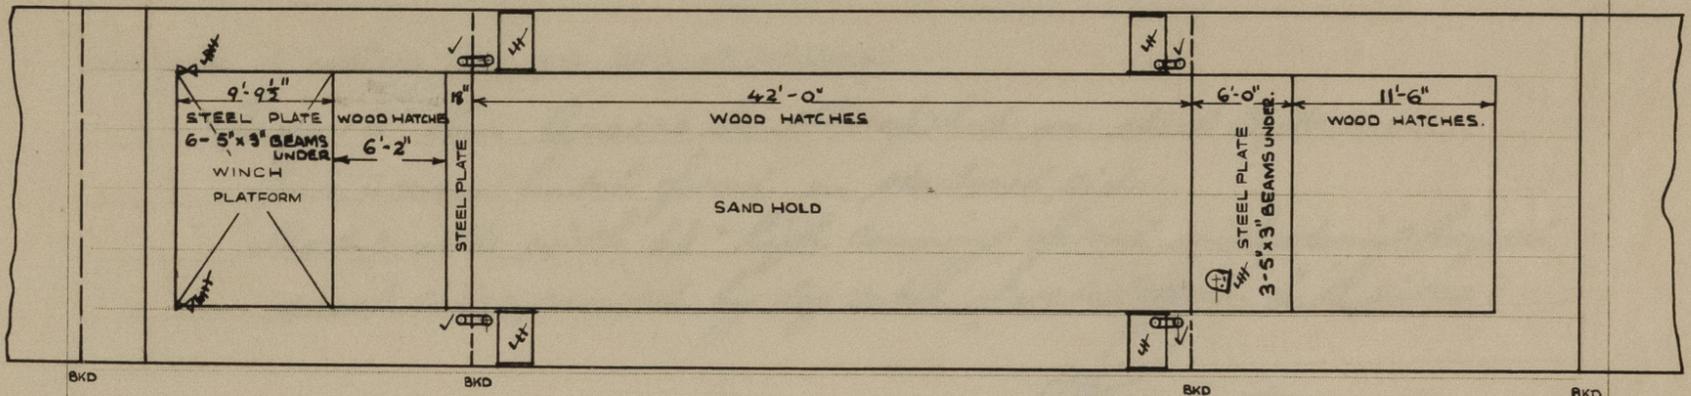

WIL-D

- ✓ 4 AIR PIPES 3" DIA x 36" HIGH FITTED WITH WOOD PLUG.
- W 1 VENT 12" DIA x 0-25" COAMING 2'-3 1/2" ABOVE WOOD HATCH FITTED WITH WOOD PLUG & CANVAS COVER.
- W 4 OVERBOARD SLUICES 2'-0" x 10" SECTION.
- W FREEING PORTS 15" x 8" PORT + STARD

*Edwards*  
26/9/47.

Noted. *[Signature]*  
30 SEP 1947

COPY OF THIS REPORT PLACED ON BOARD



© 2021

Lloyd's Register Foundation