

3-FEB 1956

Rpt. C. 11 (Contd.)

Index No.

LLOYD'S REGISTER OF SHIPPING


UNITED WITH THE BRITISH CORPORATION REGISTER

Ship's Name M/T "P O R J U S" of Rönning.

Official No. ---

Memorandum of alterations reported since ship was surveyed for assignment of Load Lines in

Gangway fitted on trunk top as per sketch.

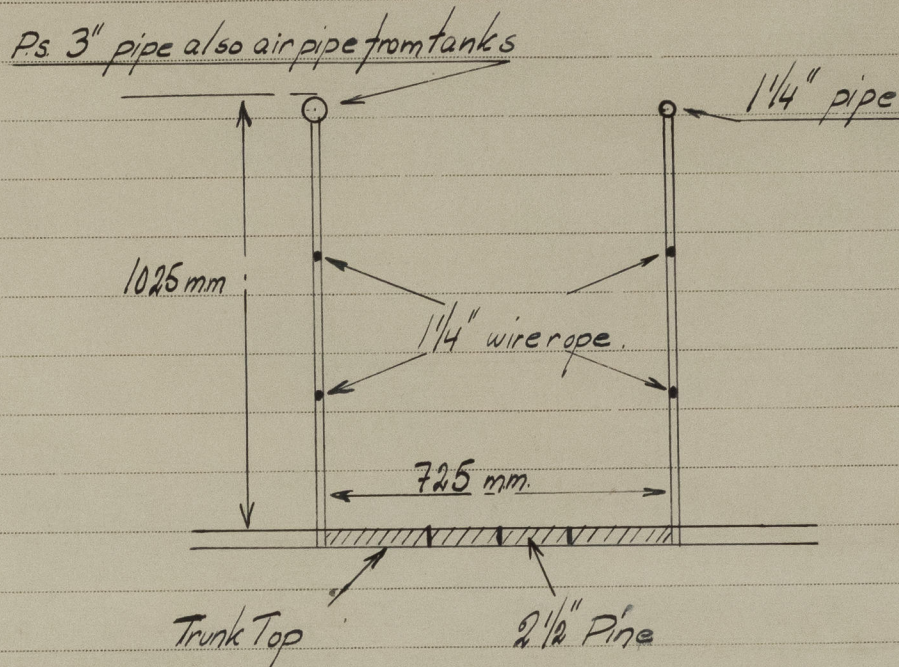

Stanchions 2" pipe spaced 1950 mm.

Malmö, 2nd February, 1956.

Stig Knänsjö

Surveyor to Lloyd's Register.

Notes. *See 2*

9 FEB 1956