



ALTERATIONS & ADDITIONS TO S.T. FLYING KESTREL

SCALE $\frac{1}{4}$ " = 1 FOOT

additions made in red

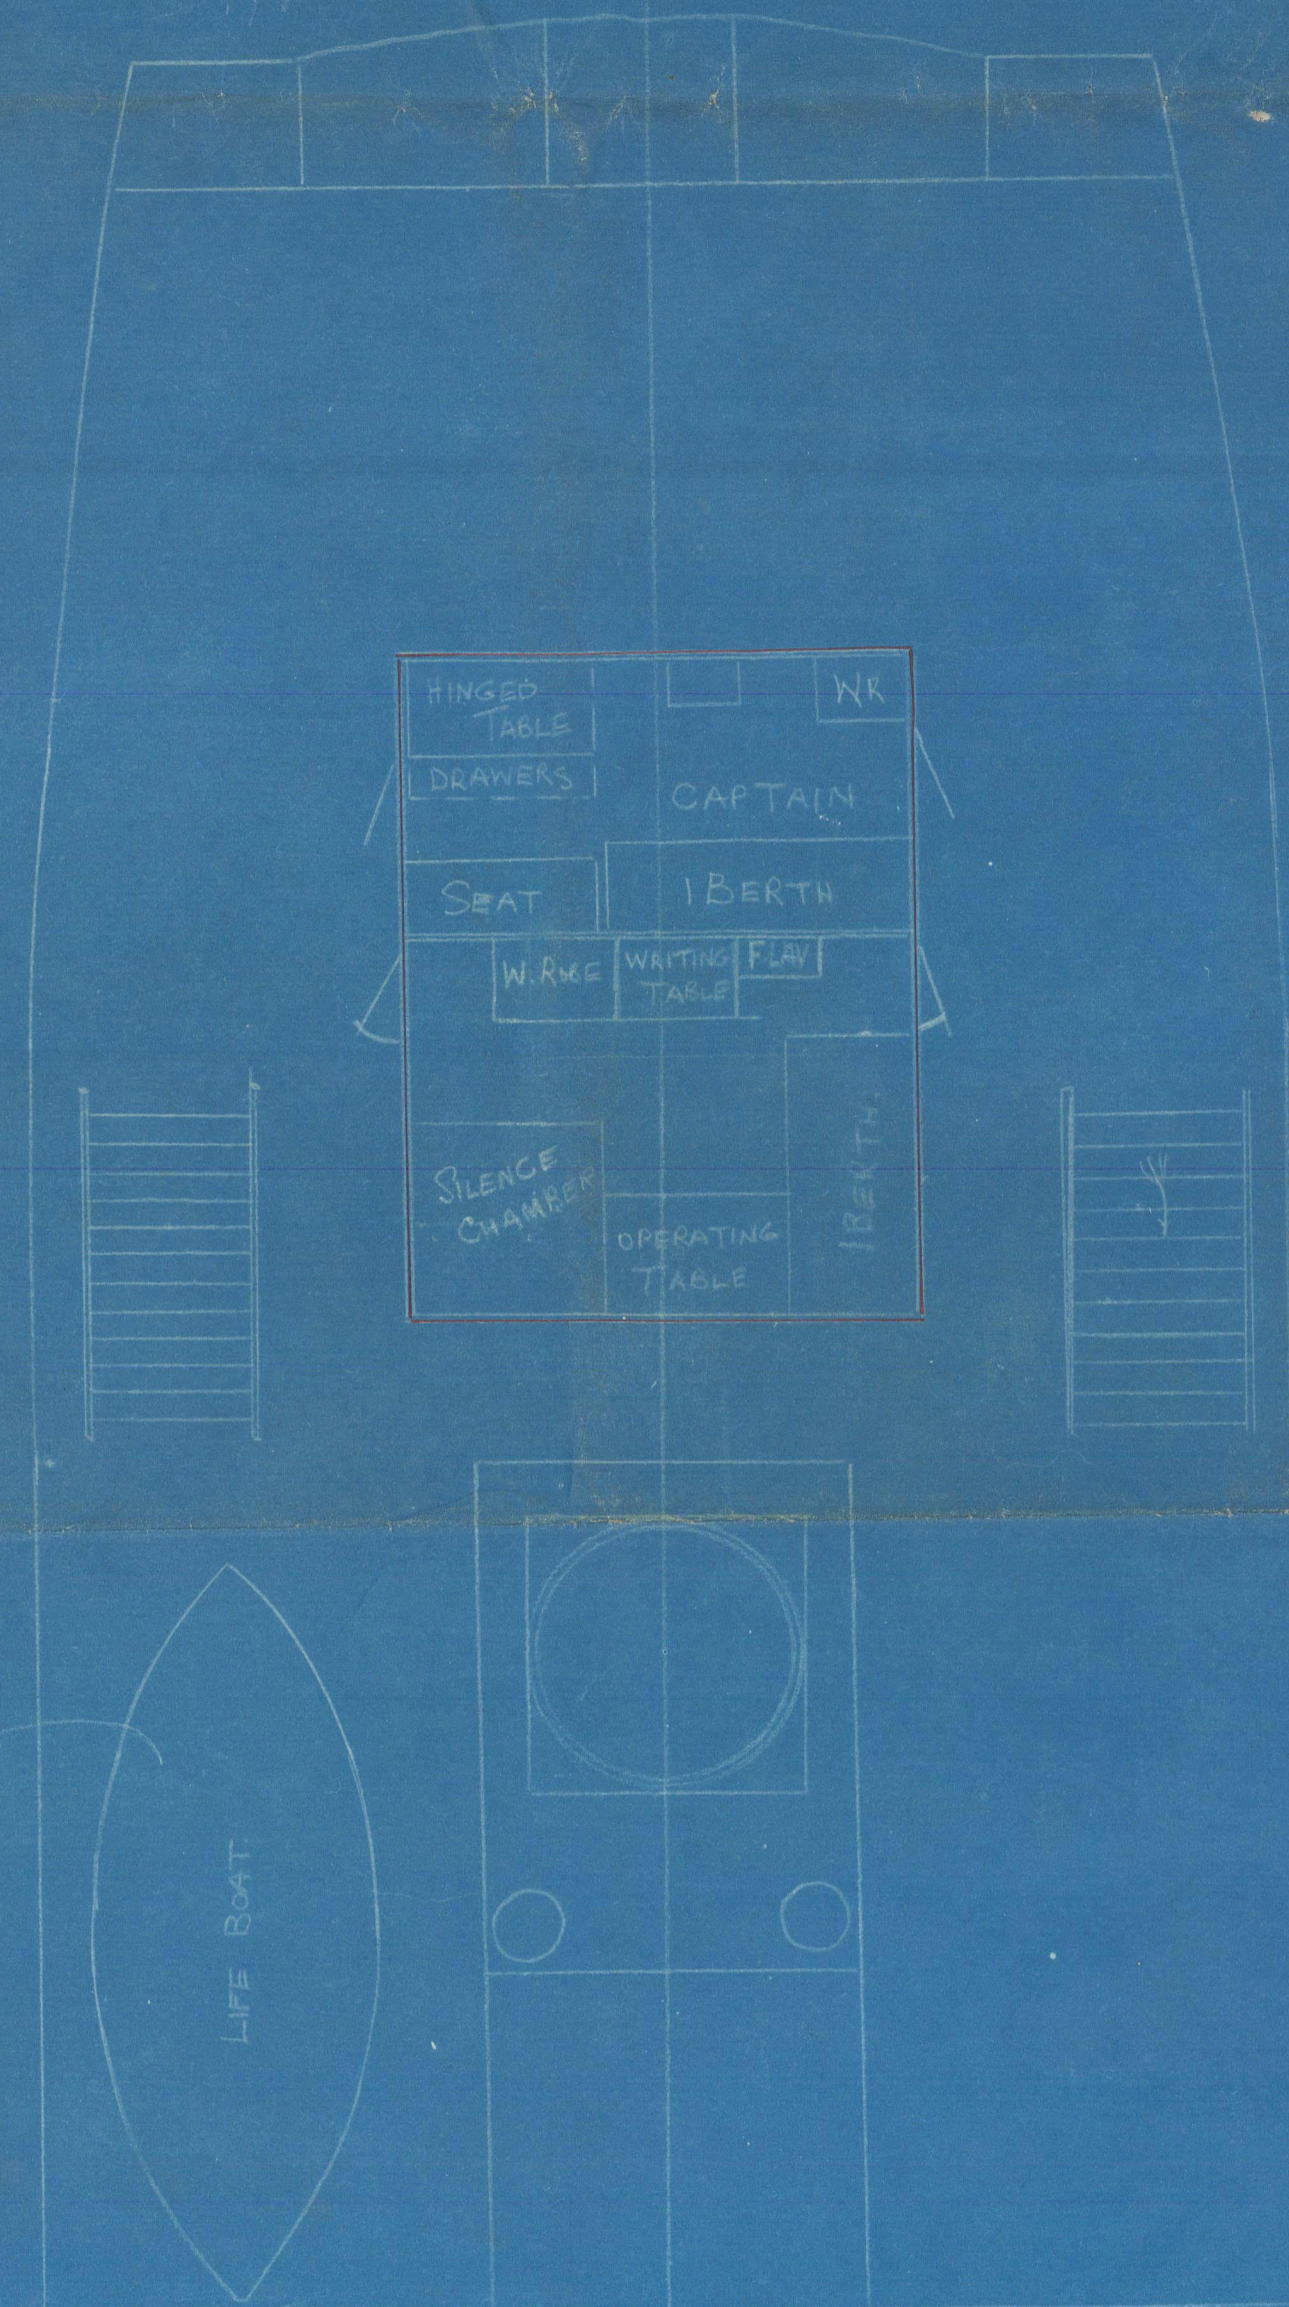

PLAN OF BRIDGE DECK

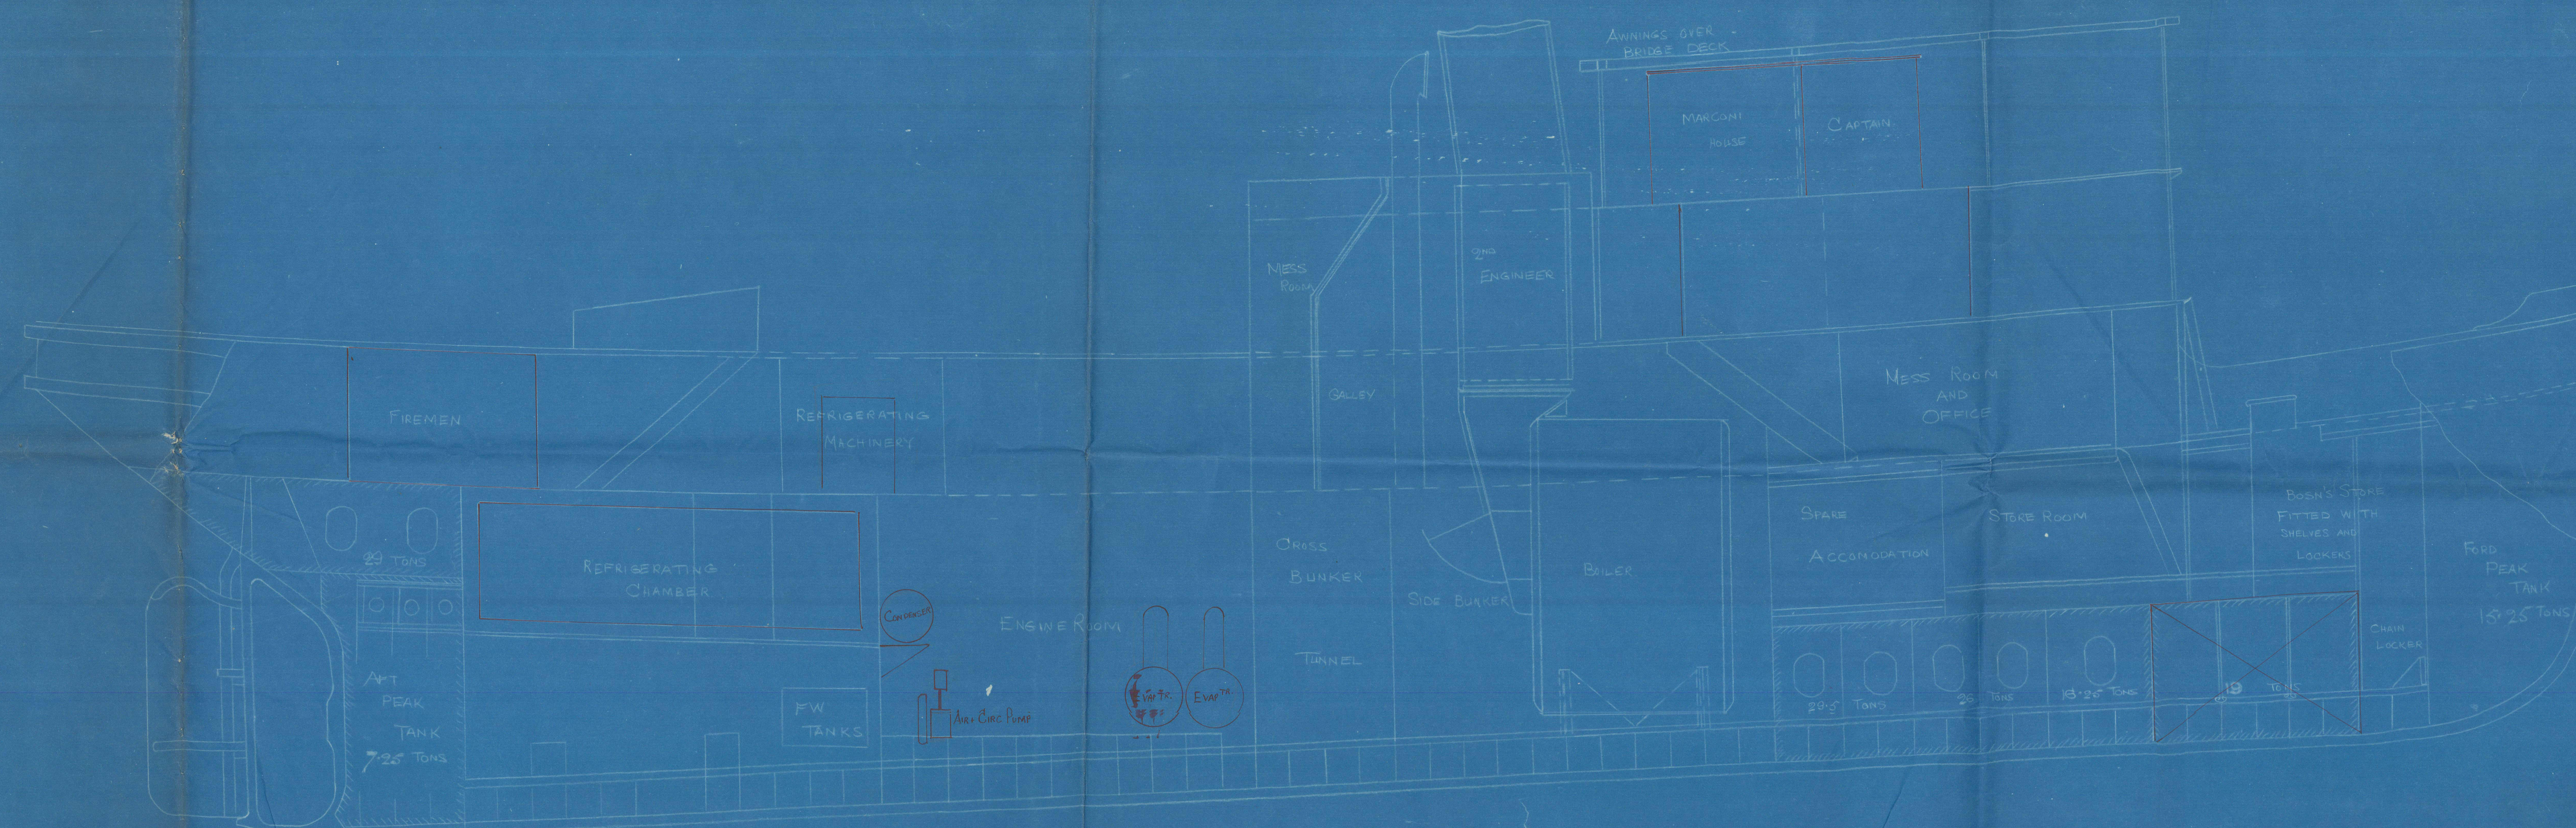

PLAN OF LOWER DECK BETWEEN
FRAMES 44 TO 33

