


DIMENSIONS :- 230'-0" B.P. ✓ • 35'-0" B.MLD • 13'-3" D.MLD. TO FREEBOARD DECK ✓
• 20'-9" D.MLD. TO STRENGTH DECK ✓

SCALE $\frac{1}{8}" = 1$ FOOT.

PILLARS UNDER WINDLASS & CRANES ETC ✓
To SURVEYORS SATISFACTION ✓

FORE PEAK STIFFENING.
WITHOUT PANTING STRINGERS OR
SHELL ATTACHMENT

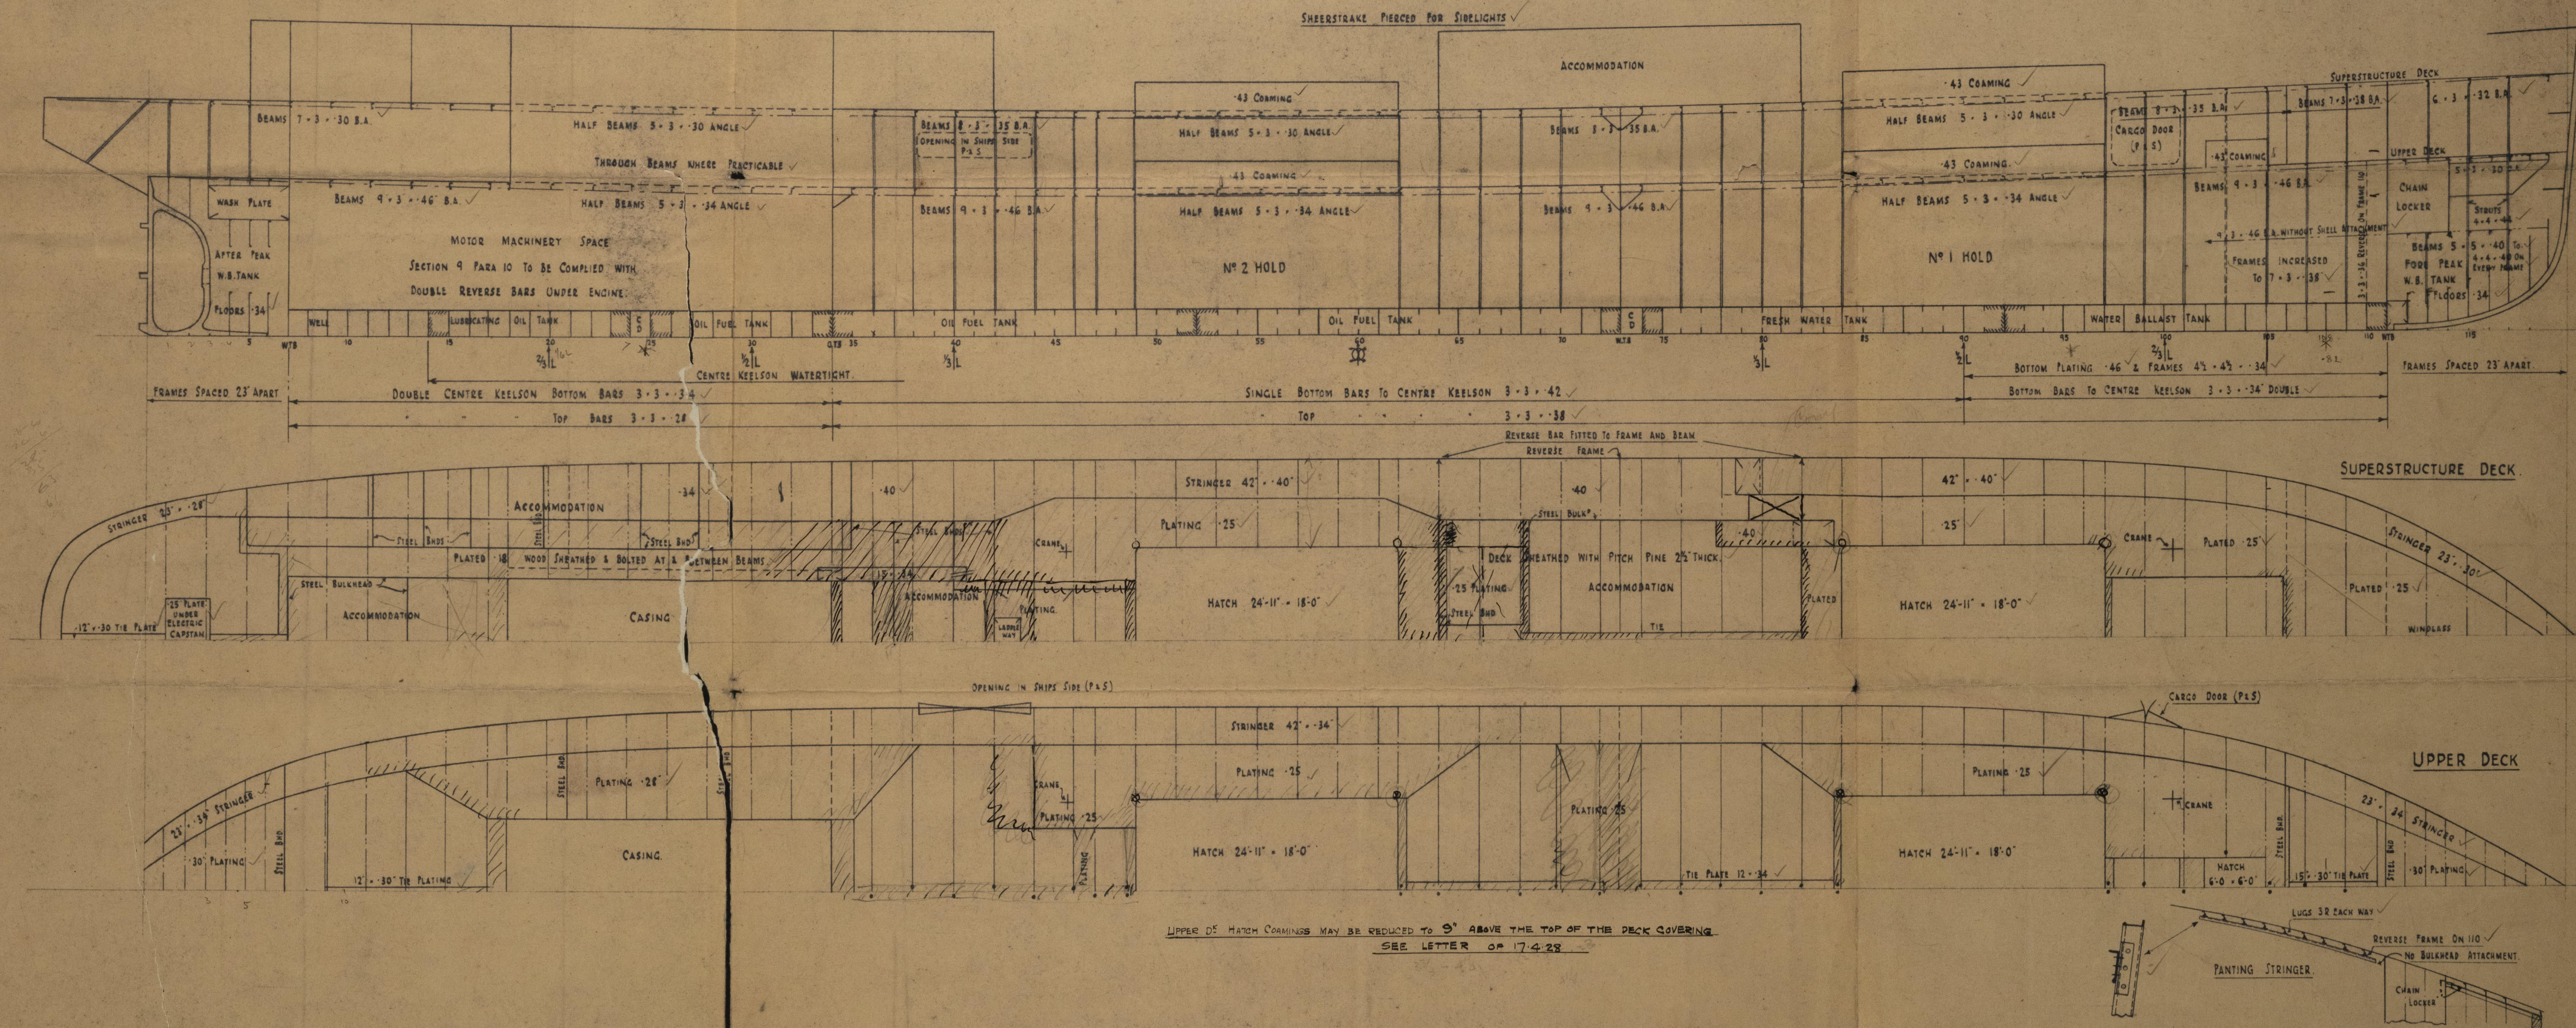

12

$1.91 \times 11.5^2 \times 8 \times 61 = 20$

$$\begin{array}{r} 15.2 \quad 15.7 \\ 13.2 \\ \hline 2 \end{array}$$

UPPER DE HATCH COAMINGS MAY BE REDUCED TO 9" ABOVE THE TOP OF THE DECK COVERING
SEE LETTER OF 17-4-28

1-01167-

© 2021
Lloyd's Register
7-0219
Foundation

H.

And. Profile & Decks.

R. W. Hawthorn, Leslie. Co.

Nº 560.

Y. b. 6-3-29.

6-2-29.

M. J. Ol. Hak.



© 2021

Lloyd's Register
Foundation

011671-011677-0219



2448 x 490 x
~~2448~~
28.

Bray

