


5/8 MODUM. PROFILE AND DECK PLAN.

DIMENSIONS - 355'-0" BP X 51'-0" BT X 27'-4" MD


SCALE 1/8" = 1' 00"

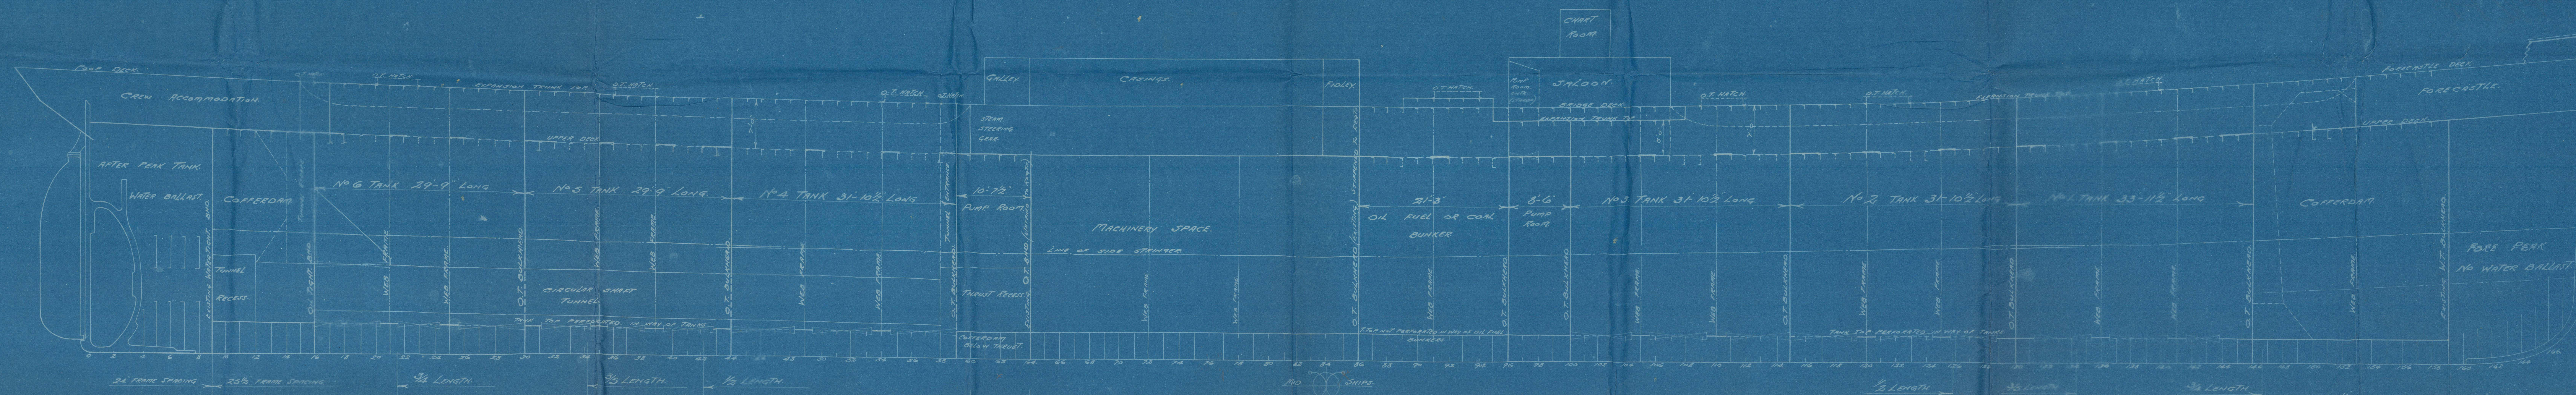


PLAN AT UPPER DECK.



ERECTOR'S.

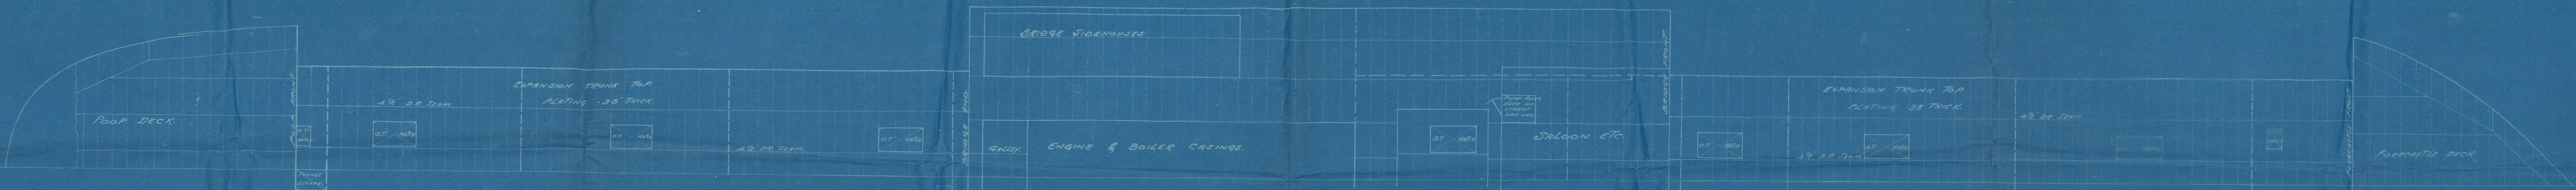

PLAN THRO' OIL TANKS ETC.

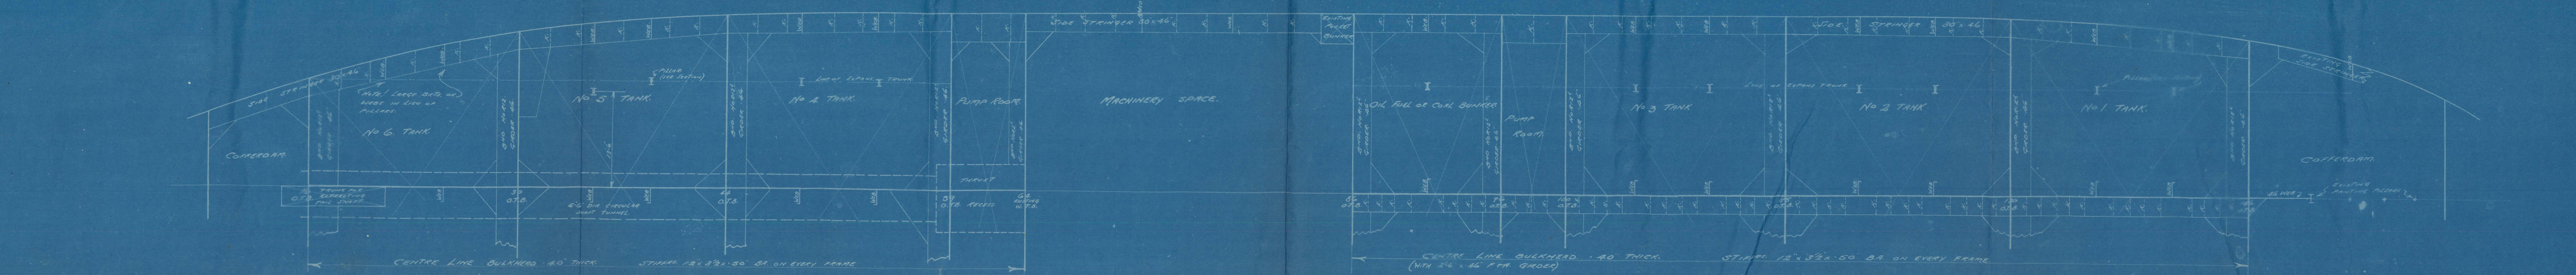

S.S. Modum

Profile (as fitted & conversion
for Oil in Bulk.)

Messrs Northumbrian Shipbuilding Co
8/5 242

S.S. MODUM.

NEWCASTLE ON TYNE.

Report No. 44441

© 2021
011678-011692-0103

Lloyd's Register
Foundation