

GENERAL ARRANGEMENT.

150 TON TANK SWIM BARGE.

SHIP Nos. 2098/100.

DIMENSIONS.

LENGTH OVERALL. 85'-0"

BREADTH MLD. (3RD FR. IN HOLD) DECK FWD. 23'-6"

" " (" " " ") " AFT. 23' - 3"

" " (" " " ") BOTTOM FWD. 19' - 6"

_____ (_____) _____ AFT. 18' - 0"

DEPTH MLD. (AMIDSHIPS). 8' - 0"

SCALE:- $\frac{1}{2}" = 1$ FOOT.

- EQUIPMENT -

- EQUIPMENT -
ONE 2 CWT BARGE TYPE STOCK ANCHOR.
43 FATHOMS - 1/2" SHORT LINK CABLE IN 15 FATHOM LENGTHS
WITH JOINTING SHACKLE AND ONE END SHACKLE
TWO HEADCASTS OF 1/8" DIA SHORT LINK CHAIN EACH 6'-0"
LONG WITH PEAR SHAPED LINK AT OUTER END
TWO SOFT 3/4" DIA SHORT LINK MOORING CHAINS WITH PEAR SHAPED LINK
AT OUTER END & LONG LINK & DIA 1/2" END ANCHOR END



NOTE: CABLE LOCKER TO BE
AND FITTED BY OTHER

44 45 46 47 48 49 50 51

18" 18" 18" 18"

14' 7"









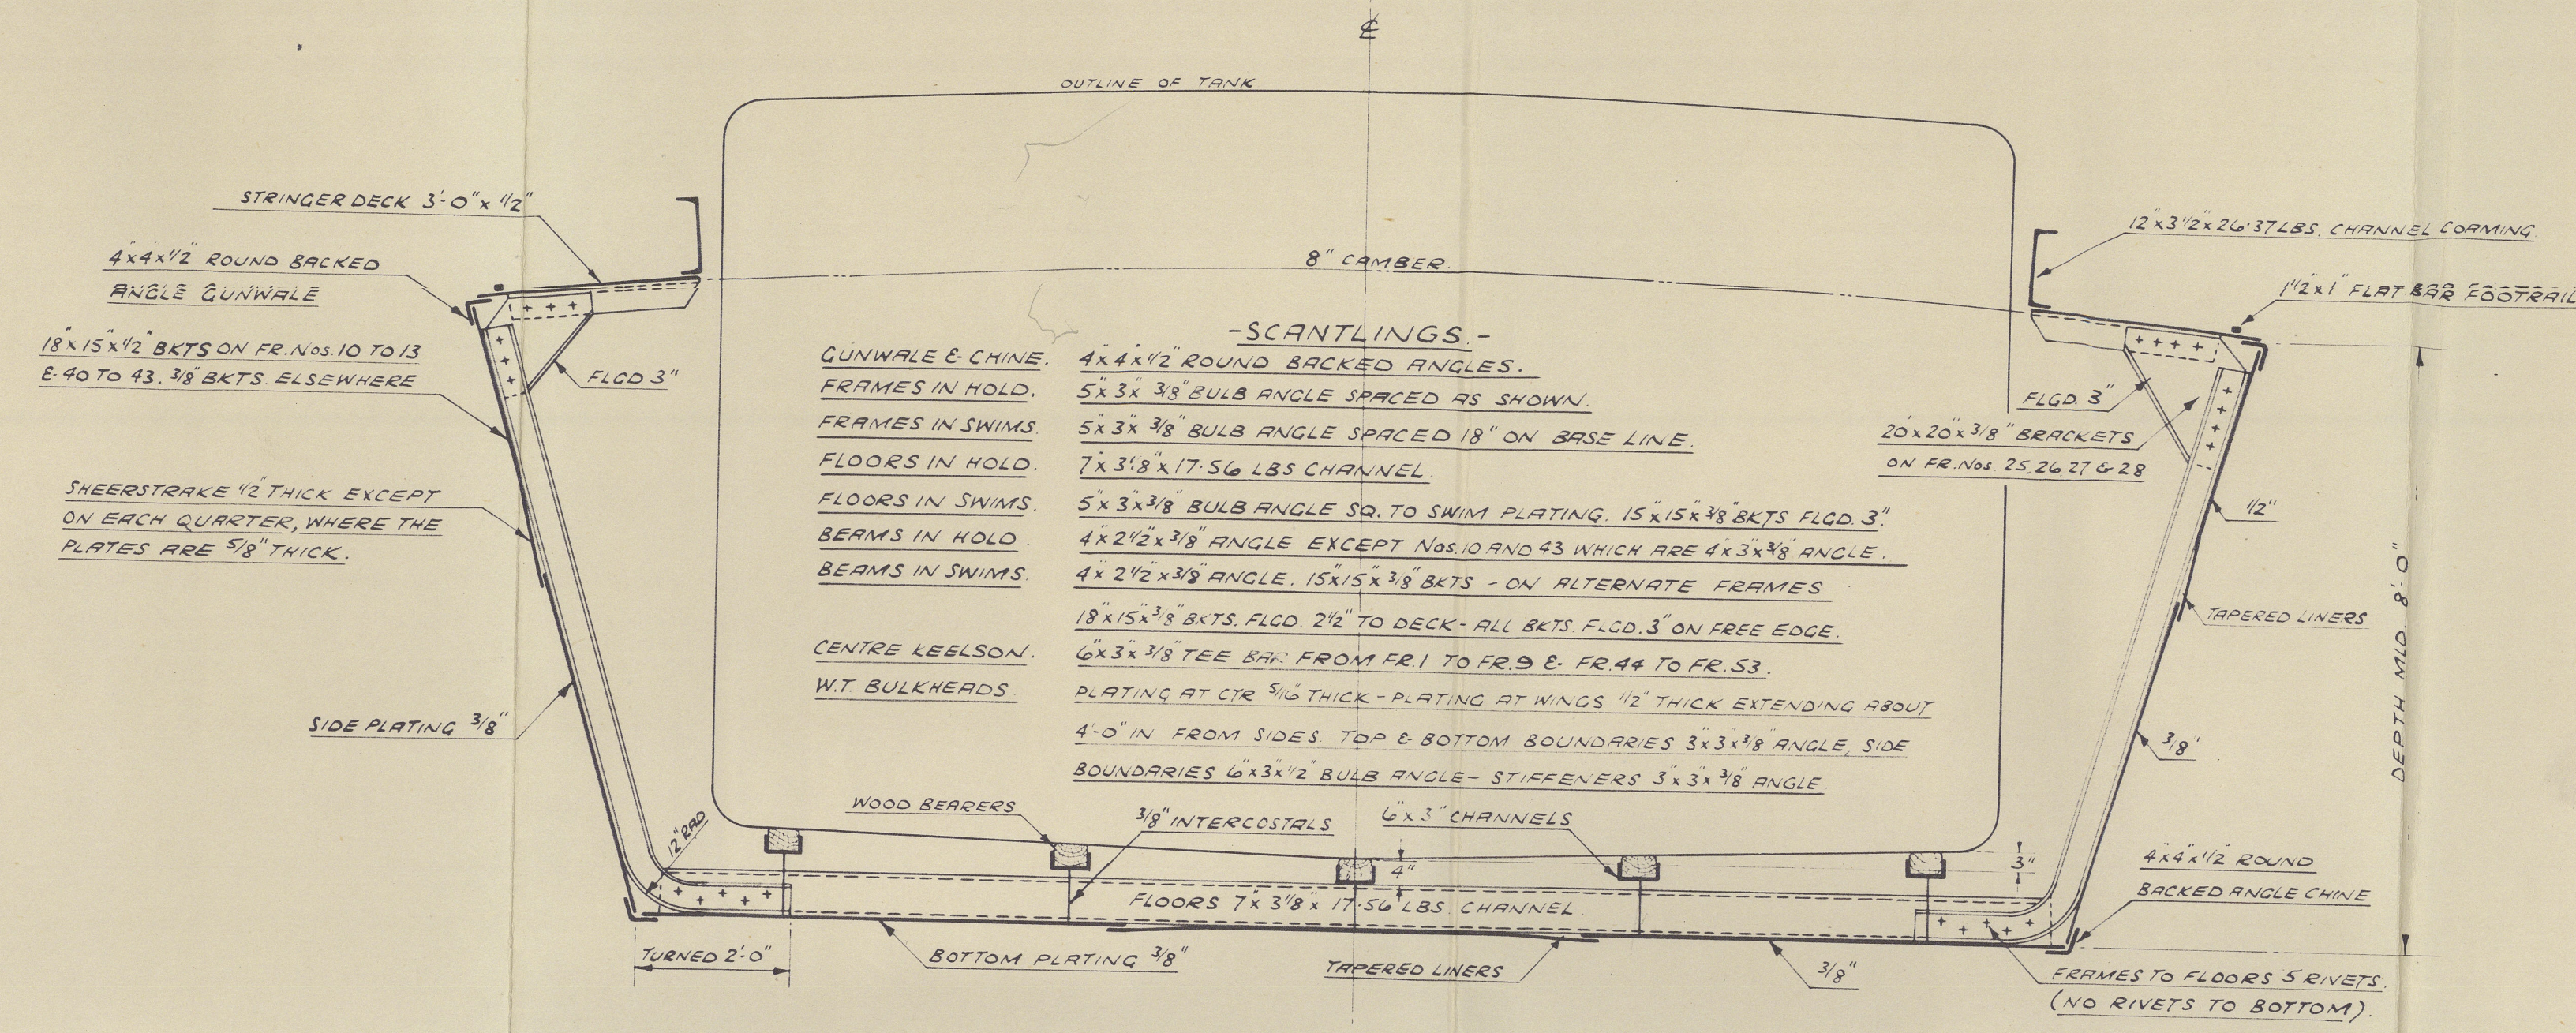

MIDSHIP SECTION.

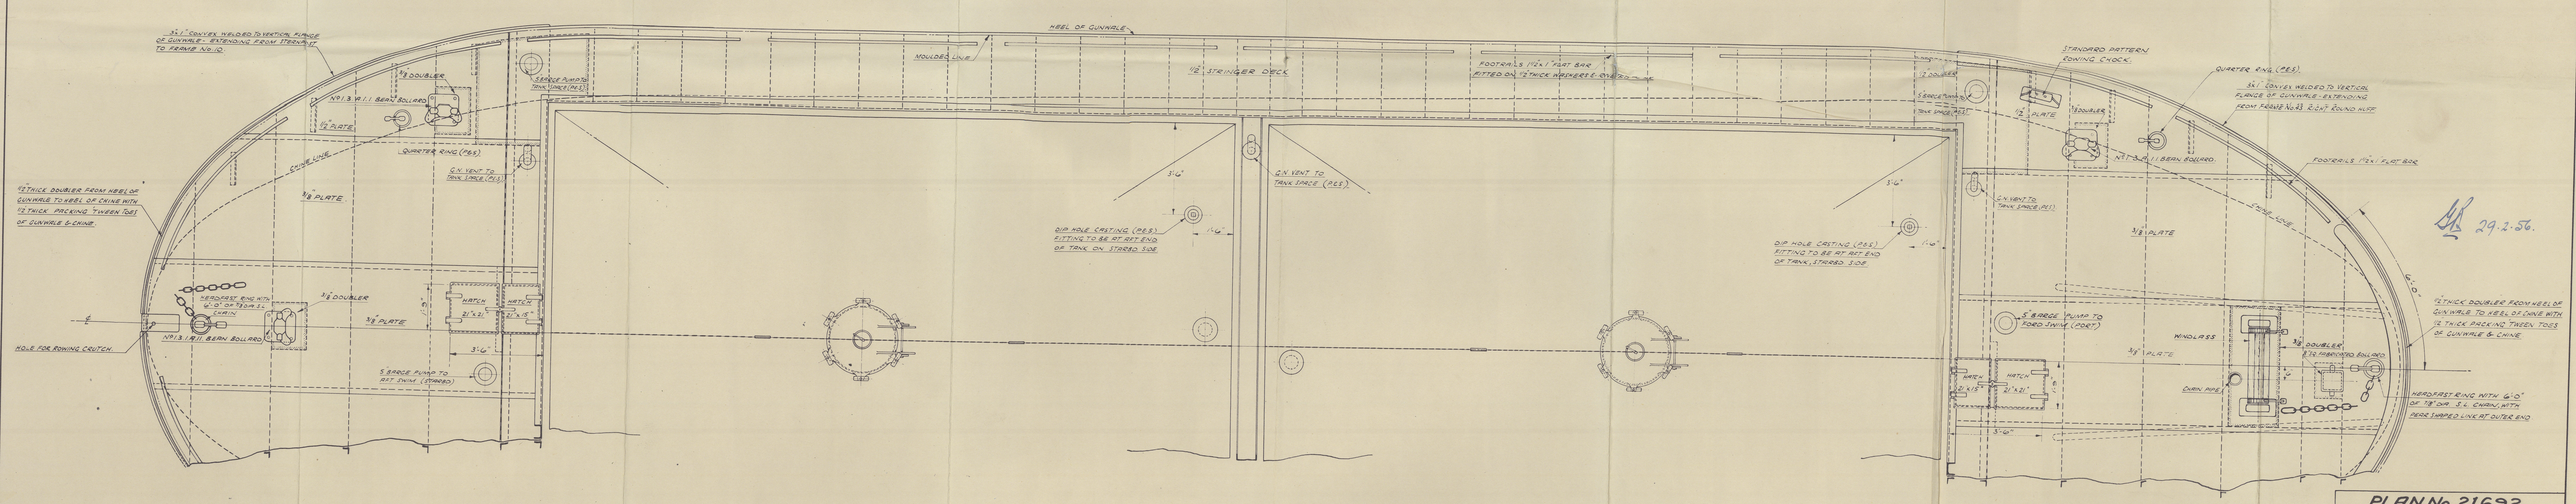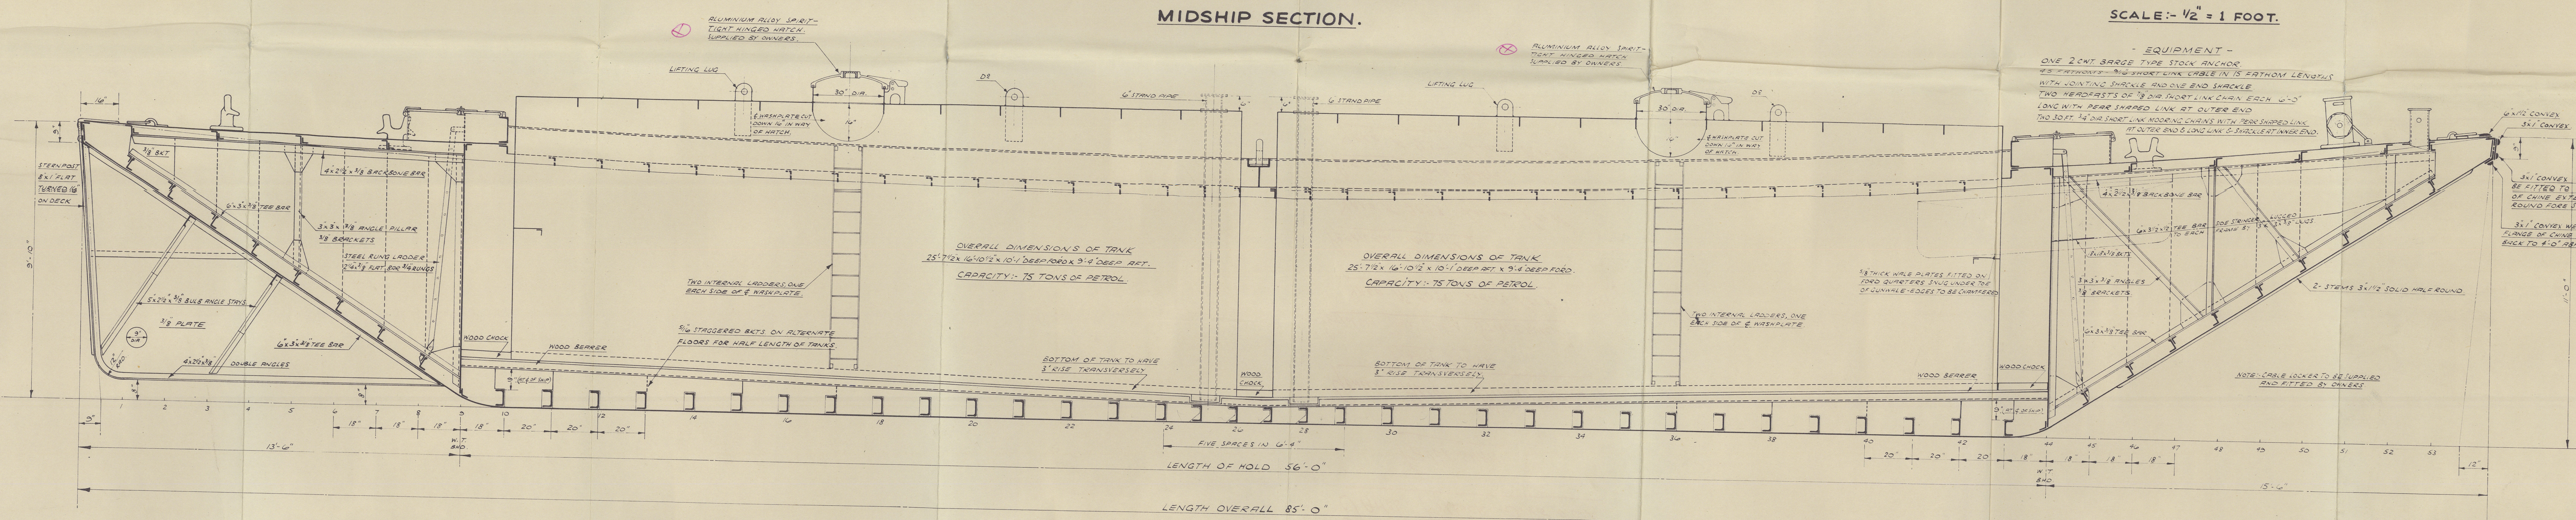

PLAN No. 21,692.

DRAWN BY:- P.E.	JAMES POLLOCK & SONS & CO. LTD. SHIPBUILDERS & ENGINEERS
CHECKED BY:- A.M.S	THE SHIPYARD, 3 LLOYD'S AVE. FAYERSHAM, LONDON
DATE:- 26-1-56.	KENT, E.C.3.

27 JAN 1956 011725-011726-0001

APPROVED 29/2/56.

JAMES POLLOCK SONS & CO^{LD}

FAVERSHAM.

GENERAL ARMY & MIDSHIP SECTION

PLAN NO 21692

PETROLEUM TANK BARGE "STONECHURCH" *

YARD NO 2098 LONDON RIT NO 135784
PIB 3278

PETROLEUM TANK BARGE "STONECOURT 135878
PIB 3282

YARD NO 2099 LONDON RIT NO

PETROLEUM TANK BARGE "
YARD NO 2100 LONDON RIT NO



© 2021

Lloyd's Register
Foundation

011725-011736-0001