



21 FEB 1937


Detalle de soldadura de la lanta de
papa, y del tubo para el cable de socorro.

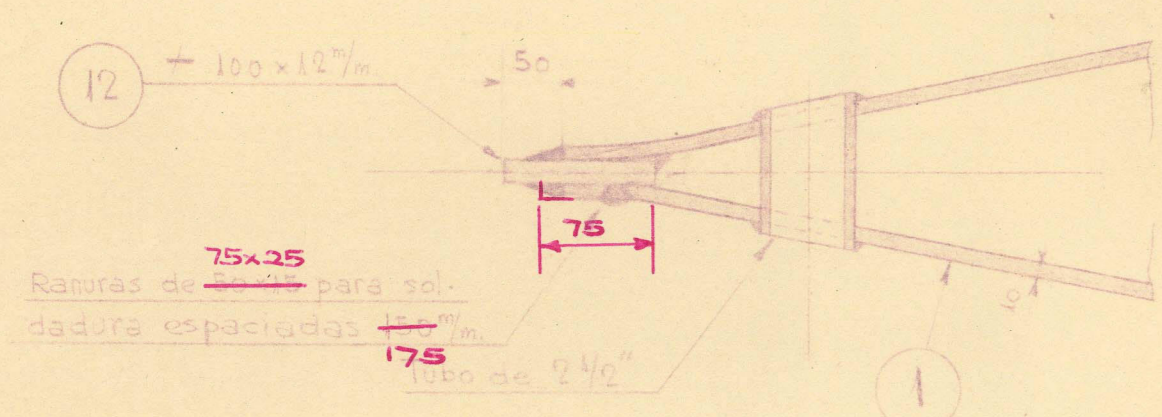

Weld round edges of plate only,
remaining space filled with a
suitable composition and flushed.

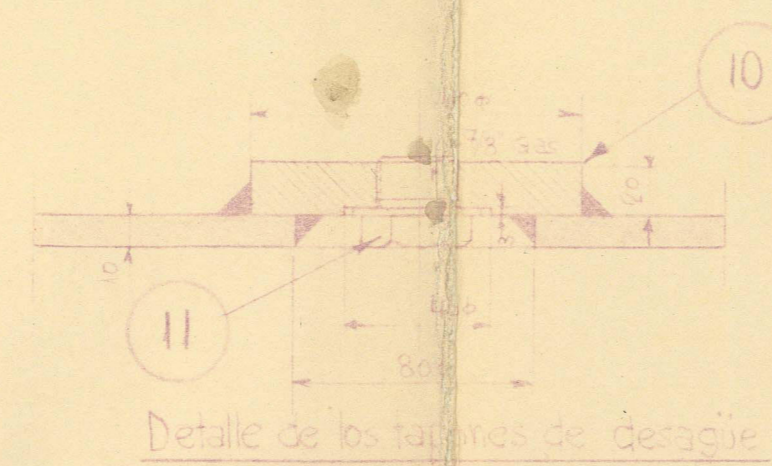

Sección A-A'

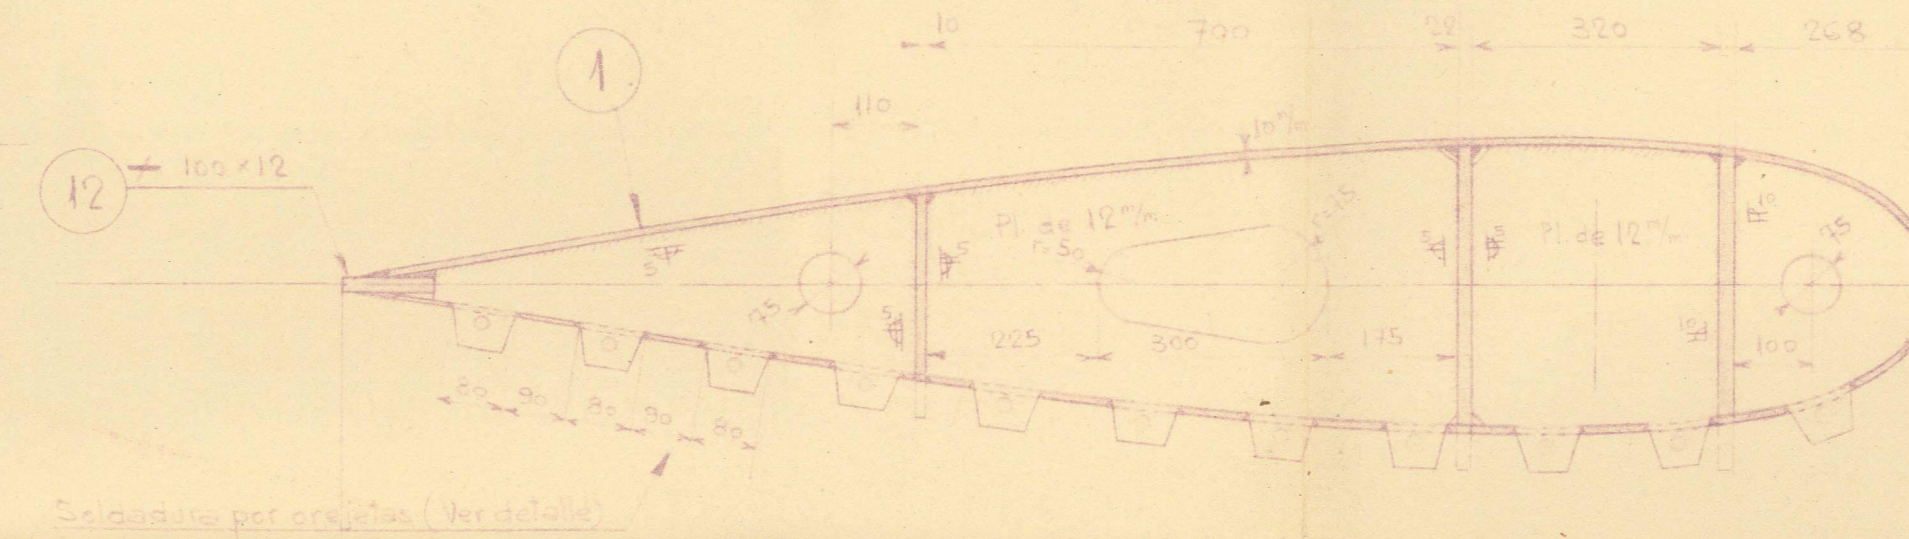


RECORDS DEPT.
LONDON.

15

JOSELIN ★

Rudder plan -

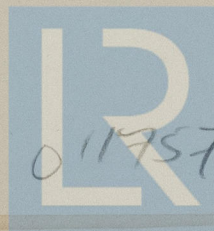

© 2020

Lloyd's Register
Foundation

011757-011765-0055