


EQUIPMENT.  
 3 BOW ANCHORS ..... 28 CWTs  
 1 STREAM " ..... 7 CWTs  
 70 fms. Haws 6" Hemp  
 90 fms. Warp 5" Hemp

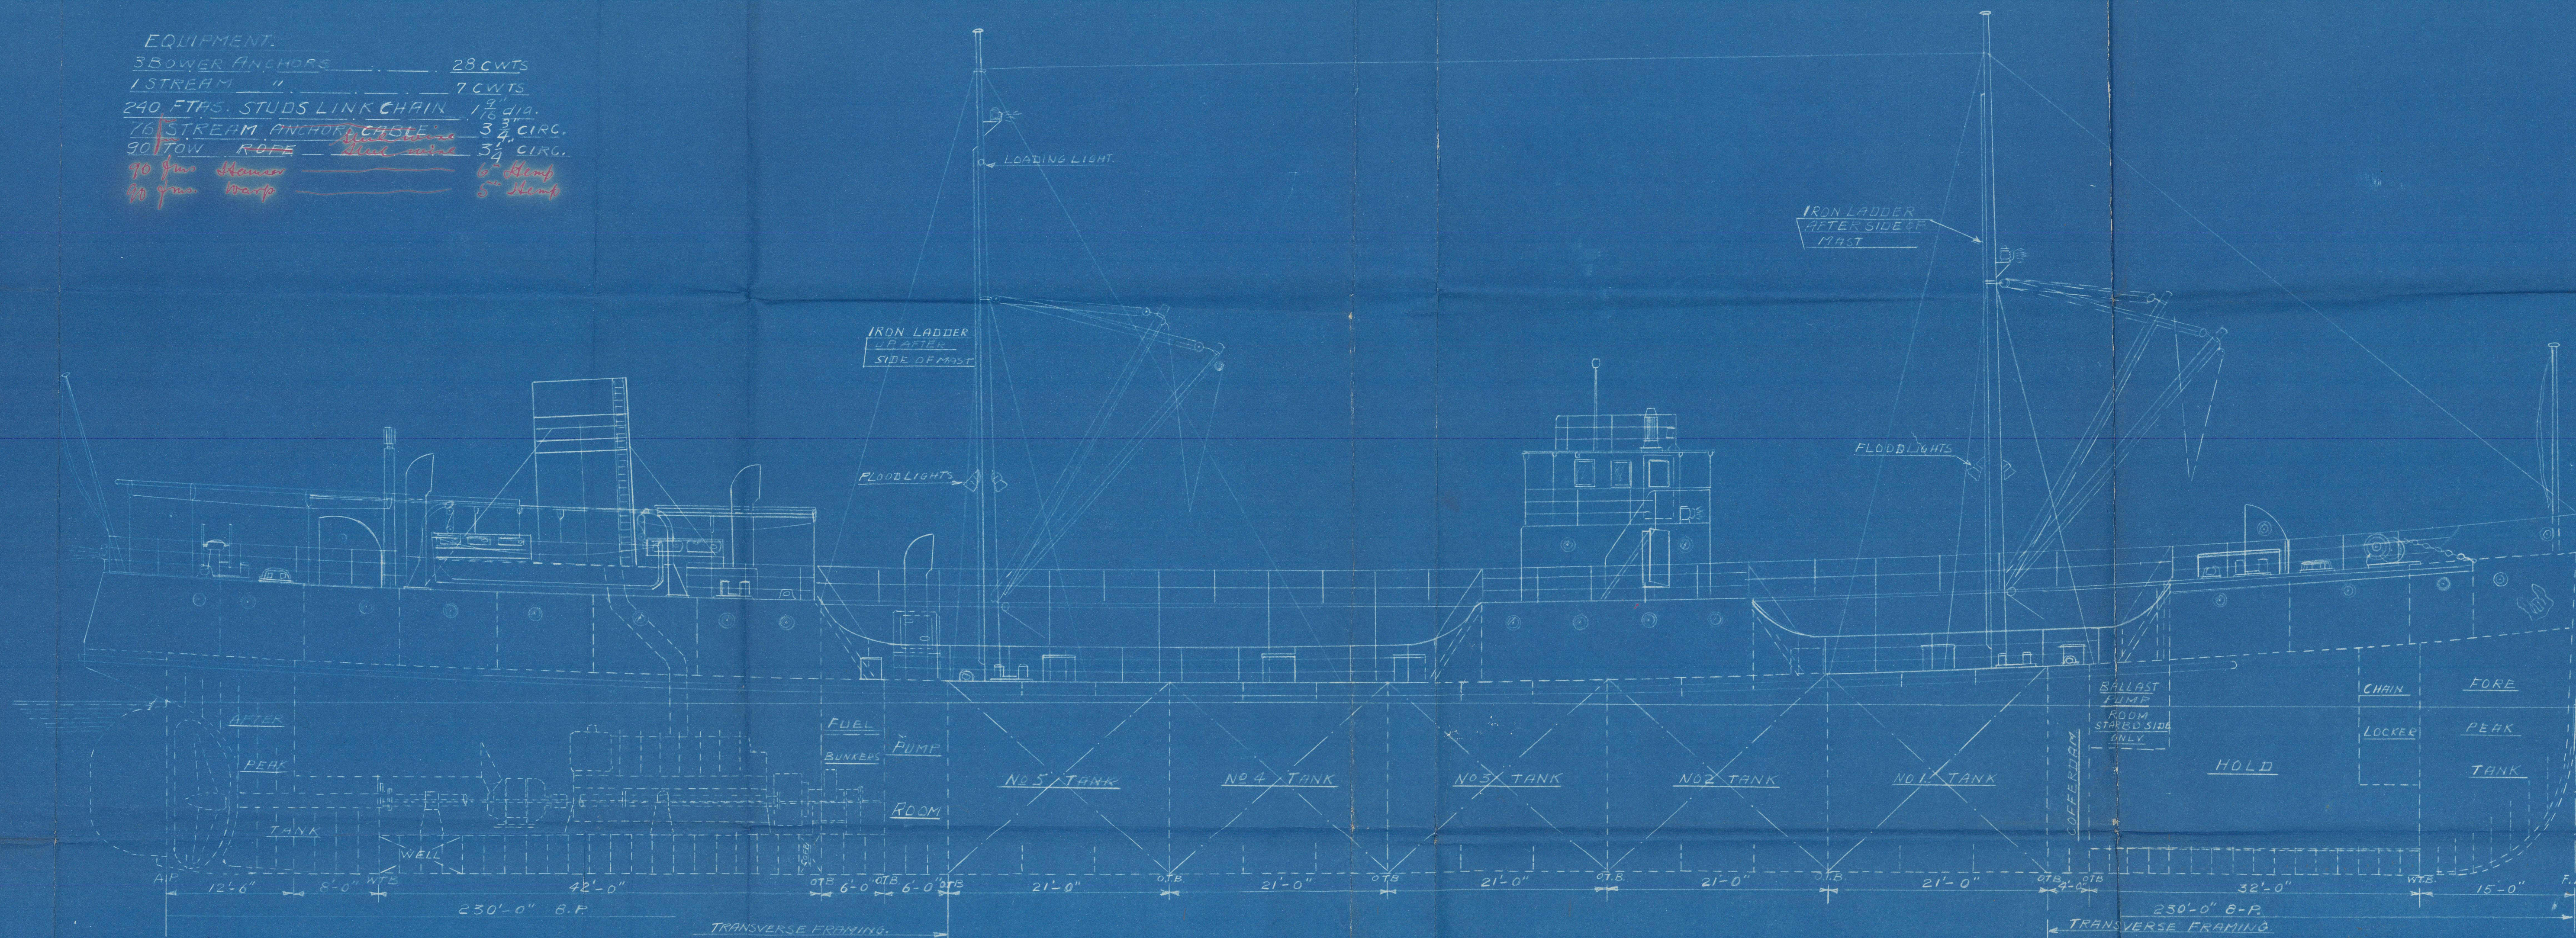

APPROVED  
 MAR 15 1938  
 LLOYD'S REGISTER OF SHIPPING  
 NEW YORK  
*San Francisco Calif.*

CONTRACT 65.

DIMENSIONS.	
LENGTH OVERALL	239'-11"
LENGTH B. P.	230'-0"
BREADTH M.L.D.	39'-0"
DEPTH M.L.D.	18'-6"
DRAFT LOADED M.L.D.	16'-8"

MARINE INDUSTRIES LTD  
 SOREL QUE.  
 WELDED STEEL OIL TANKER FOR  
 BRITISH COLUMBIA SERVICE.  
 DRAWN. APPROVED  
 TRACED DATE  
 CHECKED. SCALE 1"=1'-0"  
 CONTRACTING DWG. NO. 0113 15-0144

Lloyd's Register  
 Foundation



M. V. "PETROLITE"  
Nº 65-  
GENERAL ARRANGEMENT-PROFILE

MONTREAL RPT # 4830

011757-011765-0149



© 2010 Lloyd's Register  
Lloyd's Register  
Foundation