



N^o 677 PROFILE, DECK AND TANK PLANS


SCALE - 1/8" = 1' 0"
 SLANTINGS SUITABLE FOR A SUMMER MID DRAFT OF ABOUT 30'-5"
 1/2 CLASS TIDEAL CARRYING PETROLEUM IN BULK. LONGITUDINAL FRAMING
 SHELL AND DECK BUTTS WELDED
 CONSTRUCTION PATENT N^o 81932 & 883017

 


ELEVATION SHOWING WEB SUPPORTS

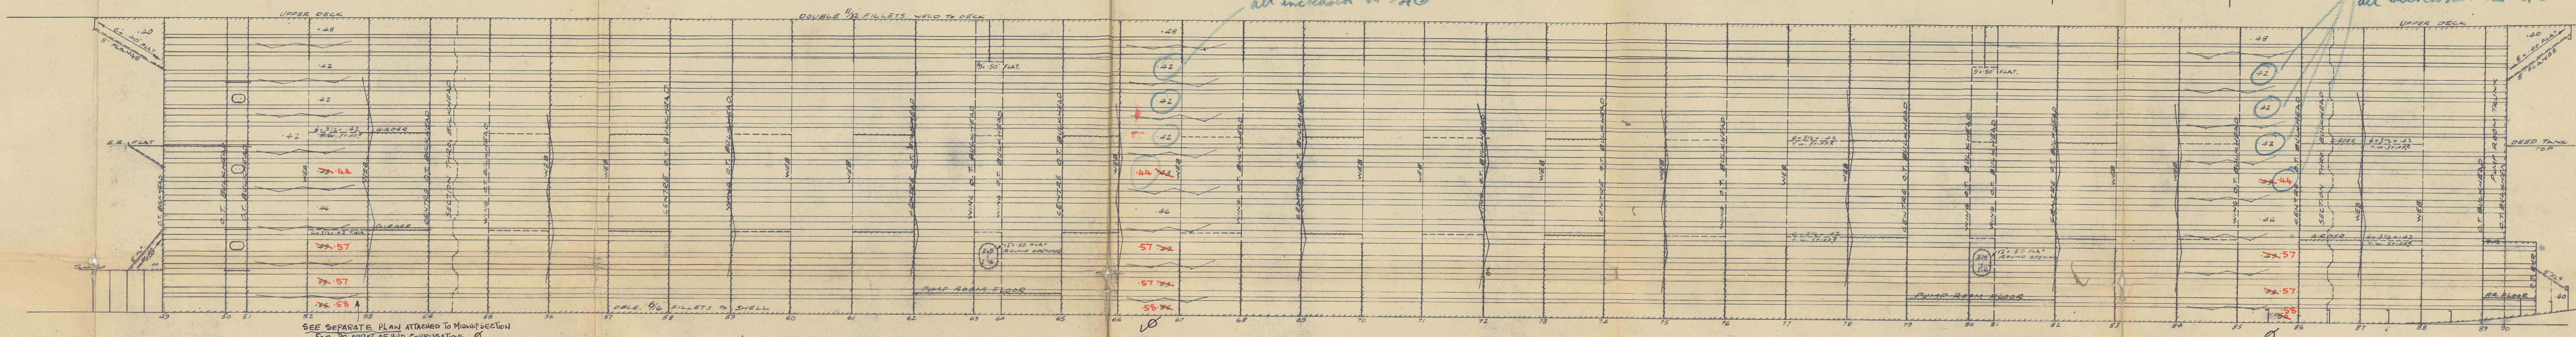

SIDE LONGITUDINAL BULKHEADS

 

UPPER DECK

 

PLAN OF TANKS


J. W. Thompson Ship 677

Profile Deck & Tank Plan.

SUNDERLAND RPT. NO. (C11) 36114 ★ *Sheaf Royal*

SUNDERLAND RPT. NO. 36141

RECORDS DEPT.
LONDON

