
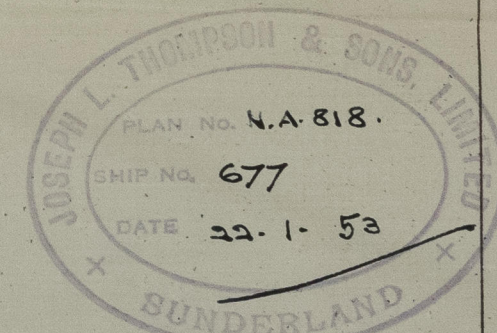


— M.V. No 677 & FUTURE VESSELS. —


PROPOSED MODIFIED ARRANGEMENT OF SOLEPIECE AND SIDE PLATES

OF FABRICATED STERN FRAME

WHERE JOINING KEEL PLATE

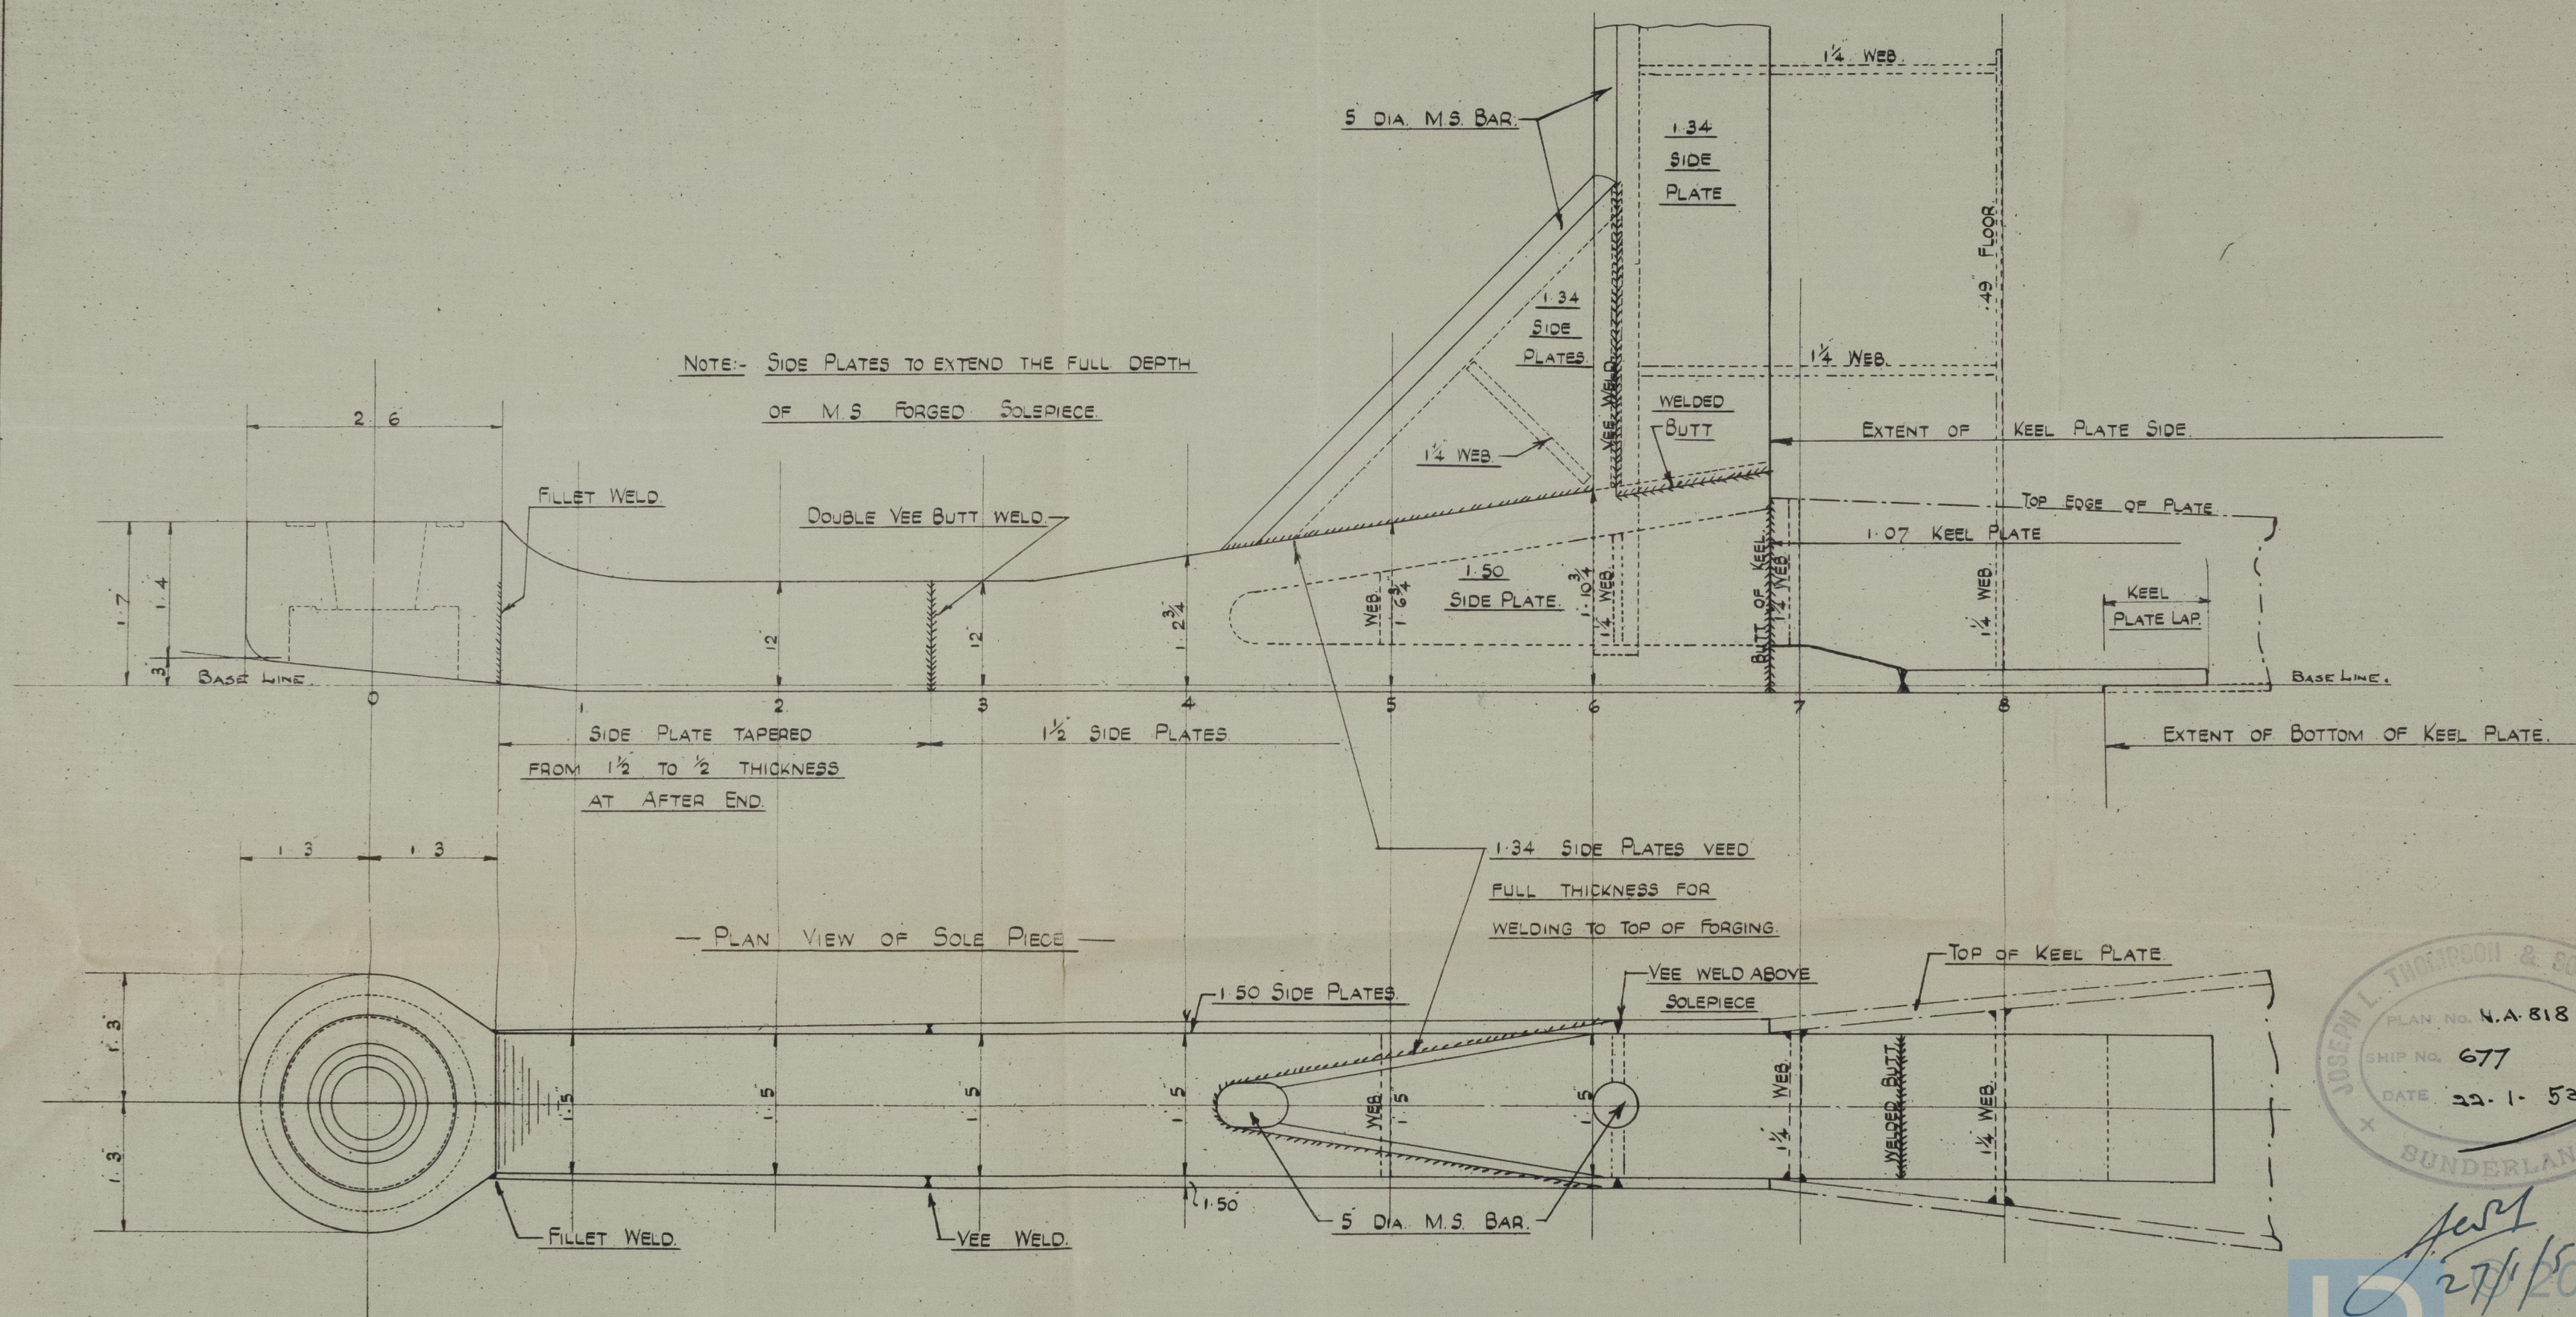

011757-011765-0201

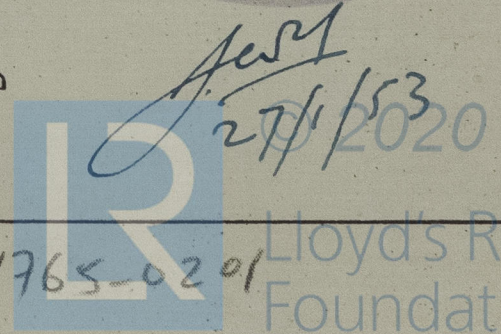

RECORDS DEPT.
LONDON

7

* Sheaf Royal.

Sternframe
mod.

J. L. THOMPSON & SONS LTD

YARD N° 677

STERNFRAME
MODIFICATION

Thompson No. 677
Sternframe Modification



© 2020

Lloyd's Register
Foundation

011757-011765-0201