

STEEL SCREW MOTOR VESSEL




YARD No 324.

Scale 1/4" = 1 FOOT

DIMENSIONS - 175' 3" x 30' 0" x 12' 6" M-P to U OR

TO CLASS LLOYDS 100 A1

RAISED QR. Dk 3' 9"

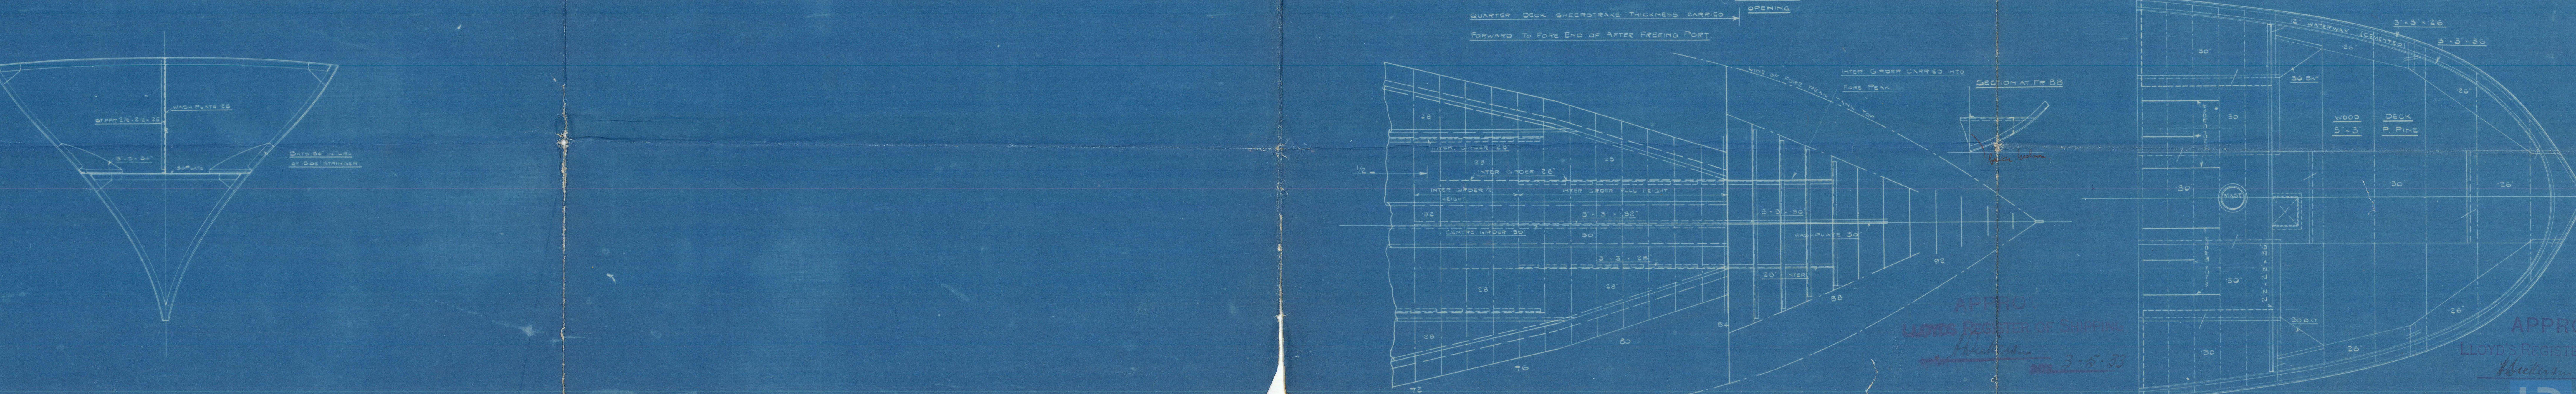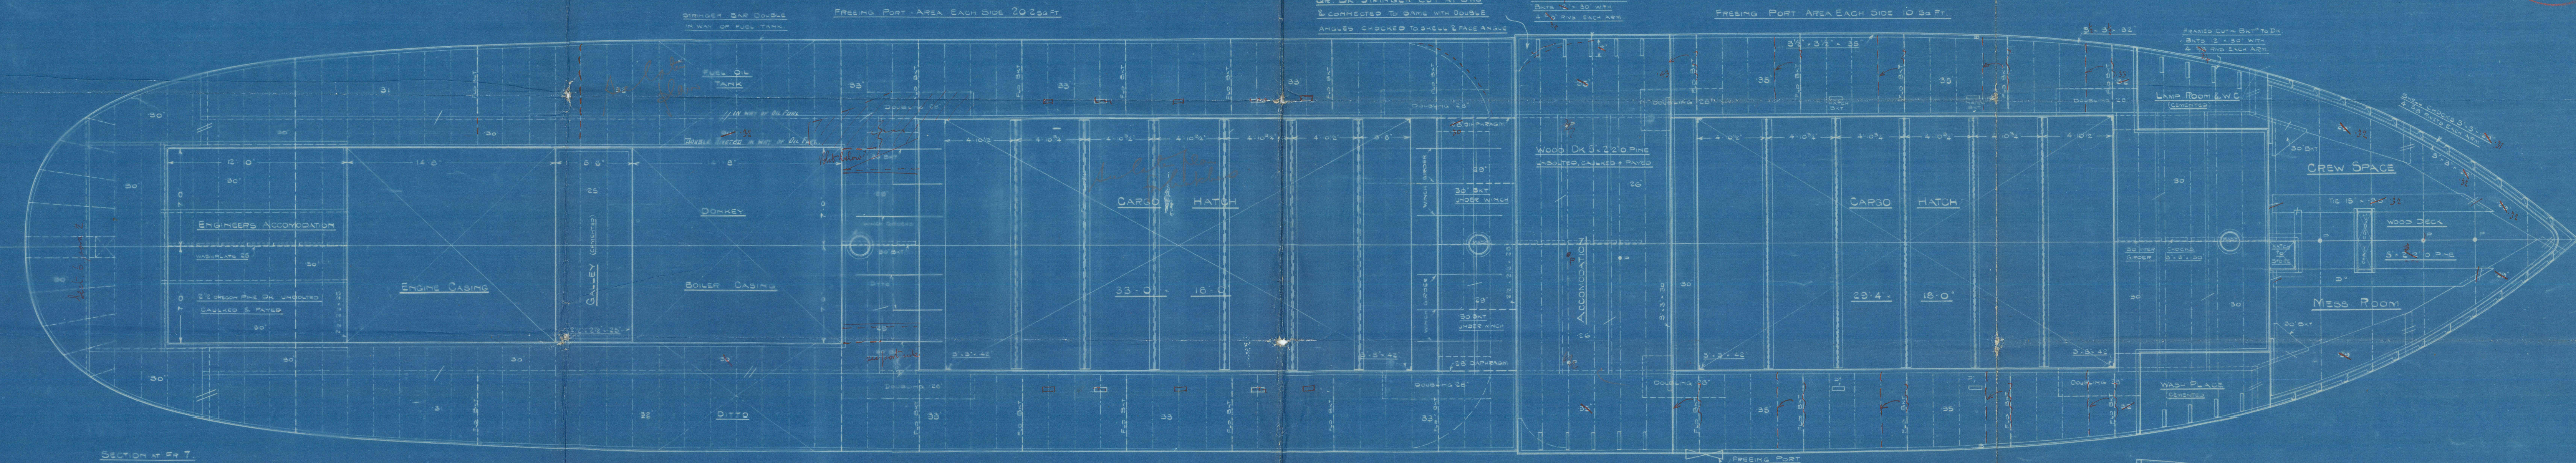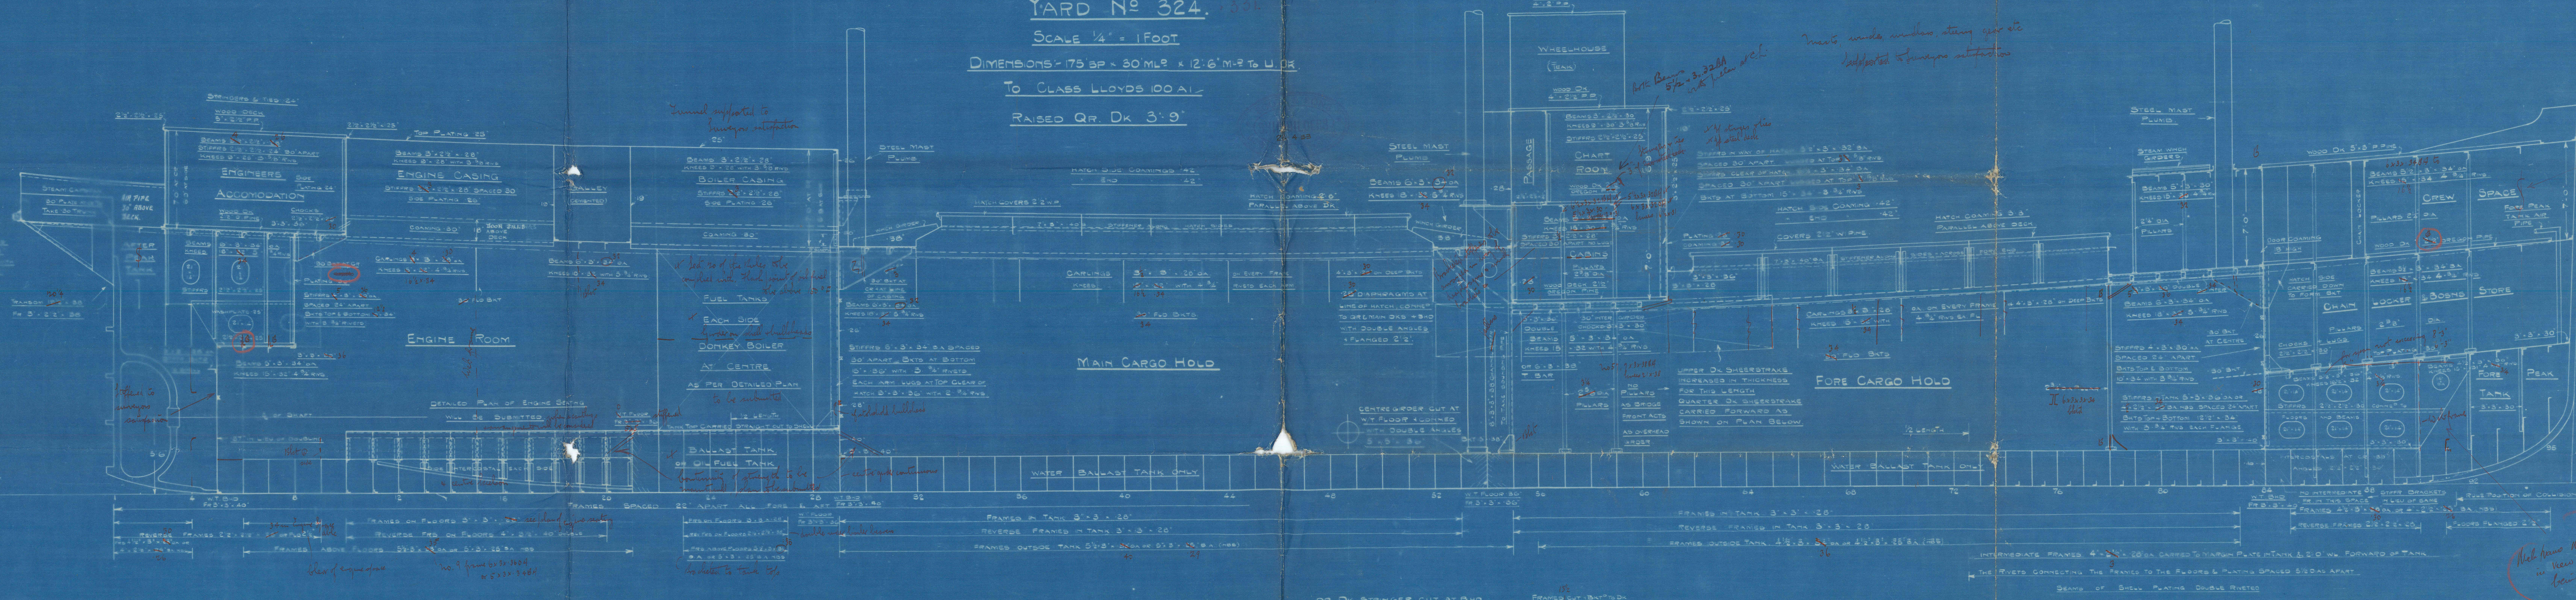

APPROVED
LLOYD'S REGISTER OF SHIPPING
3.5.33

APPROVED
LLOYD'S REGISTER OF SHIPPING
3.5.33

D/S 861^A
Messrs. Scott & Sons.

Yard No 324 + 331.

Profile & Decks.

X *Breeze* ^{Guibord}
GLASGOW REPORT No. 53809

Breeze *
GLASGOW REPORT No. 53980

Gale ³³¹ _{Ybd}
GLASGOW REPORT No. 56021

Gale
GLASGOW REPORT No. 56169



© 2021

Lloyd's Register
Foundation

01825-01804-0279