


M.V. BREEZE.

12.12.44

PLAN SHOWING PROPOSED
MESSROOM IN ENGINE CASING.

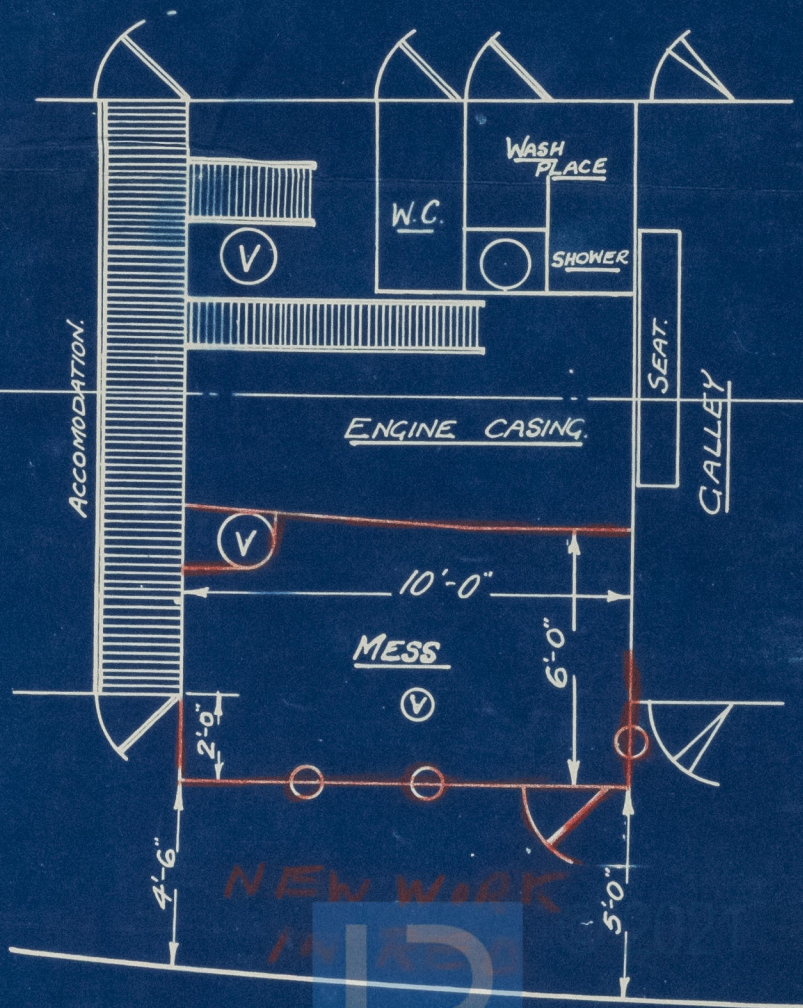

SCALE $\frac{1}{4}'' = 1'-0''$

STEVENSON & COOK ENG CO
PORT CHALMERS.