


24.11.44.

SCALE $\frac{1}{4}'' = 1'-0''$

M.V. "BREEZE"⁴

LAYOUT OF FORD

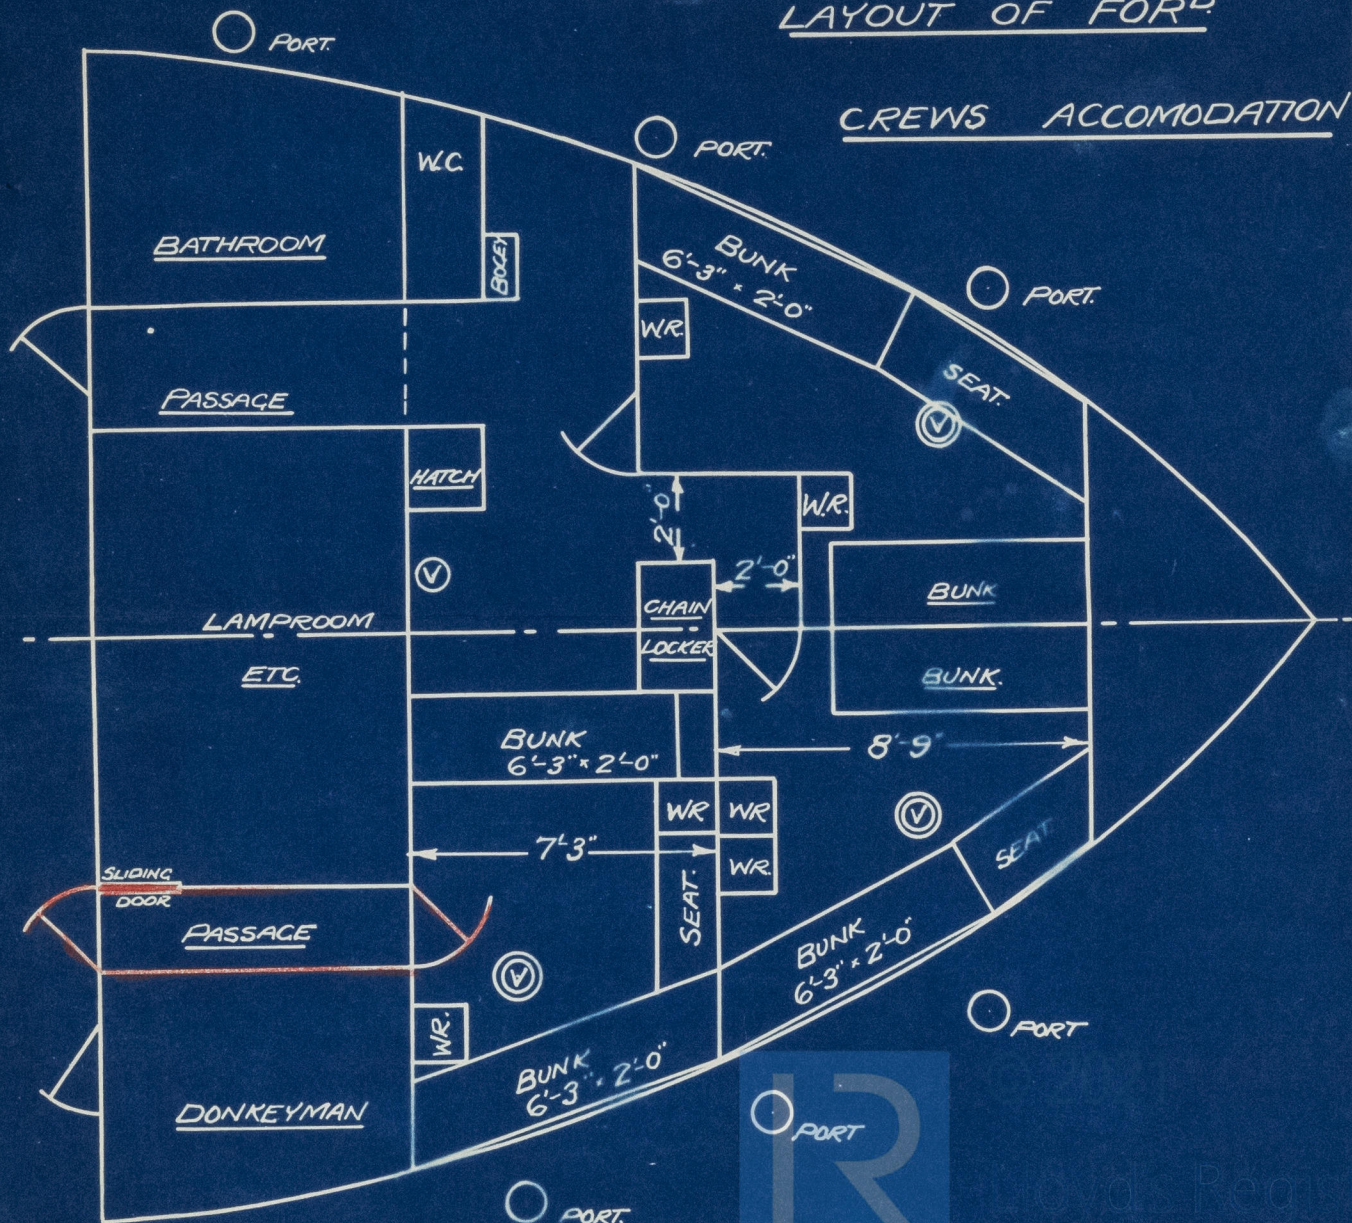

STEVENSON & COOK ENG CO

01800-01804-0299 PORT CHALMERS