

SCALE :-  $\frac{1}{2}$ " = 1 FOOT & AS SHOWN.

OWNERS EXTRAS DENOTED  
THUS \*.

TO CLASS A1. <sup>in service in the Mercantile Category</sup> LLOYDS FOR TOWING SERVICES.

LENGTH B.P.	88'-0"
BREADTH MOULDED.	24'-0"
DEPTH MOULDED TO MAIN DECK.	12'-0"

SCANTLINGS SUITABLE FOR SUMMER  
MOULDED DRAUGHT OF APPROX.  $10' - 2\frac{1}{2}"$

$$88(24 + 12) = 3168.$$


1 STOCKLESS BOWER ANCHOR. 5cwt's.  
1 OFF 45 FATHOMS  $7\frac{1}{2}$ " STUD LINK CHAIN CABLE.  
60 FATHOMS,  $5\frac{1}{2}$ " CIRCUMFERENCE MANILLA HAWSER. (6"\*)  
60 " "  $3\frac{1}{2}$ " " " WARPS.  
120 " " 2" " " HANDY LINES.

ITEMS TO BE WELDED	REMARKS.
MAIN DECK BUTTS & SEAMS.	SEAMS RIVETED, EXCEPT IN WAY OF O.F. BUNKERS
BRIDGE " " " "	" "
SHELL & FLOORS IN O.F. BUNKERS.	
ENGINE SEATING.	
AUXILIARY SEATING.	
BULKHEAD PLATING & STIFFERS.	
DECKHOUSE CASING.	STIFFENERS RIVETED
BULWARK PLATING & STIFFERS.	RAIL BAR RIVETED
FRAMES TO FLOORS.	

ALL WELDING TO BE IN ACCORDANCE WITH APPROVED STANDARD  
RIVETING. WELDING DETAILS.

SHELL PLATING BUTTS & SEAMS RIVETED EXCEPT IN WAY OF O.F.BUNKERS  
" " GARBORD STRAKE - D.R. BUTTSTRAPS.  
GARBORD STRAKE TO BAR KEEL - 2 ROWS, 7/8" RVS. 5 DIAS APART EACH ROW REELED.  
FRAMES TO SHELL RINGS SPACED 7 DIAS. APART CLEAR OF PEAK TANKS.  
" " " " 5 1/2 " " IN WAY " " " 2 ROWS 25 LN  
WAY OF BULK

	BY	DATE	APPROVED BY	DATE
DRAWN	R.J.HARTLEY			
CHECKED				
TRACED				
CHECKED				

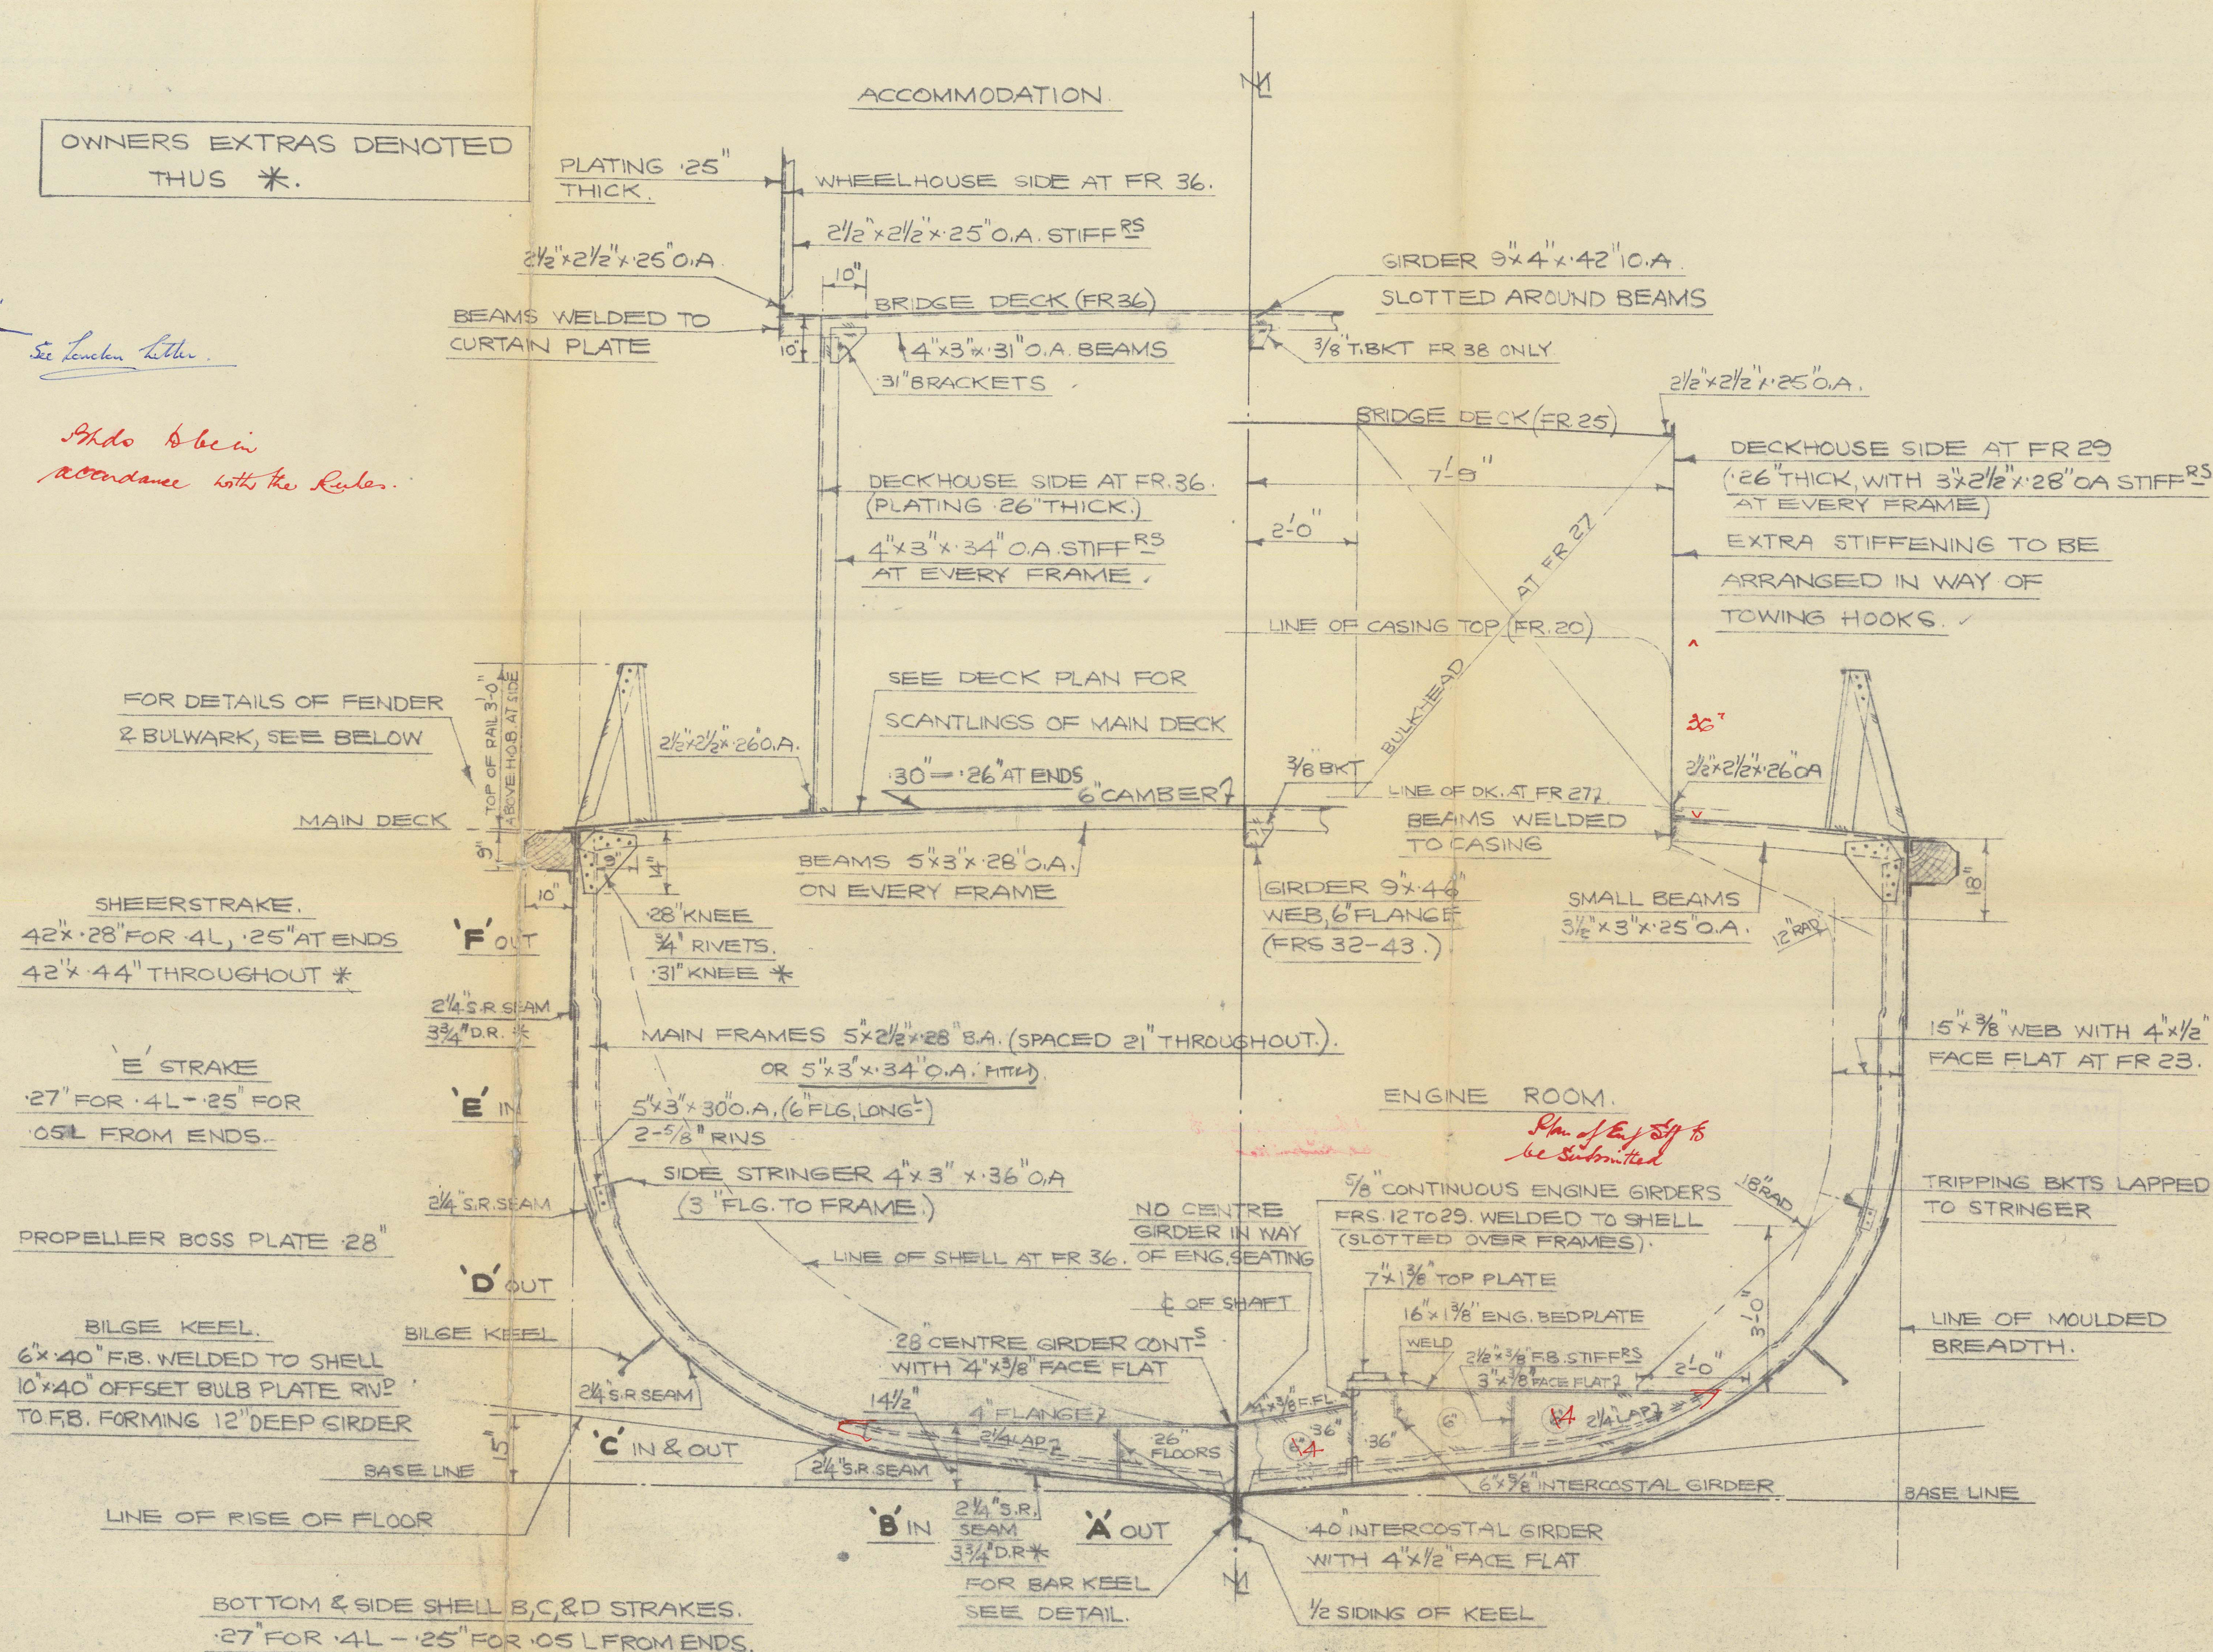[illegible]

GARBOARD PLATE  
 5 3/4" x 1 1/8" F.B.  
 1/2 SIDING OF KEEL  
 SEE TABLE FOR RIVETING  
 7 1/2"  
 1 3/4" DIA SOLID ROUND BAR  
 WELDED TO FLAT BAR.  
 1/4" OF SHIP

NOTE  
ENGINE BEDPLATE IN WAY OF GEARCASE  
(FR 15-19). 18" x 1<sup>3</sup>/<sub>8</sub>".  
FOR SCANTLINGS OF DECKS, W.T. BULKHEADS  
ETC. SEE SEPARATE PLANS.





1

NAME "PEA COCK"  
CAMMELL LAIRDS YARD No. 1298  
LIVERPOOL REPT. No. 153834

MIDSHIP SECTION  
(APPROVED.)

NAME "FLYING COCK"  
CAMMELL LAIRDS YARD No. 1299  
LIVERPOOL REPT. No.

RECORDS DEPT.  
LONDON.

1

NAME "WEATHER COCK"  
CAMMELL LAIRDS YARD No. 1300  
LIVERPOOL REPT. No.




© 2021

Lloyd's Register  
Foundation

011813-008 22-0109



RECORDS DEPT.  
LONDON.

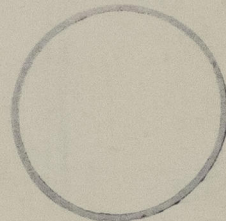

© 2021

Lloyd's Register  
Foundation