



F.O SECTION
LOOKS FOR

F.2 SECTION
LOOK9 FOR9

F.4 SECTION
LOOK9 FORB

TOP PLAN

E.1 SECTION

LOOK FOR

F.3 SECTION
LOOK^g FOR^d

F 4 SECTION
LOOKS FOR

DETAIL OF TACK WELD c/s

DETAIL OF NECK BEARING (Xo)

SECTION AT 6^m W.L.
(DET. OF STOPPER)

SECTION AT 6.400 W.L.

DETAIL A (4)

SECTIONS OF SHOE & SOLE PIECE
LOOKS FOR

DETAIL OF BOTTOM BEARING (%)

圖面來歷	
1. 32-9-5	S1485, 完成圖
訂正: S1497, 完成圖 - 虎	
2. 32-12-20	S1489, 說明書

DAIDO	KAIUN
KOBU	MARU

STERN FRAME

(FINISHED PLAN)

DIMENSION 1400^M x 194^M x 172^M

SCALE	$\frac{1}{10}$, $\frac{1}{20}$	CLASS	L. R. N. K.
-------	---------------------------------	-------	----------------

HULL DESIGNING SECTION
SHIP DESIGNING DEPARTMENT
NAGASAKI WORKS

CHIEF OF DEPT 776

CHIEF _____
HEAD _____

CHECKED S. Lyman

DATE _____ REG NO _____

MITSUBISHI ZOSEN KABUSHIKI KAISHA
TOKYO JAPAN

SHIP No 1498

301 NO 11 303

011851-011859-0063


KoBU MARU ★

SHIMONOSEKI


RPT. NO. FE835

DATED. _____

RECORDS DEPT.
LONDON.

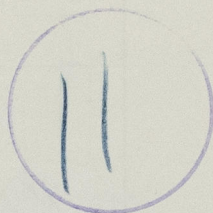

Certified in accordance with app. Angls

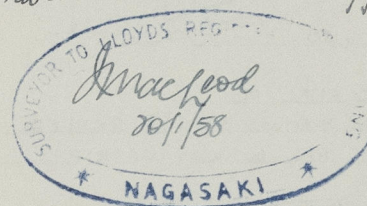

Stemframe



I. Chabon

Lloyd's Register
Foundation