


KOBU MARU ★

RECORDS DEPT.
LONDON.

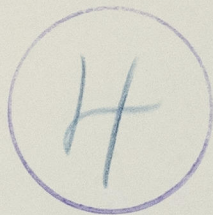


SHIMONOSEKI


RPT NO FE835

DATED. _____

Certified in accordance with App. Anghs

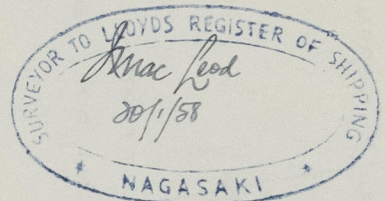

Construction Profile & decks (Sheet 1)

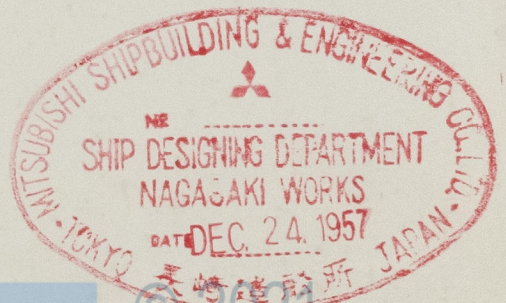

© 2021

Lloyd's Register
Foundation

011851-011859-0067