



SCALE 1 : 200

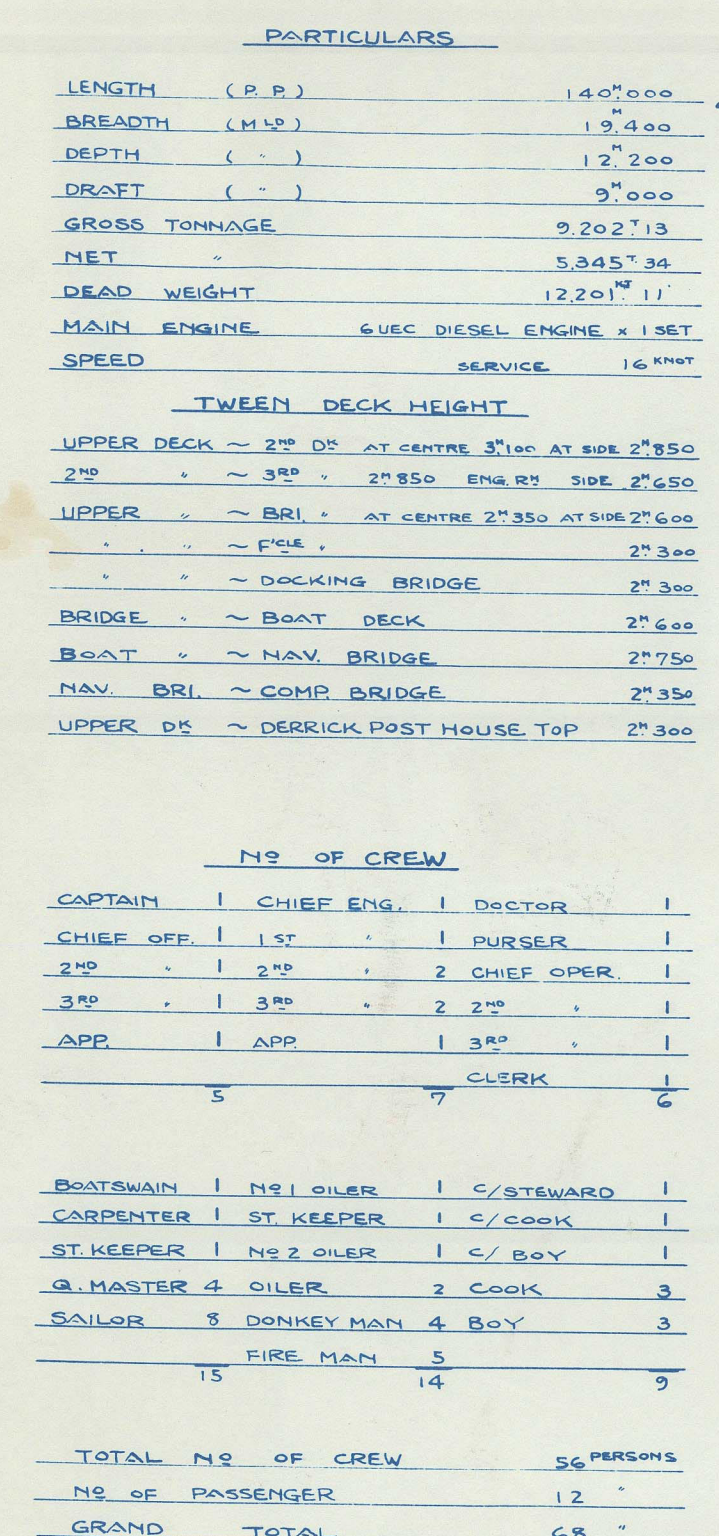

(FINISHED PLAN)

DWG NO W I


FINISHED PLAN

'KOBU MARU' 

SHIMONOSEKI



RPT. NO. FE835

DATED. _____

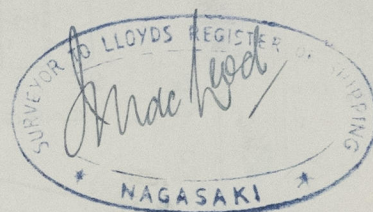

General Arr.

RECORDS DEPT.
LONDON.

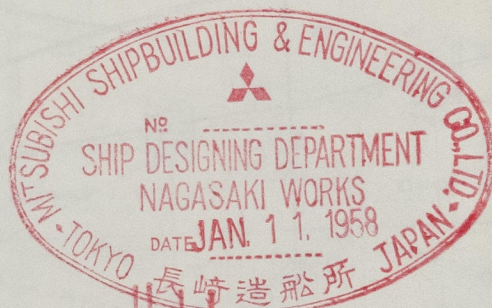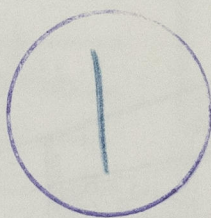


Lloyd's Register
Foundation