

# PROFILE AND DECK

YARD N° 404



S.S. TUG TO LLOYDS CLASS 100 A1. "FOR TOWING SERVICES"



SCALE 1/4" = ONE FOOT

SCANTLING TO SUIT MAXIMUM PERMISSIBLE DRAFT

*2 suitable for a summer draft of about 11.45' measured above top of keel.*

ITEM	DIAR.	SPACING
FRAMES IN PEAKS	5/8"	5' 0"
" " OIL FUEL BUNKERS	5/8"	5' 0"
" " BOILER FEED TANKS	5/8"	5' 0"
" " ELSEWHERE	5/8"	7' 0"
FRAMES AND REV. FRAMES TO FLOORS	5/8"	7' 0"
DECK (SINGLE OR DOUBLE RIVETTED AS MARKED)	5/8"	5' 0"
END LAPS OF STRINGER PLATE AND PLATING FOR 4L AMIDSHIPS	5/8"	4' 0"
" " " " " " AT ENDS	5/8"	4' 0"
SEAMS OF DECK PLATING	5/8"	4' 0"
SEAMS AND LAPS IN WAY OF O.F. BUNKER, FEEDTANKS AND PEAK TANKS	5/8"	4' 0"
STRINGER ANGLE IN WAY OF OIL FUEL BUNKER	5/8"	4' 0"
" " " " " " ELSEWHERE	5/8"	4' 0"
SEAMS IN WAY OF O.F. BUNKER, FEED TANK AND PEAK TANKS	5/8"	6' 0"
" " " " " " ELSEWHERE	5/8"	7' 0"

LENGTH B.P. 110'-0"  
BREADTH MLD. 30'-0"  
DEPTH MLD. 13'-6"

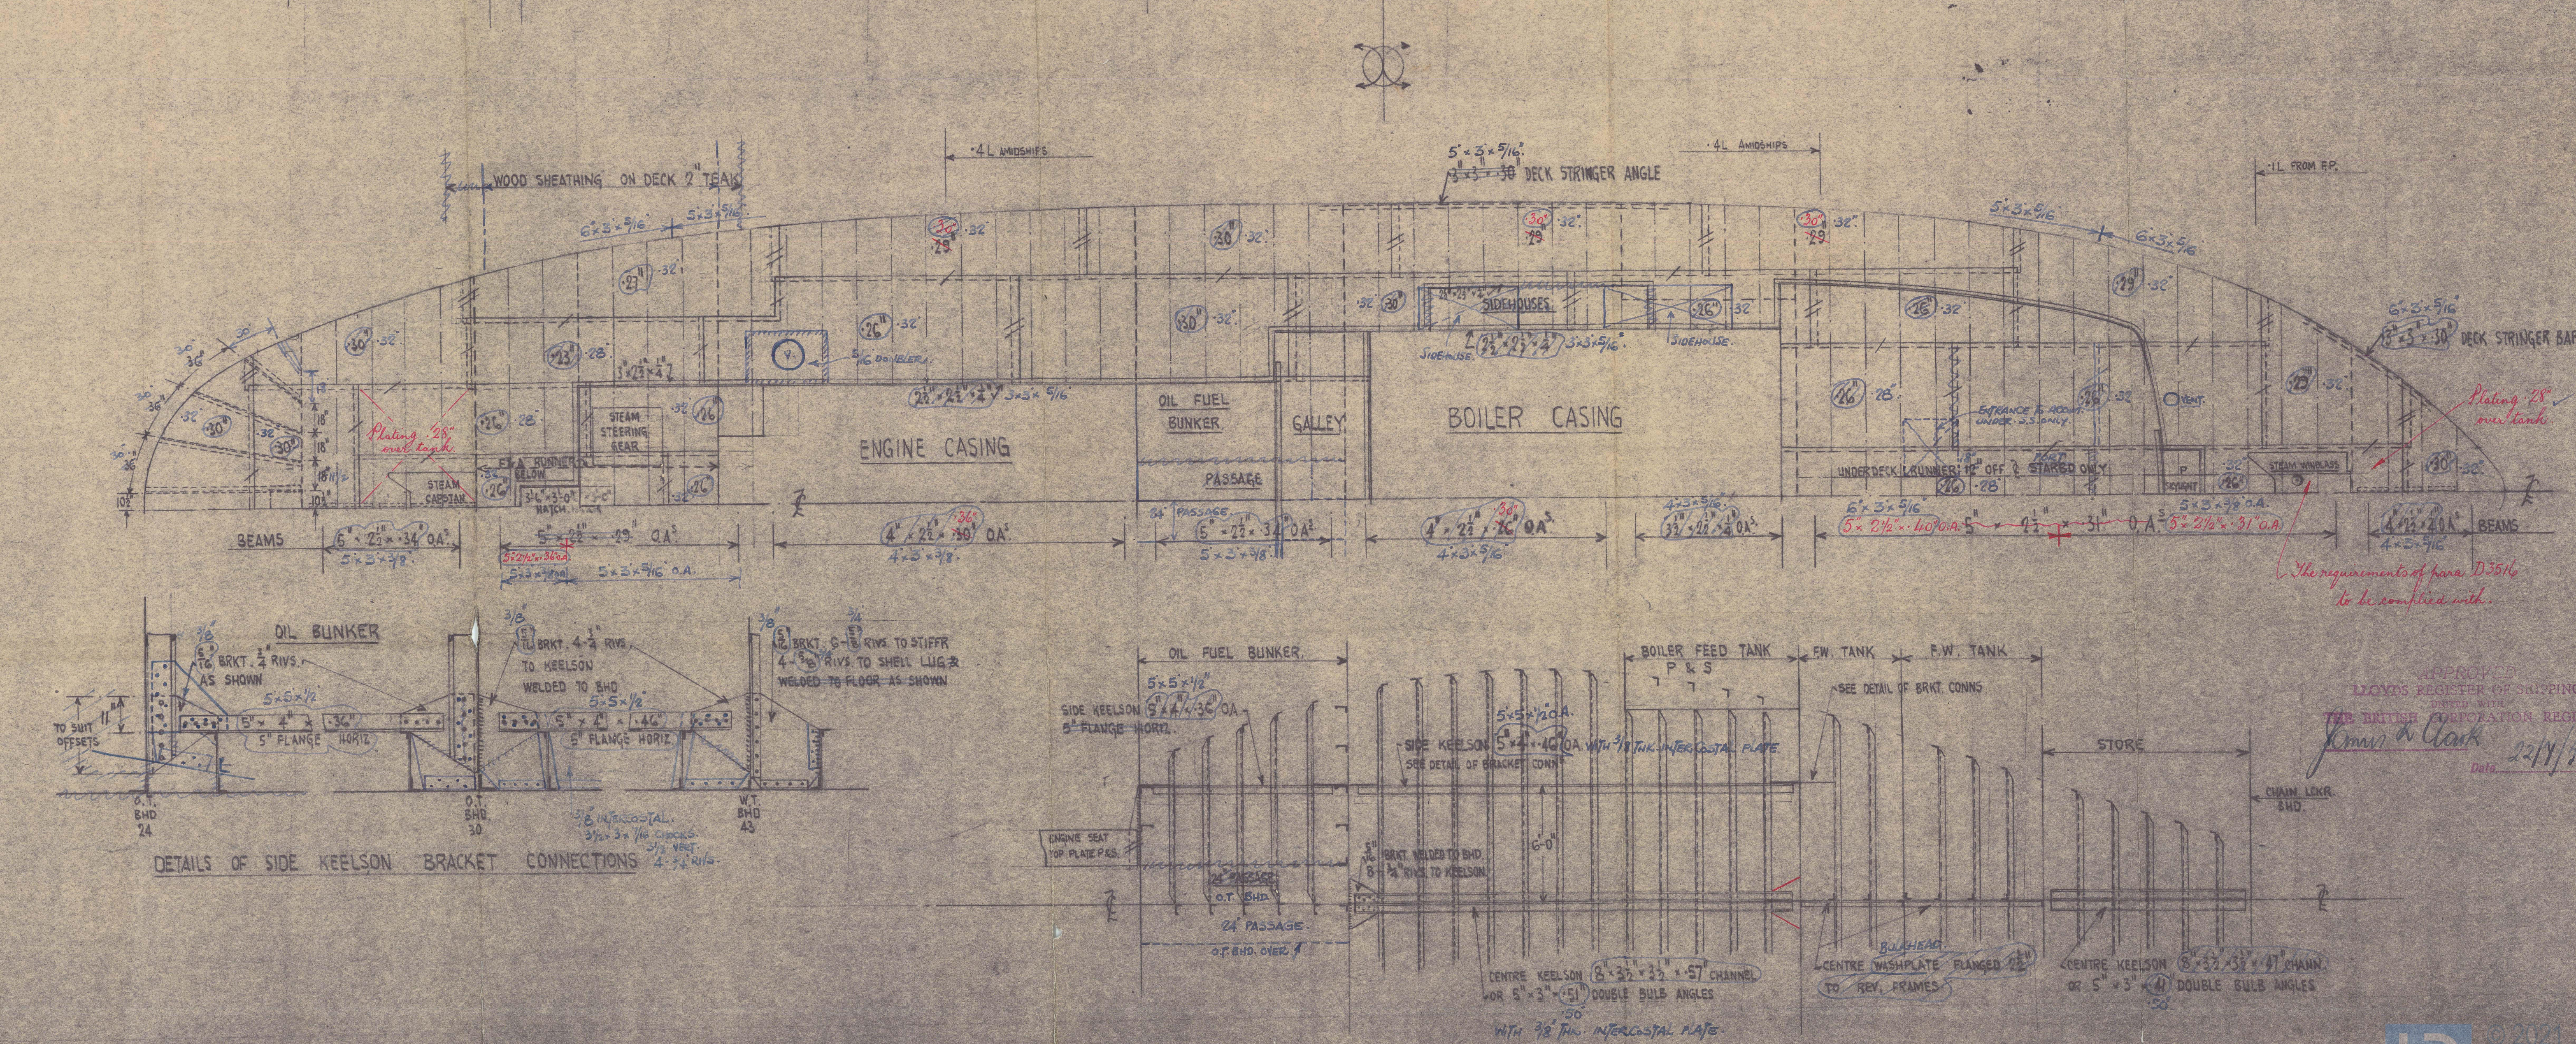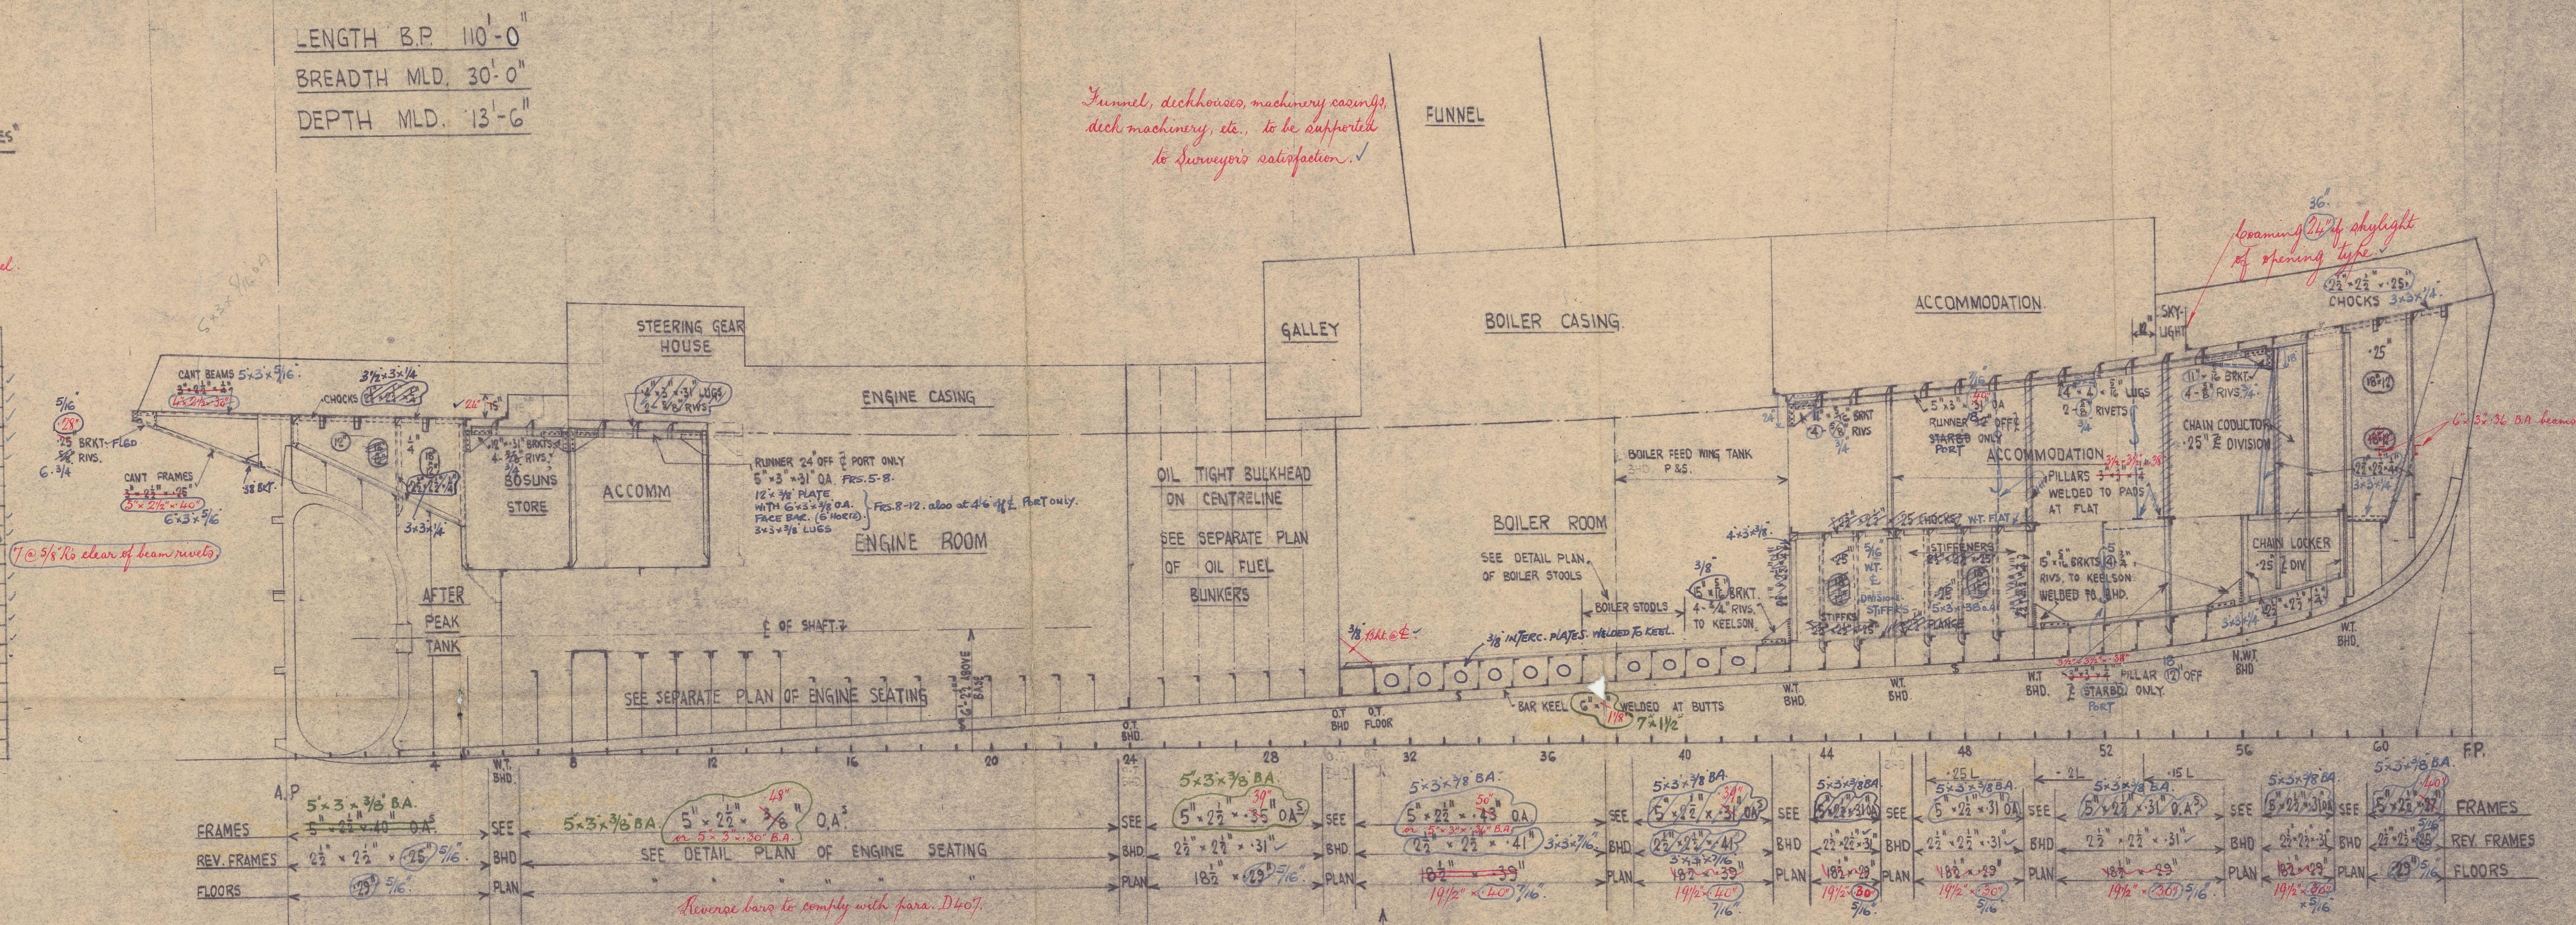

APPROVED BY  
LLOYD'S REGISTER OF SHIPPING  
FOR ENTRY IN REGISTRATION REGISTER  
James & Clark 22/1/53  
Date



"SHERIFA"

(2.)

SCOTT & SONS.

YARD NO. 404.

- PROFILE AND DECKS. -

GLASGOW REPORT No. 82919


4/12/54.

J. L. Wilson.

GLASGOW REPORT No.

83922

RECORDS DEPT.,  
LONDON.

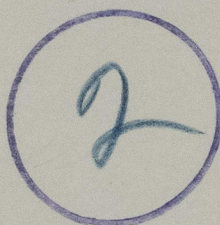

© 2021

Lloyd's Register  
Foundation

011860-011868-0086