


ADMIRALTY M/S TRAWLERS


YARD N^{OS} 652-3

ALTERNATIVE METHOD OF FITTING REVERSE BARS TO FLOORS & ATTACHMENT OF CENTRE INTERCOSTAL PLATES TO FLOORS

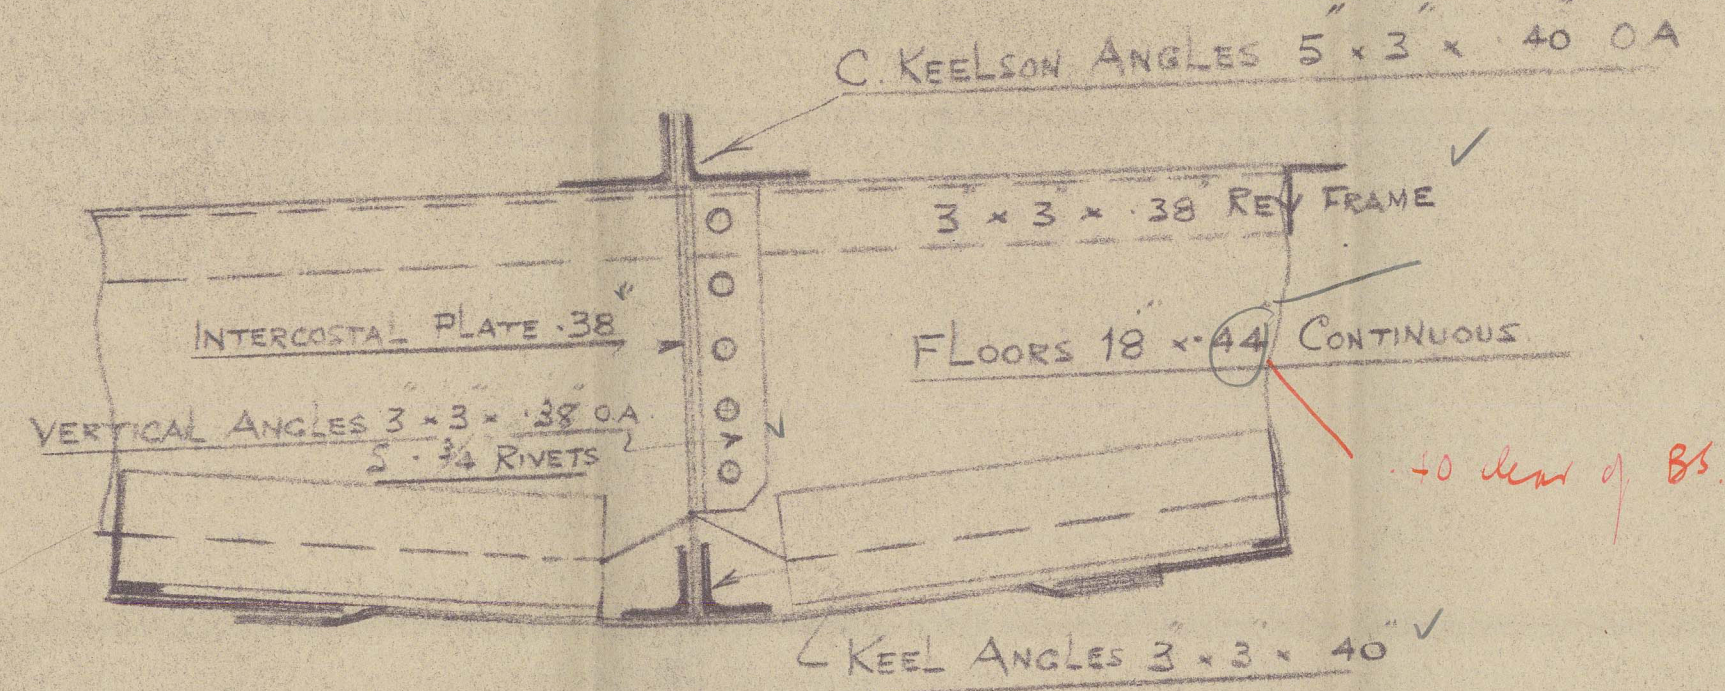


SECTION

In increase in BS see Machinery Section

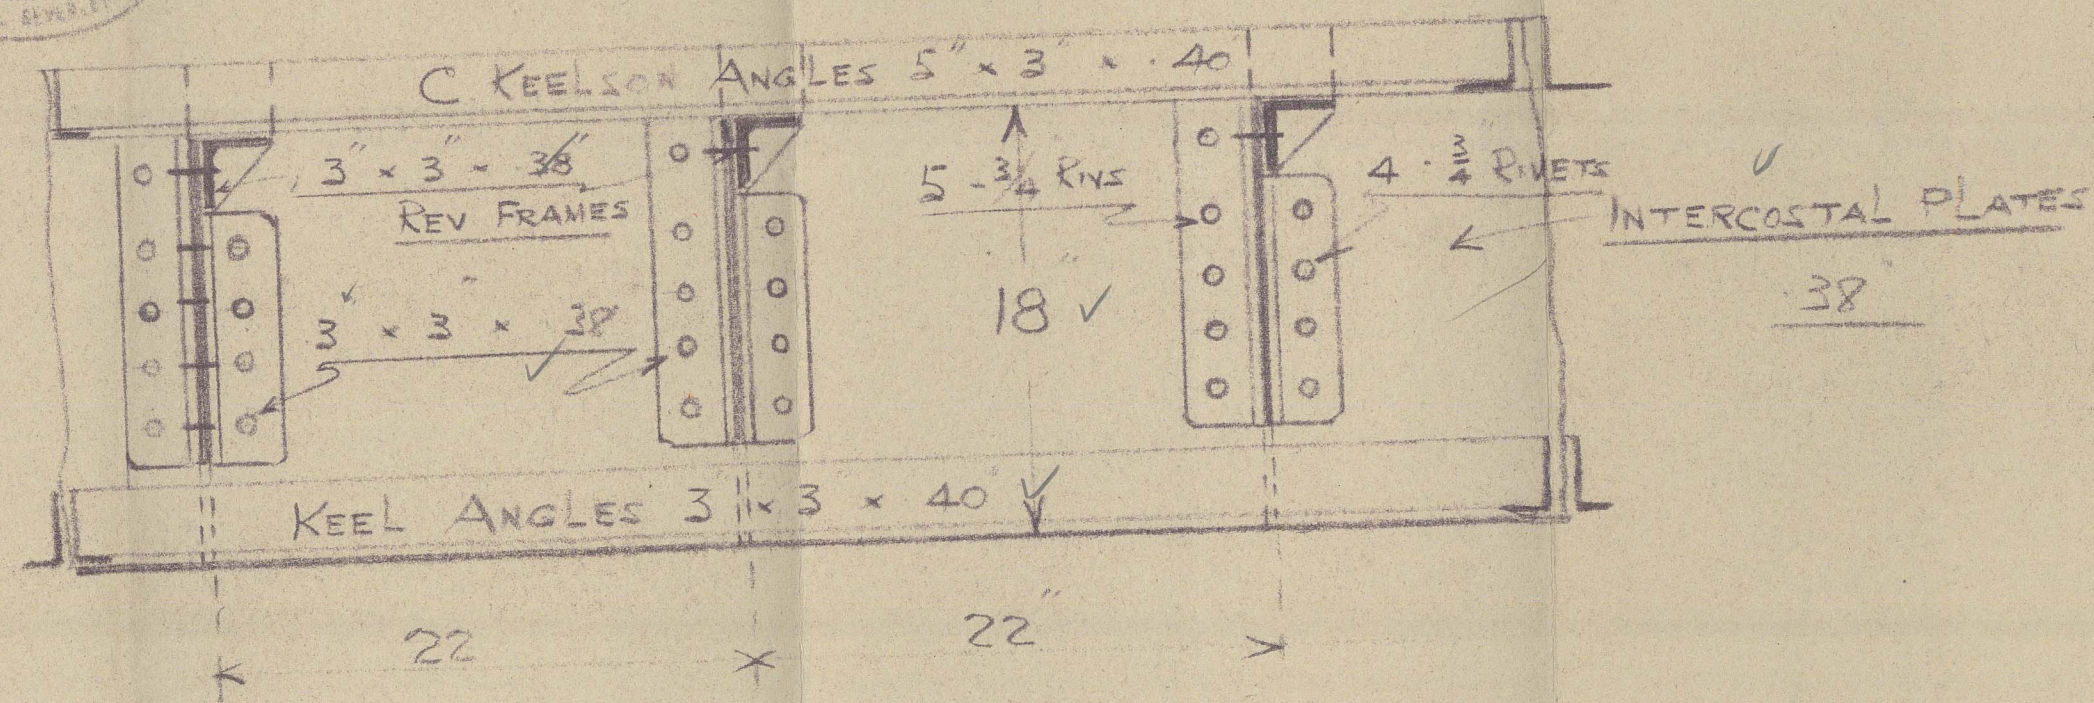

ELEVATION OF C^B INTERCOSTAL


~~BOX NO 878~~

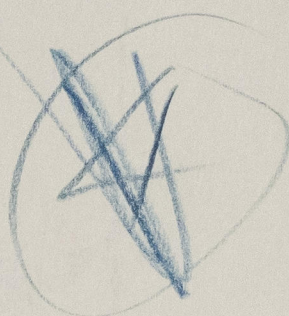

HULL

Sherris Book. Nelson of Jemmel, Ltd.
Beverley.

Yard No. 652-3

Birch 

RECORDS DEPT.,
LONDON



Lloyd's Register
Foundation