

# MIDSHIP SECTION

SCALE 1/2 INCH TO ONE FOOT

DIMENSIONS 320' 4 1/2" x 24' 3" MLD & 21' 9 1/2" HOLA

TO CLASS 100 A1 AT LLOYD'S THREE-DECK RULE (WITH FREEBOARD)



Prop beams 1/2" x 3" x 3/4" bolt angles  
Side plating 1/20  
Stringer 3/4" x 1/2" deck yellow pine 5' 3"  
Forecastle beams, built 5' 3" x 3/4" angles 3' 3" x 3/4"  
Side plating 1/20  
Stringer 2 1/2" x 1/2" deck pitch pine 5' 3"

18 FEB 1949


Length from after part of stem to fore part of sternpost 318' 2"  
Breadth moulded 43' 9 1/2"  
Depth with 11 round of beam 25' 2"  
12 6 Depth in length 12 to 13  
4 2 Breadth in length

4.9.97  
15.9.97  
25.9.97  
30.9.97  
12.10.97

Prop 26.00  
Bridge 69.00  
Sole 36.16  
132.16 = 115 of structure

1/2 Girth 143.20  
1/2 Breadth 43.90  
Depth 25.16

80 26 x 318.16 = 25917 + (415 x 3 x 25917) = 1437 = 30206 = 30020 for equipment  
80 deduct 80 + 24600 = 24680 for frames, plating &c  
80 26 x 318.16 = 26490 = 85 26500

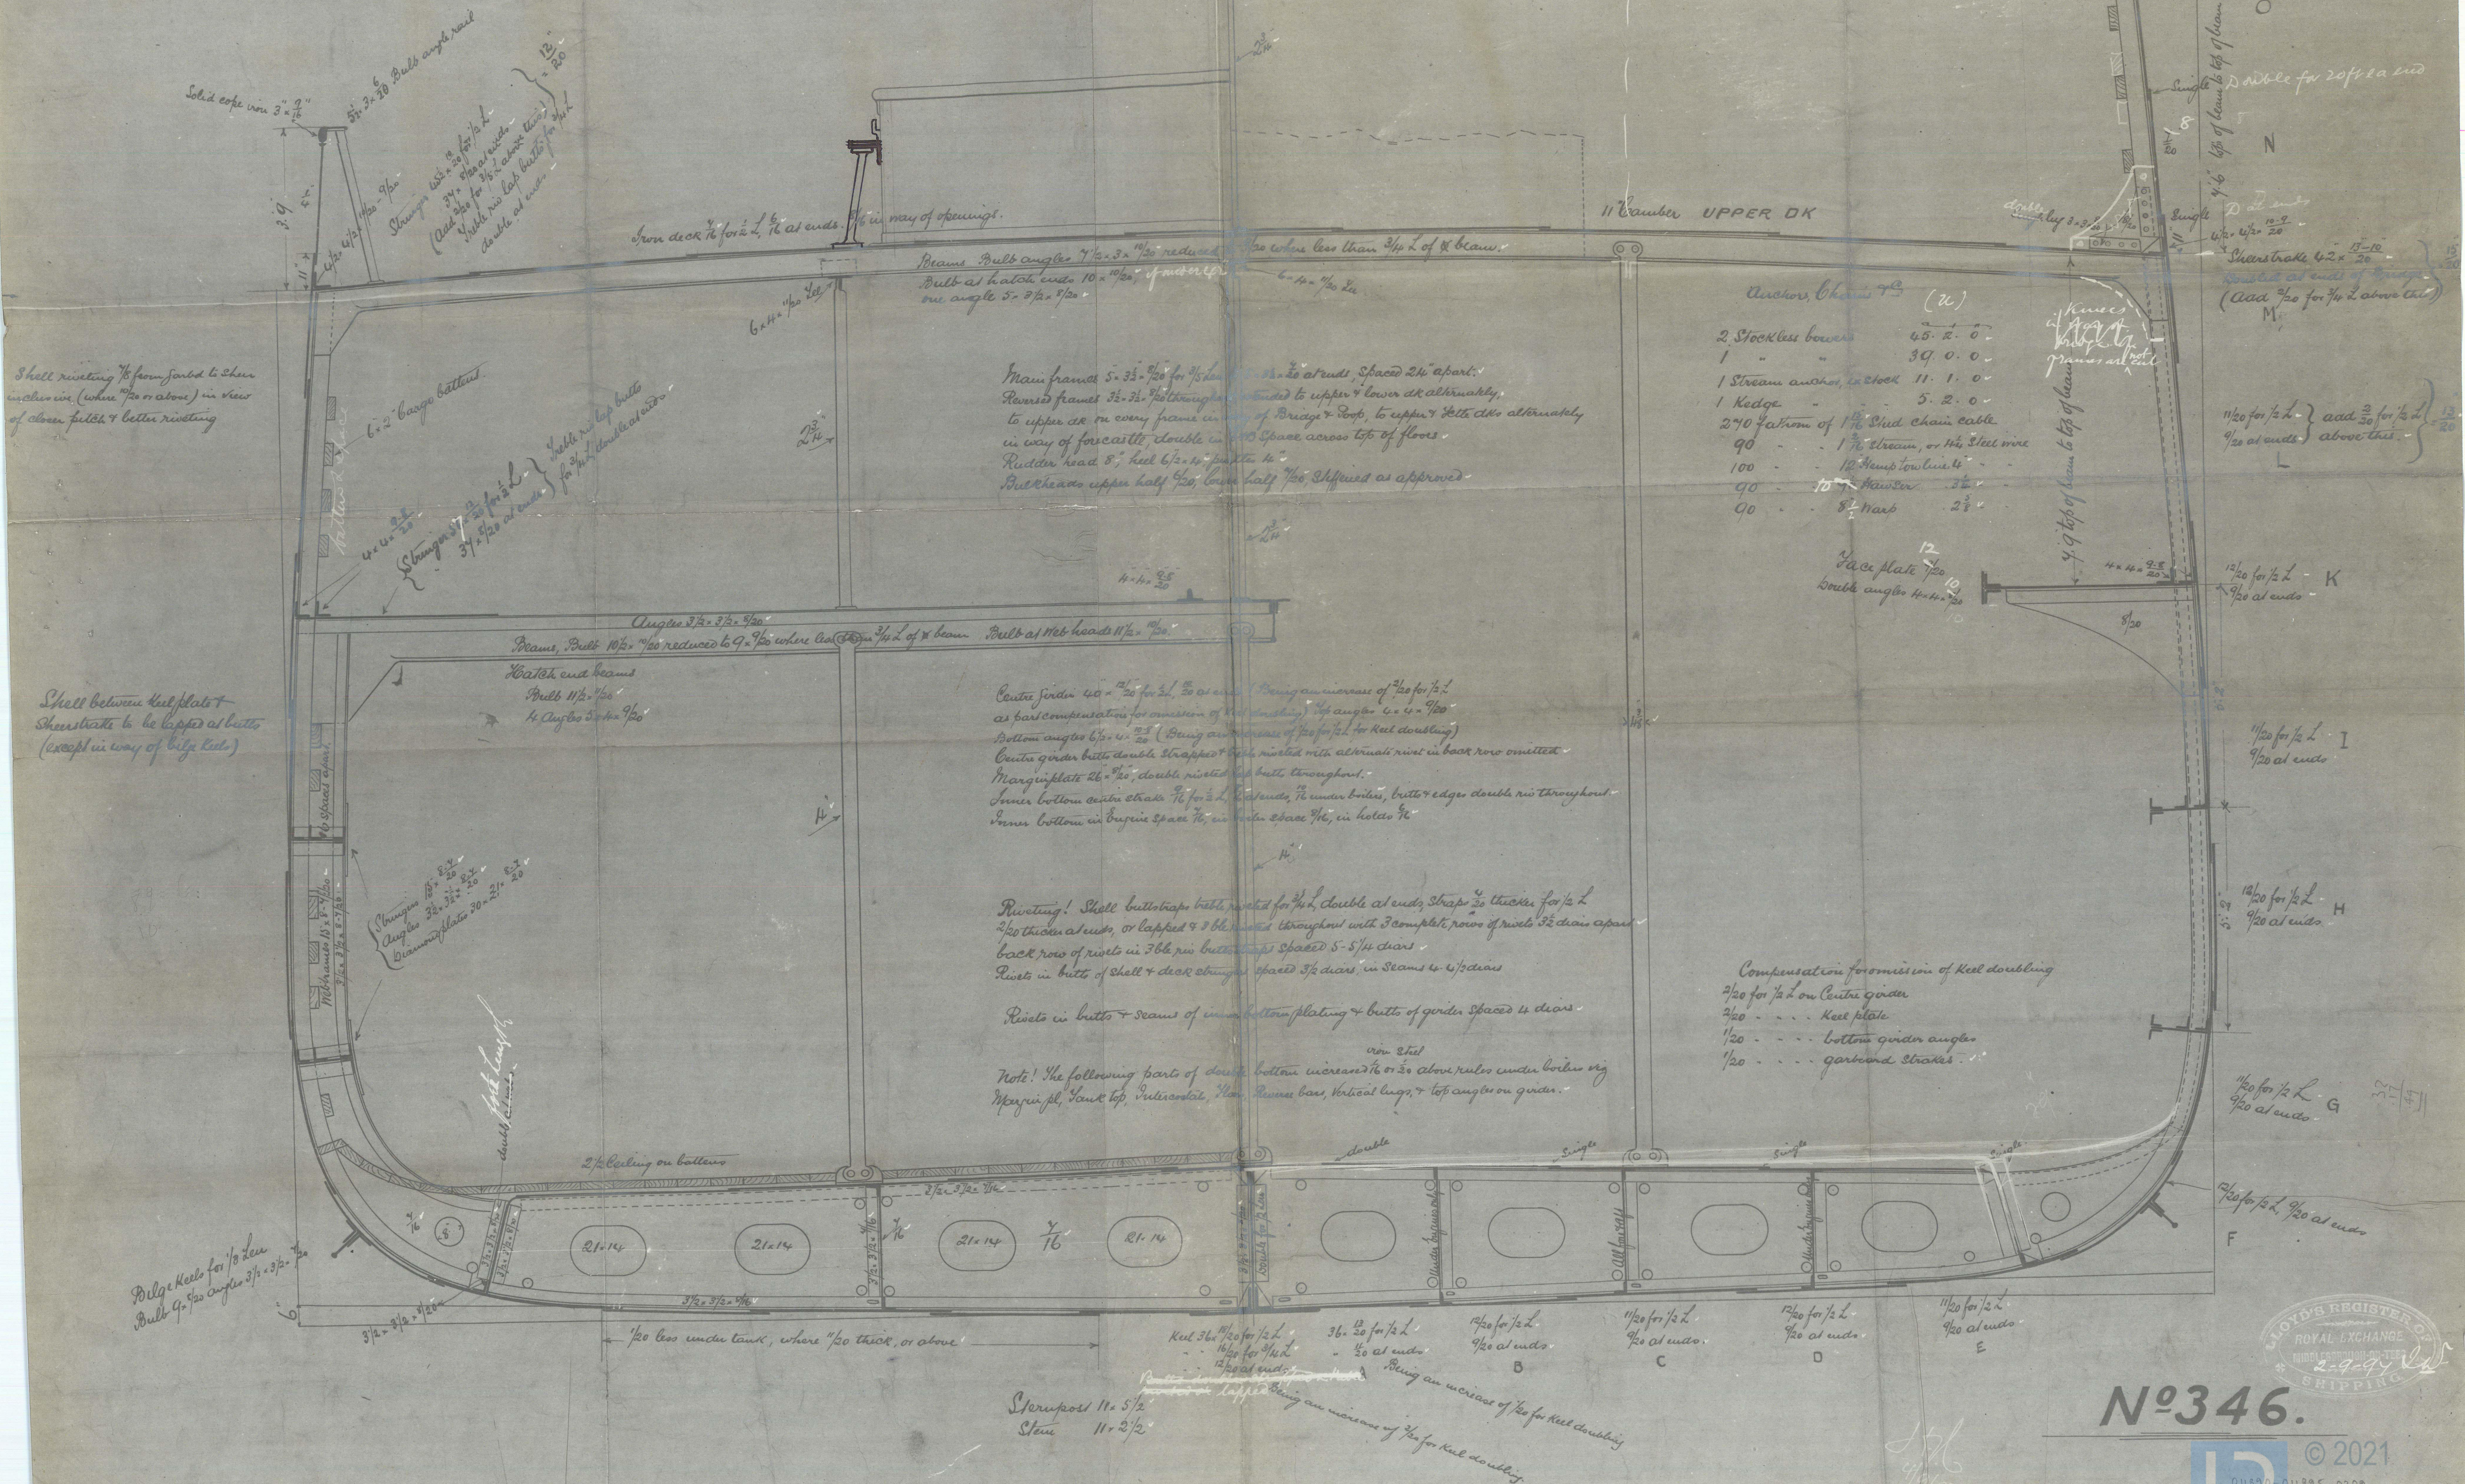



S.S. Danubian  
Midship Section

London

011890-011895-0209

Midship Section  
S.S. Danubian  
Alexandria

18 FEB 1949

Byg

Alexandria 18.2.49

S.S. Danubian / w/ Quater

Midship Section



© 2021

Lloyd's Register  
Foundation



DANUBIAN



© 2021  
Lloyd's Register  
Foundation