

PROFILE & DECK


22 N° 258

SCALE 5" = 1 FOOT


RULE DIMENSIONS 315'0" ON 21'0" MOULDED LWL
 x 45'0" MOULDED
 x 25'4" TO UPPER DX
 TO CLASS 100 A1. LLOYDS.

LENGTH ON ESTIMATED W.L. 315'0"
 DEPTH MOULDED TO UPPER DECK 25'4"
 TONNAGE CORRECT (EOTB) 743 (Reg. 92/102) (30.15.25.6) (File 28-05)
 LENGTH OF ERECTIONS
 CHEEK FOR = 7'0"
 CHEEK AFT = 5'6"
 1/8" FROM STEEN = 46'20"
 1/8" FROM STEM = 23'10"
 MEAN AT 1/8" = 34'65"

FOLLOWING PLANS WILL BE SUBMITTED
 BULKHEADS
 GIRDERS & PILLARS
 CRANTS
 SHELL
 DARTING AREA
 HATCHES
 (Dimensions given in 1/8" & 1/16")

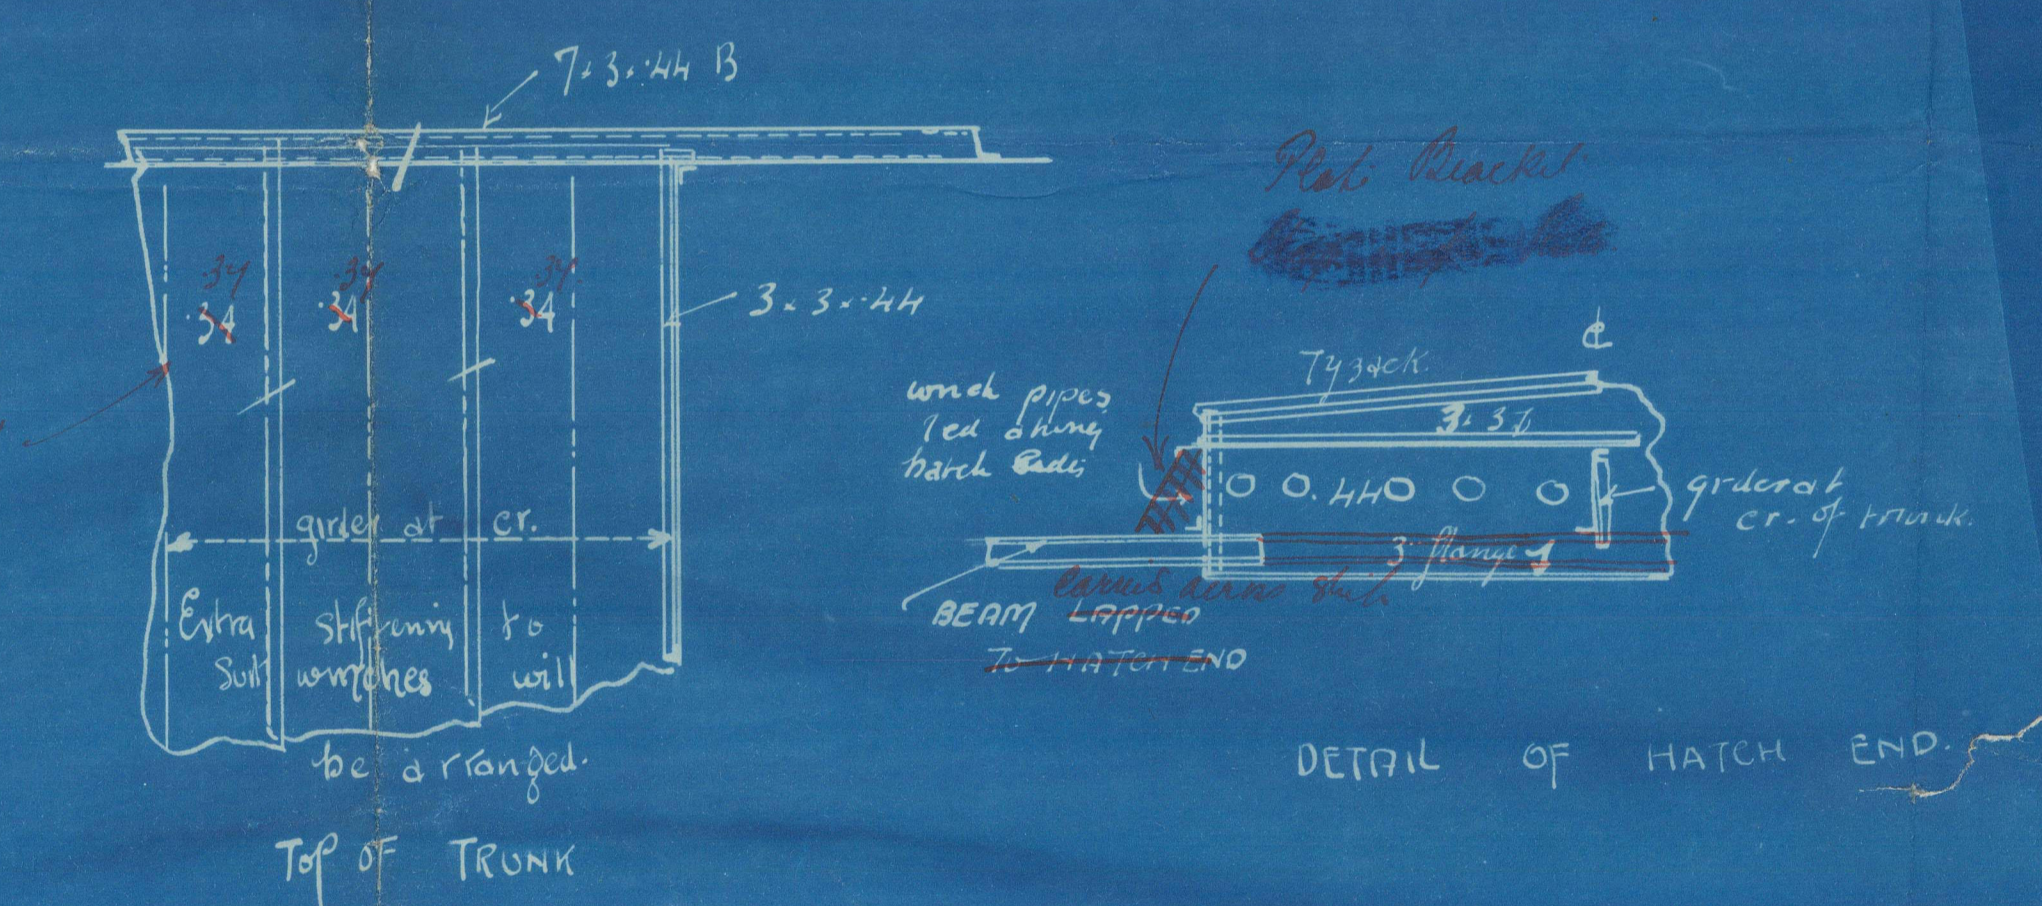

Plan to be submitted to compare with existing & facilitate further.

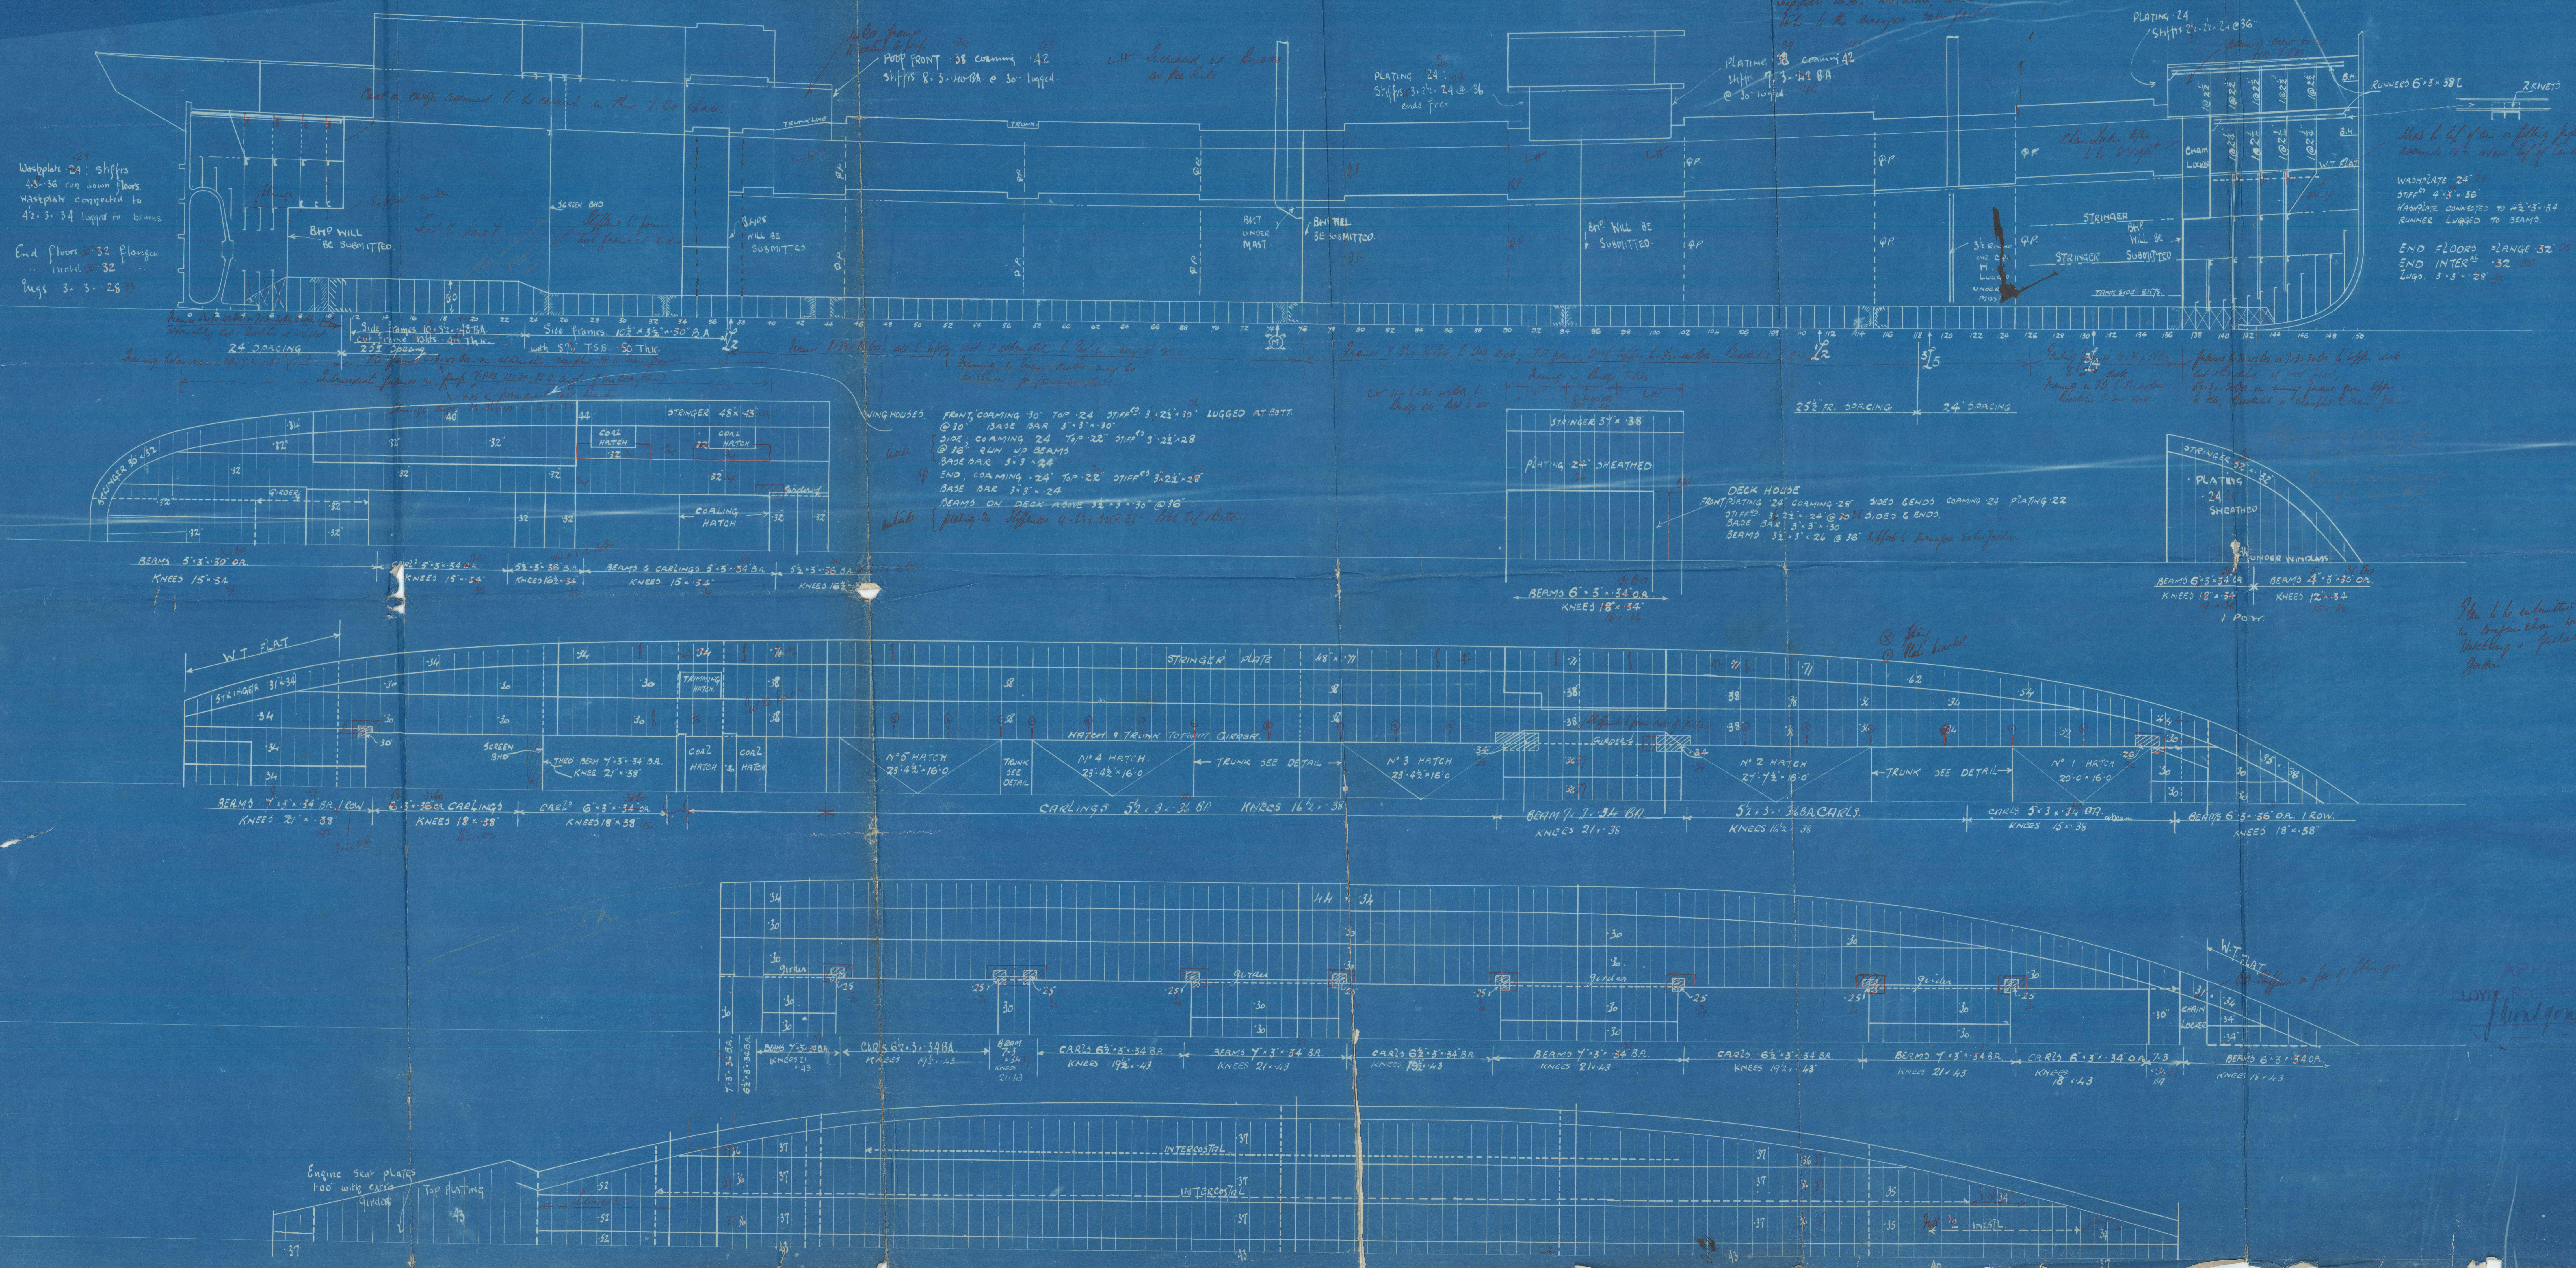

APPROVED
 LLOYD'S REGISTER OF SHIPPING
 14th June 1926

Approved profile

No. 258

Merri Napier & Miller

- S. S. WAIPATA -

San Roberto

GLASGOW REPORT No. 45916

011896-011904-0246



© 2021

Lloyd's Register
Foundation

011996-411904-0246

8/25.57/3



© 2021

Lloyd's Register
Foundation