

DIMENSIONS: LENGTH B.P. 163'2" \* BREADTH M<sup>LD</sup> 21'75" \* DEPTH M<sup>LD</sup> 12'5"





SCALES  $\frac{1}{100}$  &  $\frac{1}{50}$

ALL SECTIONS ARE DRAWN FOR PORT SIDE LOOKING AFT. ✓  
NOTCHES FOR FRAMES ETC. TO BE WELL ROUNDED AND TO HAVE ✓  
SMOOTH EDGES. ✓

WHERE MEMBERS ABUT ON BOTH SIDES OF BULKHEADS OR ON OTHER MEMBERS CARE IS TO BE TAKEN THAT THEY ARE IN ALIGNMENT (D 4905 - 1952 RULES).

NO LIGHTENING HOLES TO BE PUNCHED IN WEB FRAMES OR SIDE STRINGERS.

BEAMS ALLOWED TO "POOP" (SEE NOTE)	100%	SCALLOP SPOUSE	200%	CSC	4%	1
LONGITUDINAL TO UPPER DECK	100%	"	200%	"	45%	1
BEAMS TO INTERDECK PLAT	100%	"	200%	"	5%	2
BEAMS TO BOLLER AND MACHINERY PLAT	100%	"	200%	"	4%	3
STIFFENERS TO INTERDECK BULKHEADS	100%	"	200%	"	5%	2
STIFFENERS TO AISLES	100%	"	200%	"	55%	1
DEPTH OF SCALLOP NOT TO EXCEED 0.25 DEPTH OF BEAM STIFFENERS ON $\frac{1}{16}$ "						
MICHELIERE IN THE LESS.						

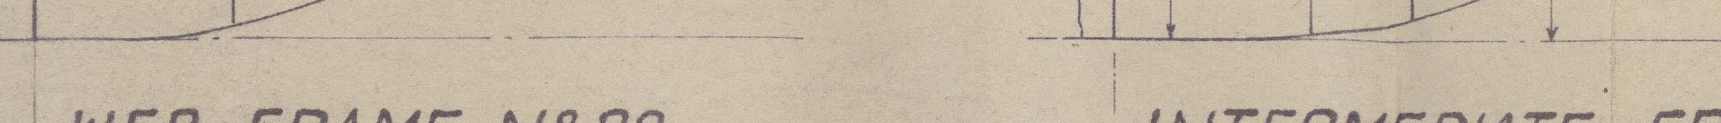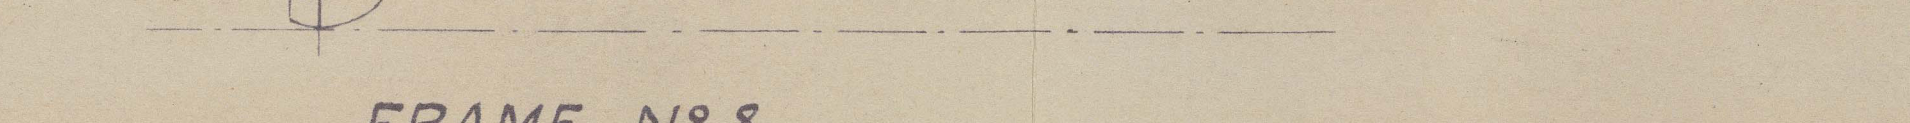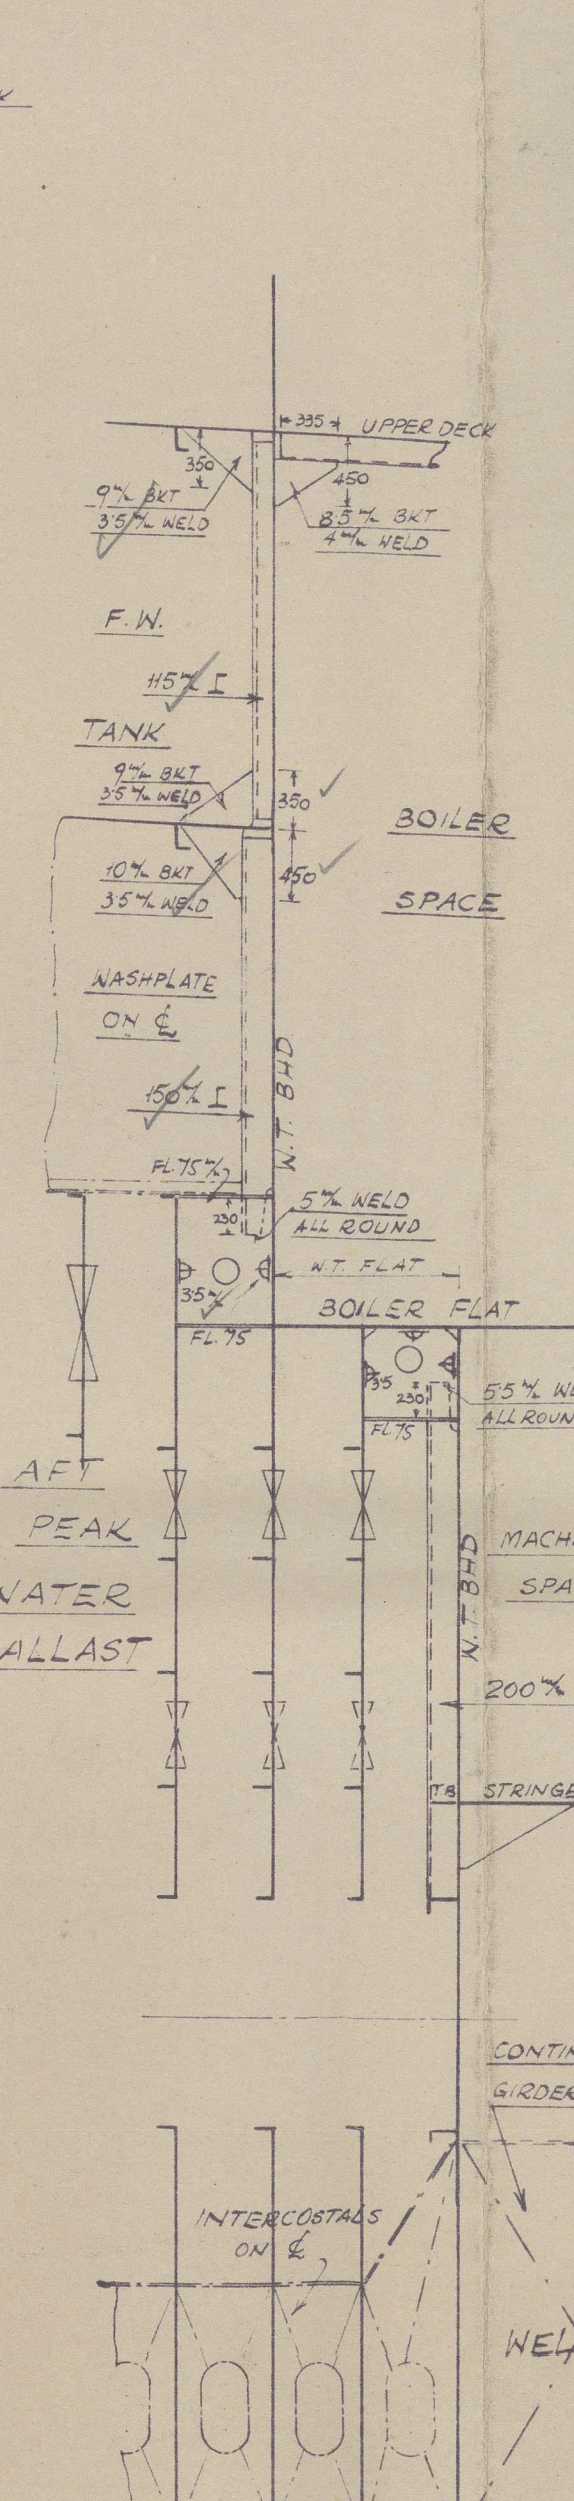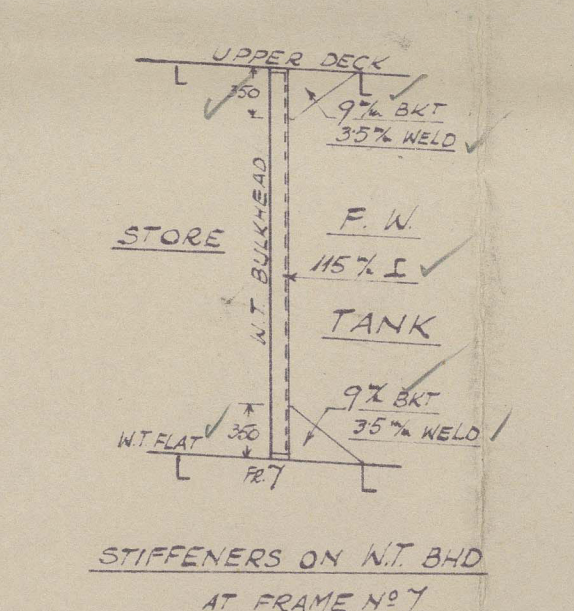

81 JOSEPH W. BISHOP & CO. LTD.  
 4, LLOYD AVENUE,  
 LONDON, E.C.3.  
 DATE 16 JUL 1952

SIR JOSEPH H. ISHERWOOD & CO LTD  
4, LLOYDS AVENUE  
LONDON EC3  
124 DIAN NR 187A/B



17/11  
19"  
aft-end sections

★ AGOSTINO FASSIO

INA

RECORDS DEPT.  
LC

25

CANTIERI NAVALI DI TARANTO

YARD N° 143

AFT END SECTIONS



© 2021

Lloyd's Register  
Foundation

011931-011935-0066