

TO BE ATTACHED
TO KOBÉ REPORT 7282

AYIA MARKELLA

DAMAGE PLAN


FOR

SIDE SHELL & STERN FRAME,
AND RUDDER

gladston

THE HARIMA SHIPBUILDING & ENGINEERING Co., LTD. Aoi Works

INSPECTION SECTION REPAIR SECTION

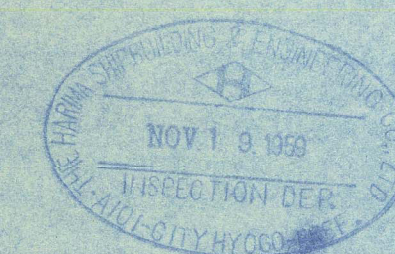

Togata

SCALE H:1 V:2

DATE Nov. 18, 1959

382850-1



© 2021


Lloyd's Register
Foundation

MS " AYIA MARKELLA "

TO ACCOMPANY *Kab.* Rpt. No. 7282

Dated 28/12/59

SUBJECT:- Repairs to skinfame.

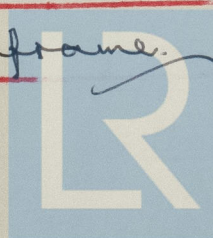

© 2021

Lloyd's Register
Foundation