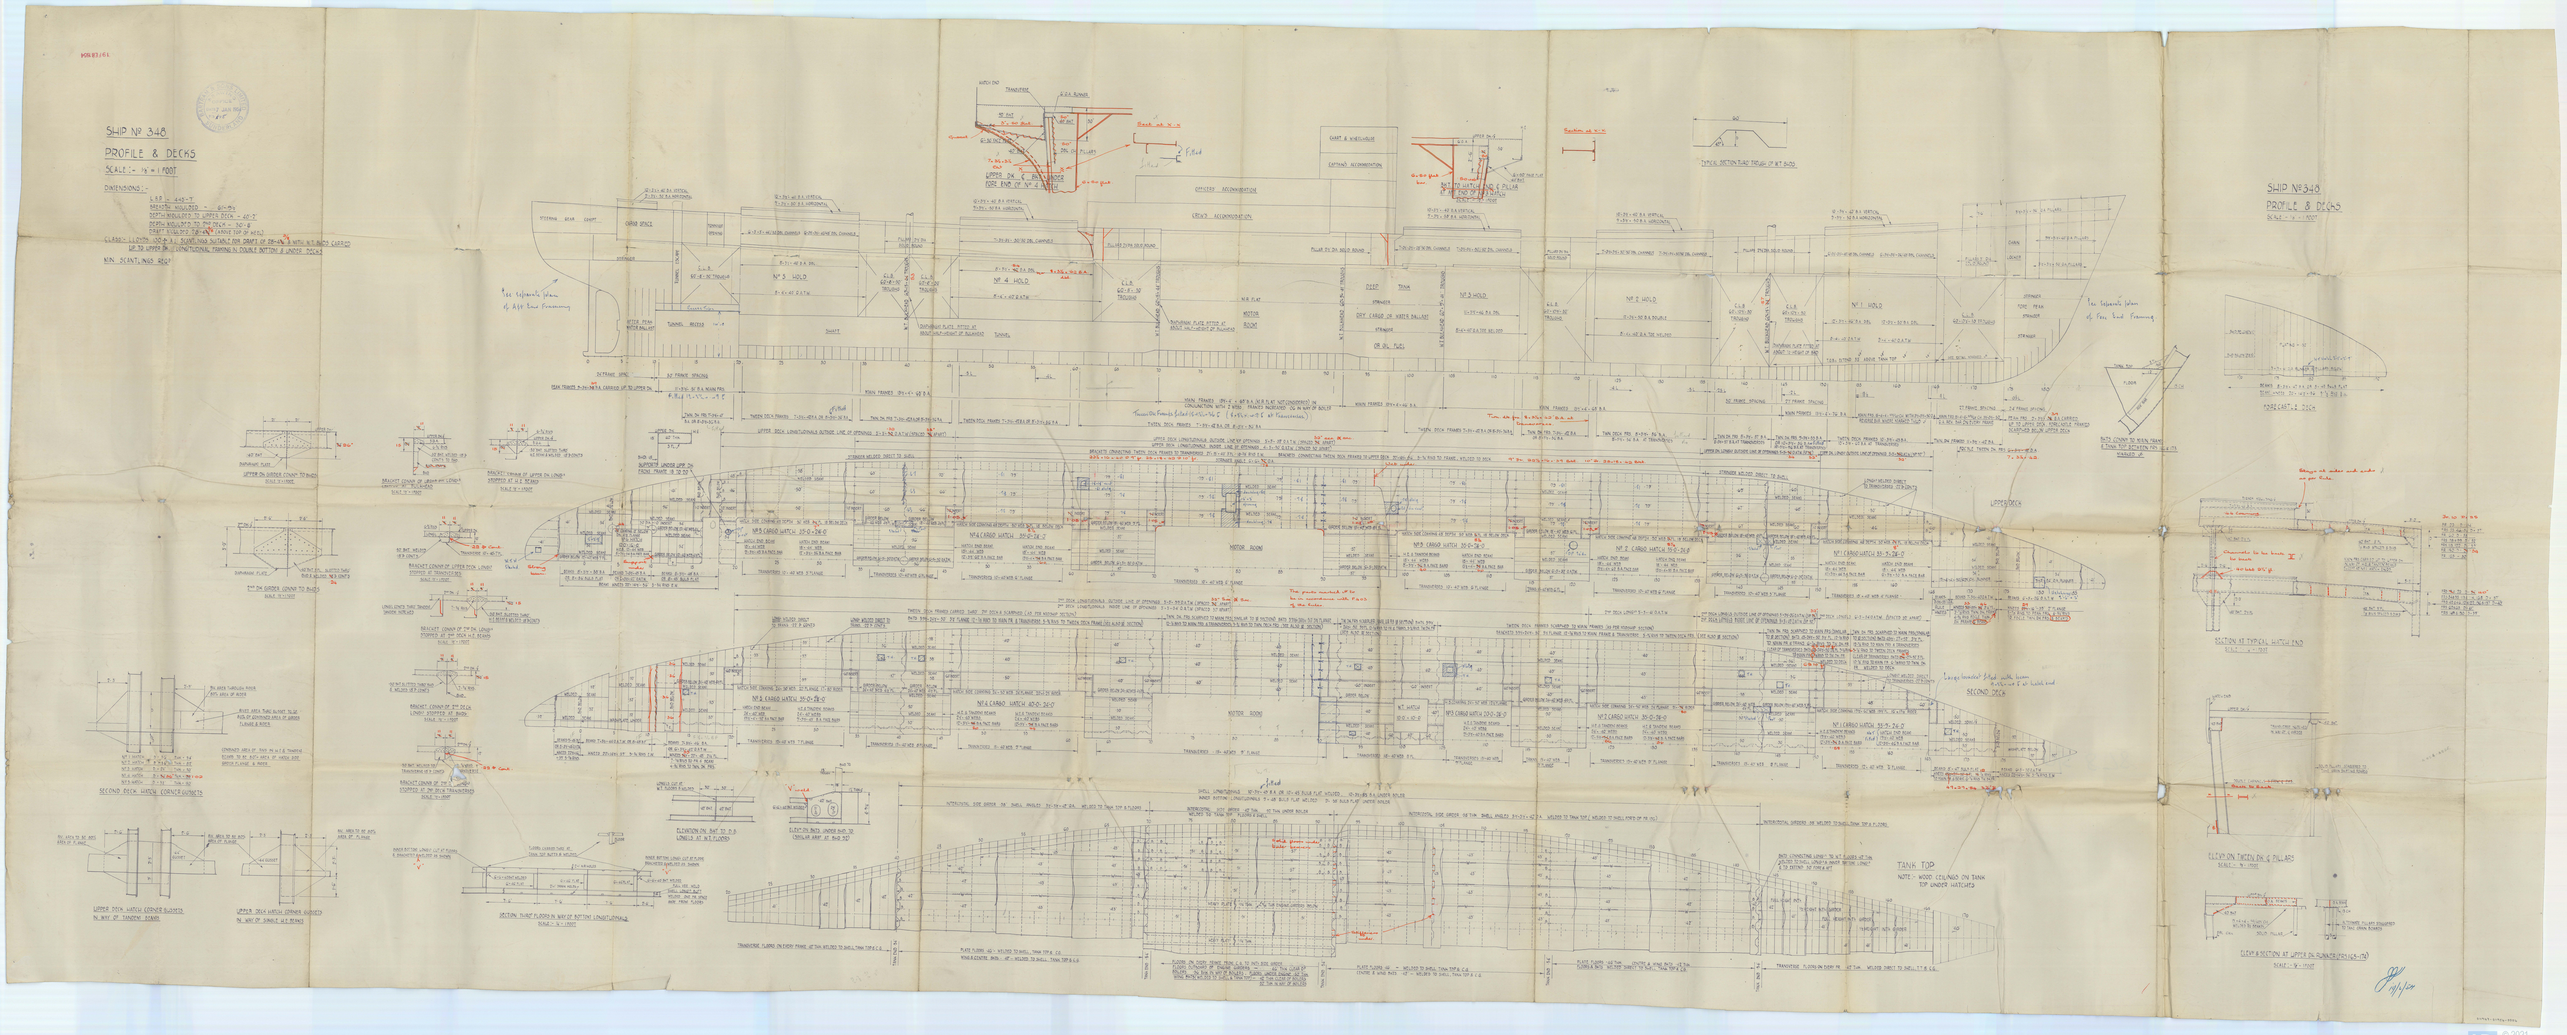
SHIP Nº 348
PROFILE & DECKS
SCALE:- 1/16" = 1 FOOT
DIMENSIONS:-
L.B.P. = 445'-0"
BREADTH MOULDED = 61'-9½"
DEPTH MOULDED TO UPPER DECK = 40'-7"
DEPTH MOULDED TO THIRD DECK = 30'-9"
DRAFT MOULDED TO DWL (SUMMER) = 24'-6"
CLASS:- LLOYDS 100 A1 SHIPS HAVE SUITABLE FOR DRAFTS OF 24'-6" & WITH WELL CARGO
UP TO UPPER DECK CONDITIONAL FRAMING IN DOUBLE BOTTOM & UPPER DECKS
MIN. SCANTLINGS REQ'D
SHIP Nº 348
PROFILE & DECKS
SCALE:- 1/16" = 1 FOOT
FORECASTLE DECK
SECTION AT TYPICAL HATCH END
SECOND DECK
TANK TOP
NOTE:- WOOD CEILING ON TANK TOP UNDER HATCHES
SECOND DECK HATCH CORNER GUSSETS
UPPER DECK HATCH CORNER GUSSETS
SECTION THRU' FLOORS IN WAY OF BOTTOM LONGITUDINALS
ELEVN ON TWEEN DK & PILLARS
ELEVN & SECTION AT UPPER DK RUNNER (FR 51 (C6-17))
Nº 1 HOLD
Nº 2 HOLD
Nº 3 HOLD
Nº 4 HOLD
Nº 5 HOLD
MOTOR ROOM
UPPER DECK
SECOND DECK
TANK TOP

7/S. 878

Bartrams No. 348.
Profile & Decks.

"As fitted" amendments in blue.

MOTORSHIP 'AYIA MARKELLA'

FREEBOARD
SUNDERLAND RPT. NO. 36451

M/V 'AYIA MARKELLA'
YARD NO 348
SLD RPT NO.36482

RECORDS DEPT.
LONDON.

2

© 2021
Lloyd's Register
Foundation

011947-011954-0004