



8041 NAR 1 006  
 16.6.48

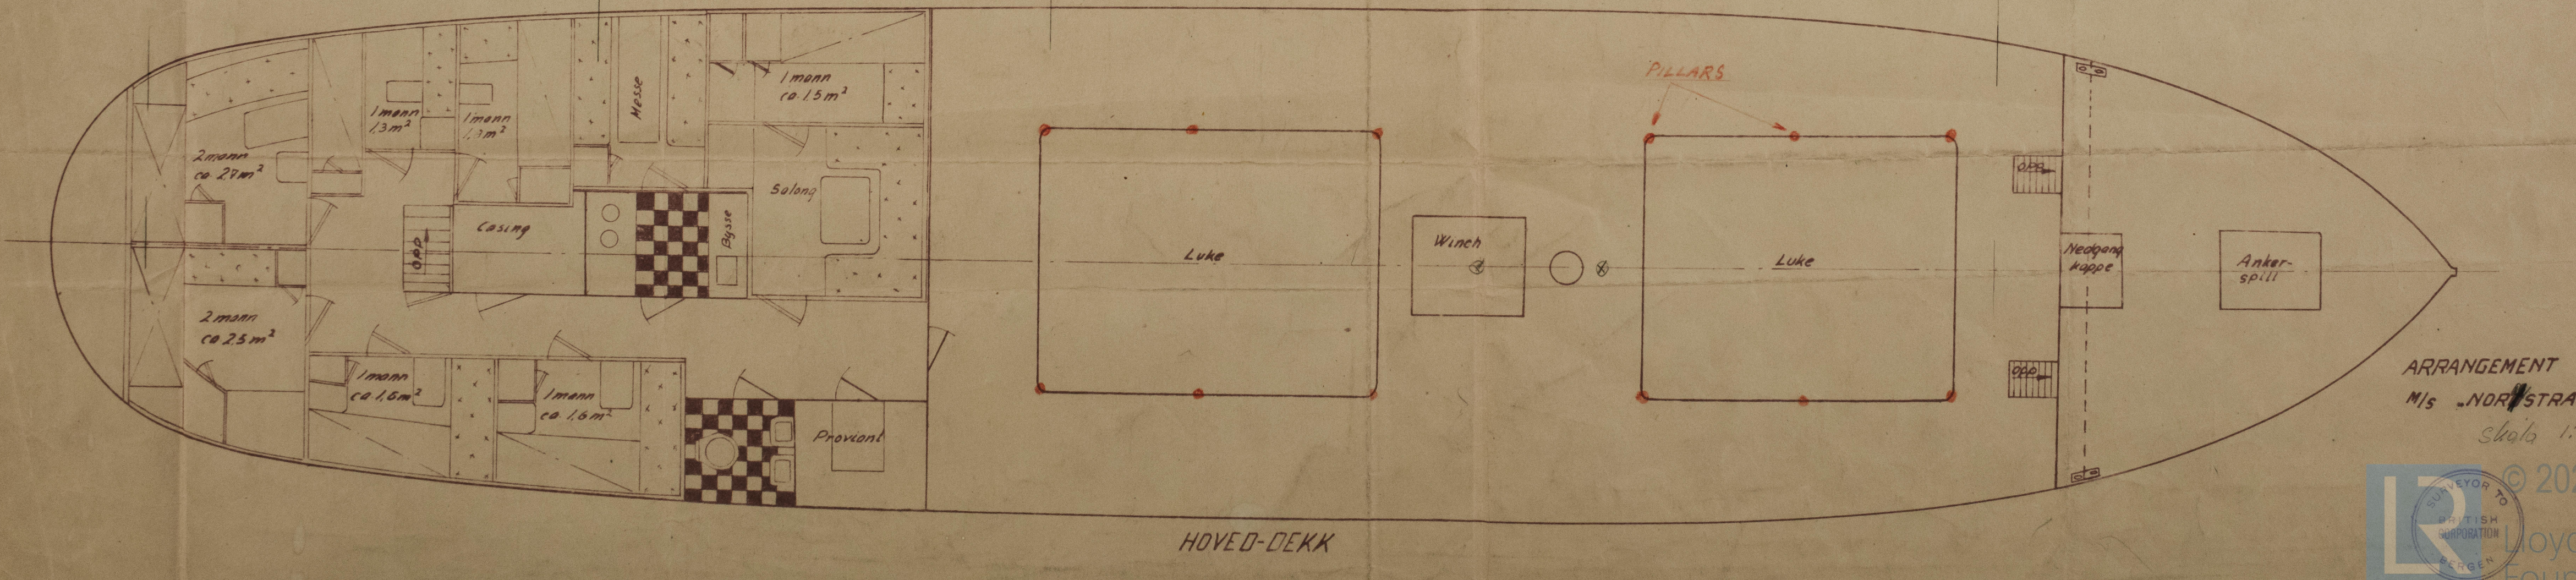

ARRANGEMENT  
 M/S "NORSTRAUM"  
 skala 1:50

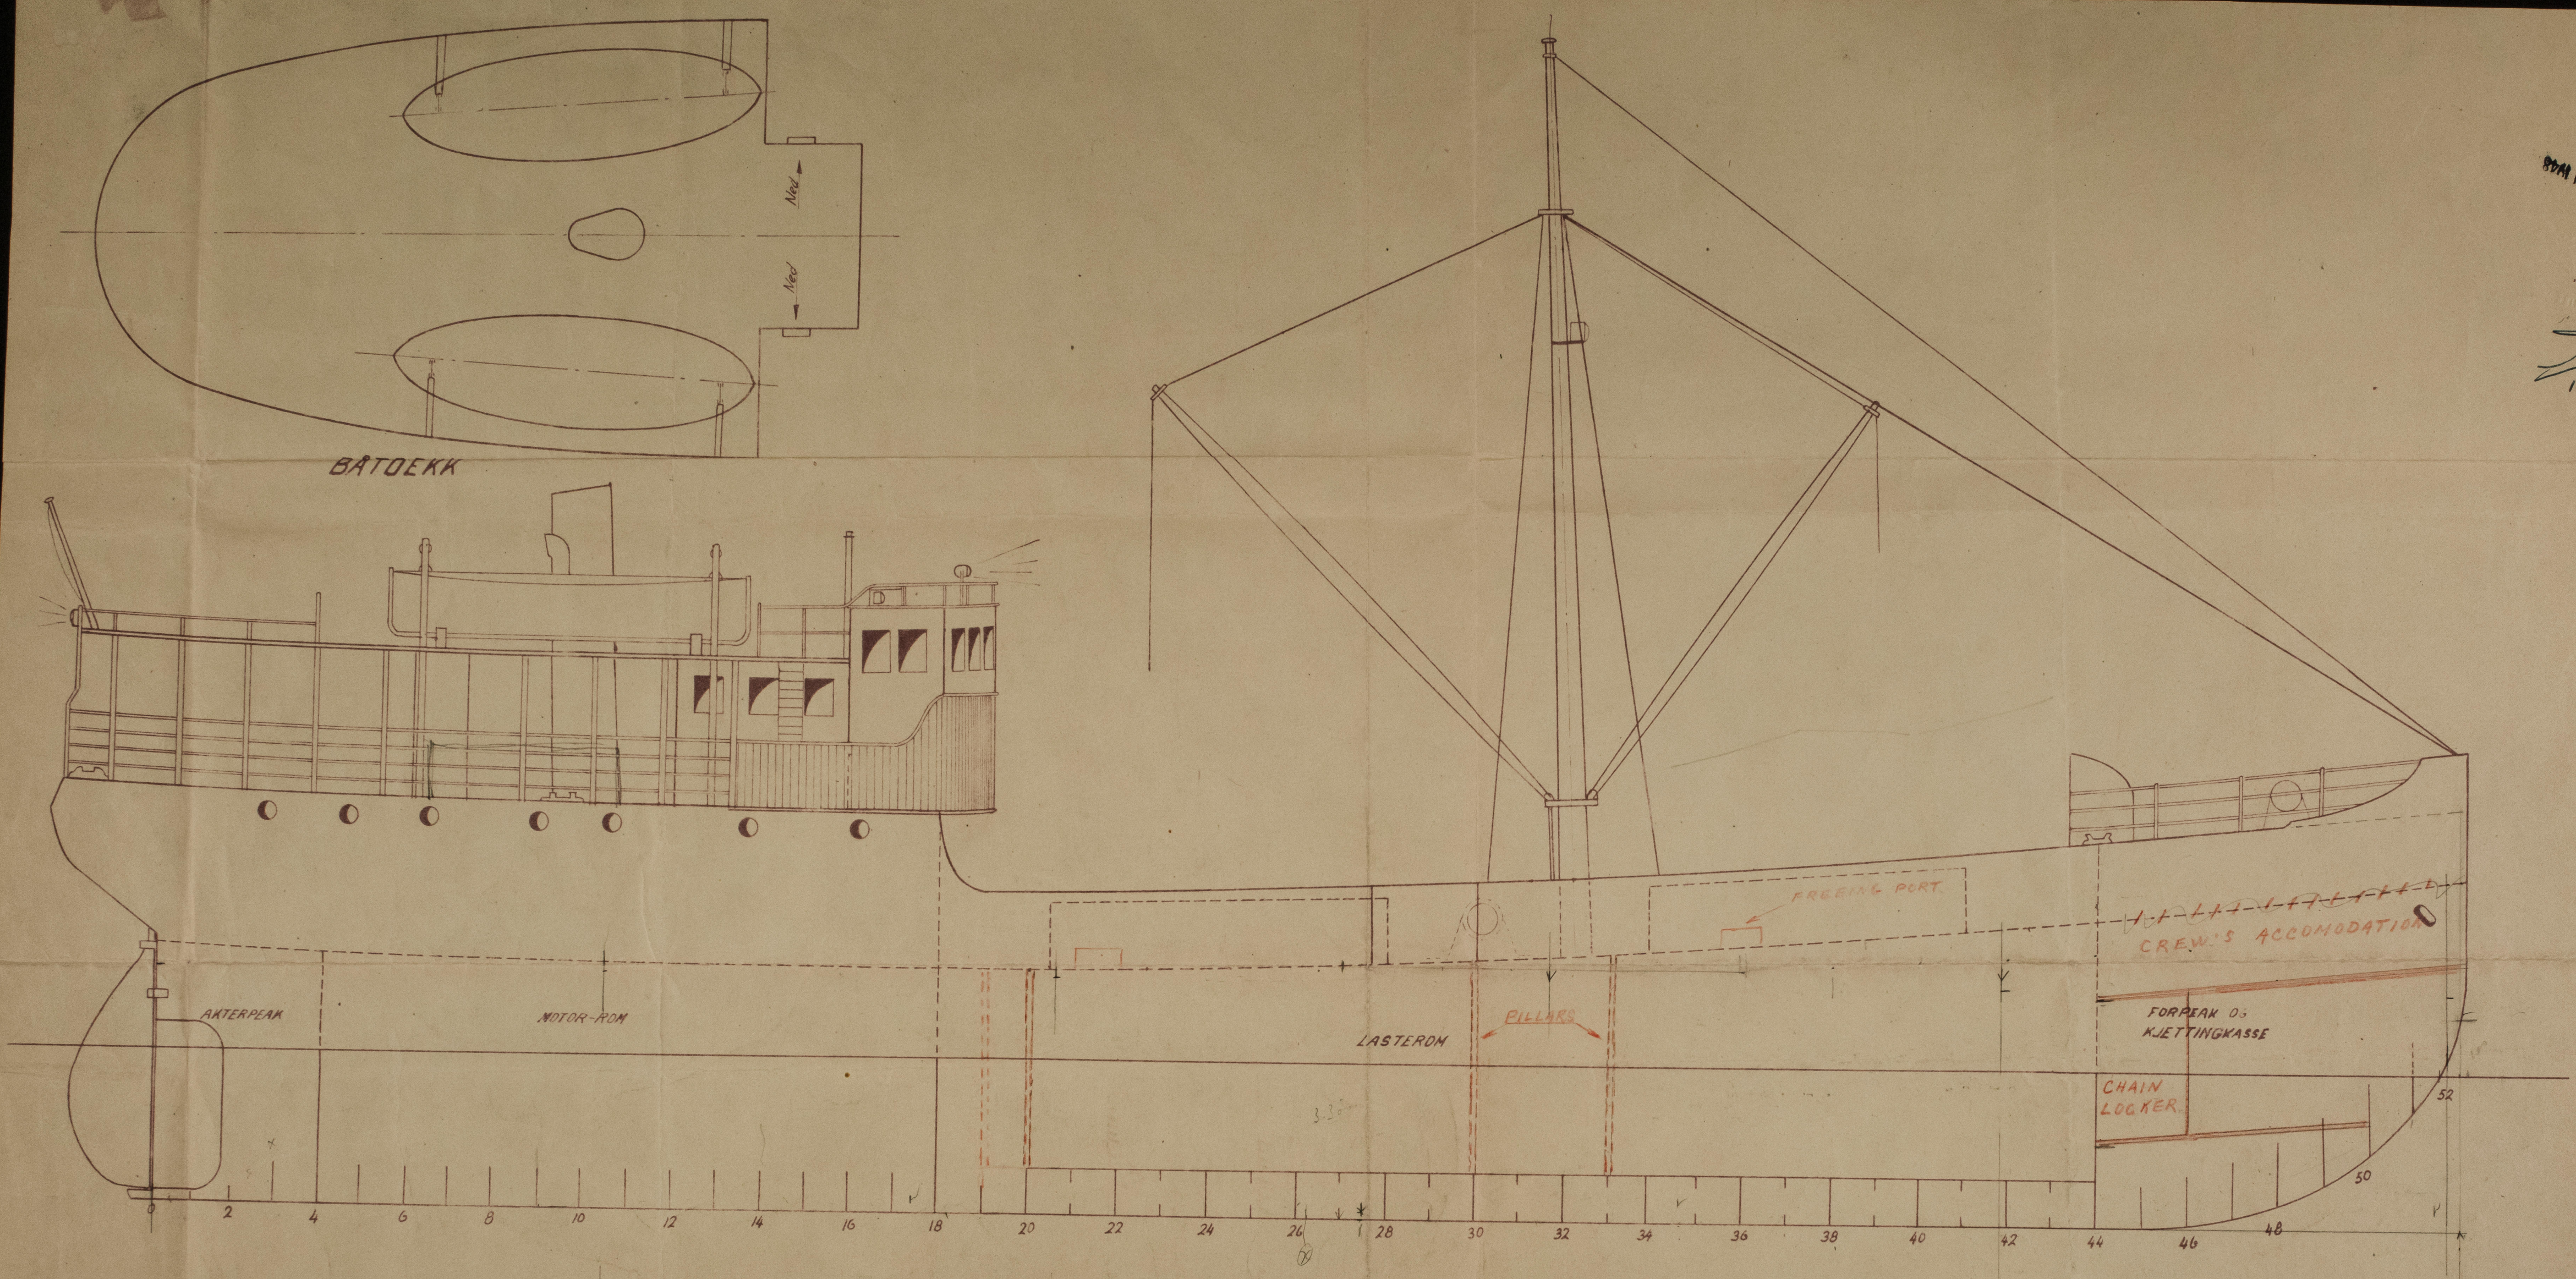

B

General Argt

52 NORSTRAUM. ★

Bergen. 11.6.48.

RECORDS DEPT.,  
LONDON

4

79

1 JUN 1948

Bergen

S/n Norstrum

General Argt.

5

011947-011954-0045



© 2021  
Lloyd's Register  
Foundation