
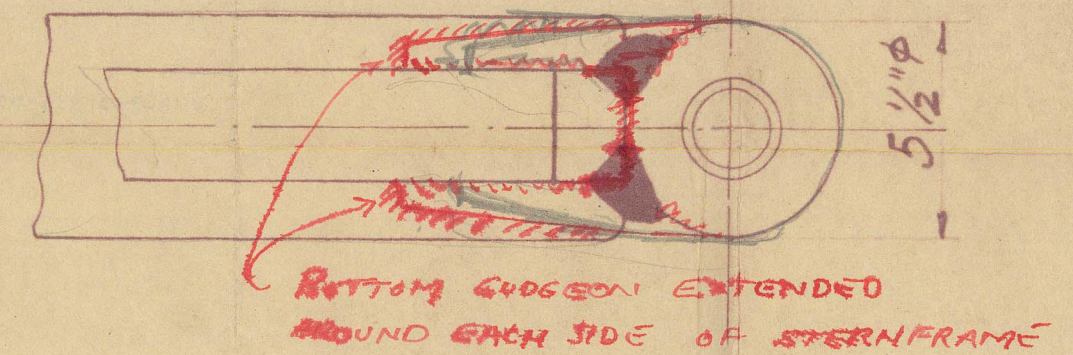
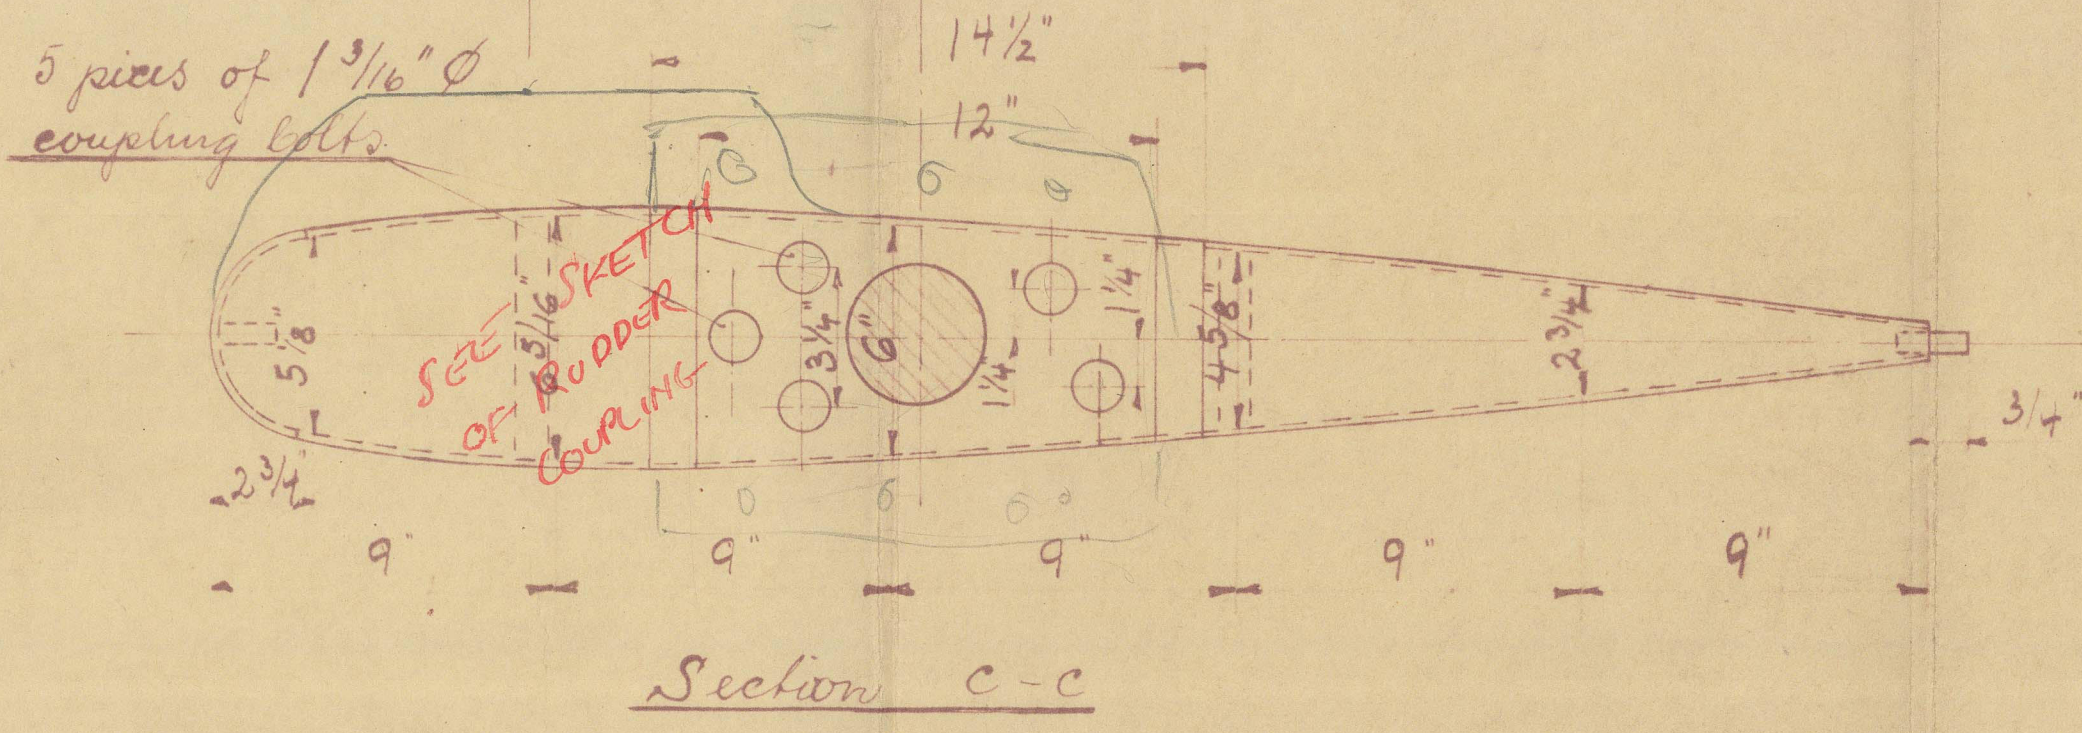
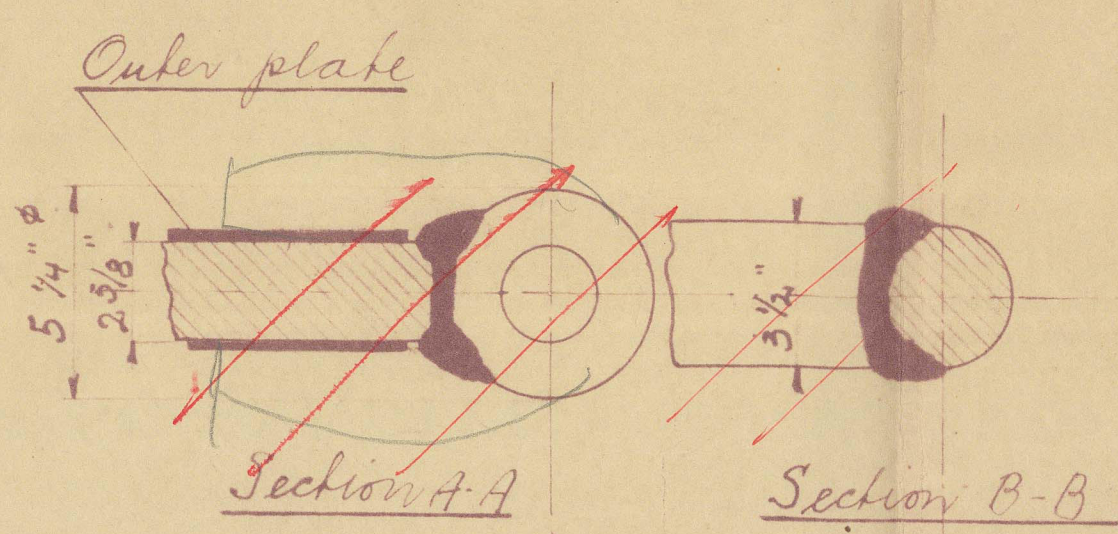
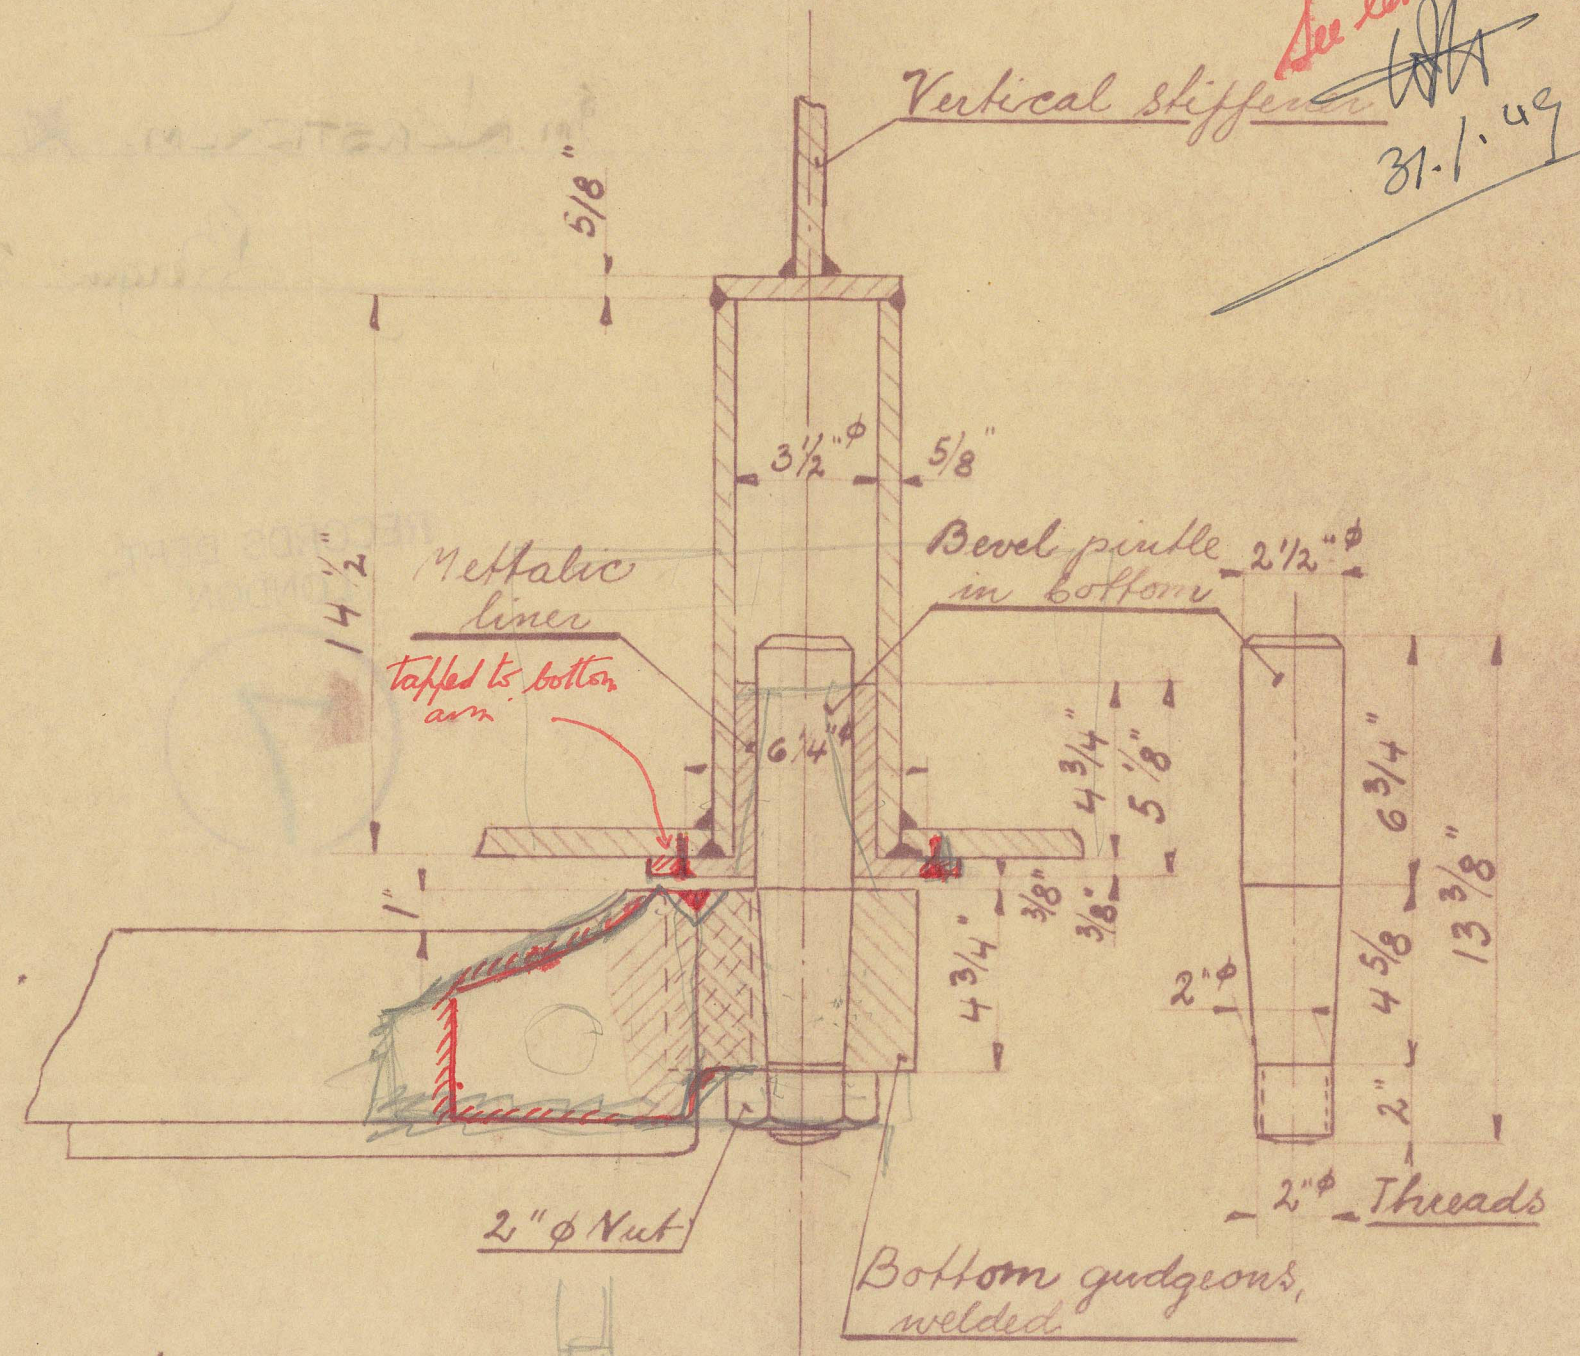


- 5 JAN 1949

606

See letter
31.1.49

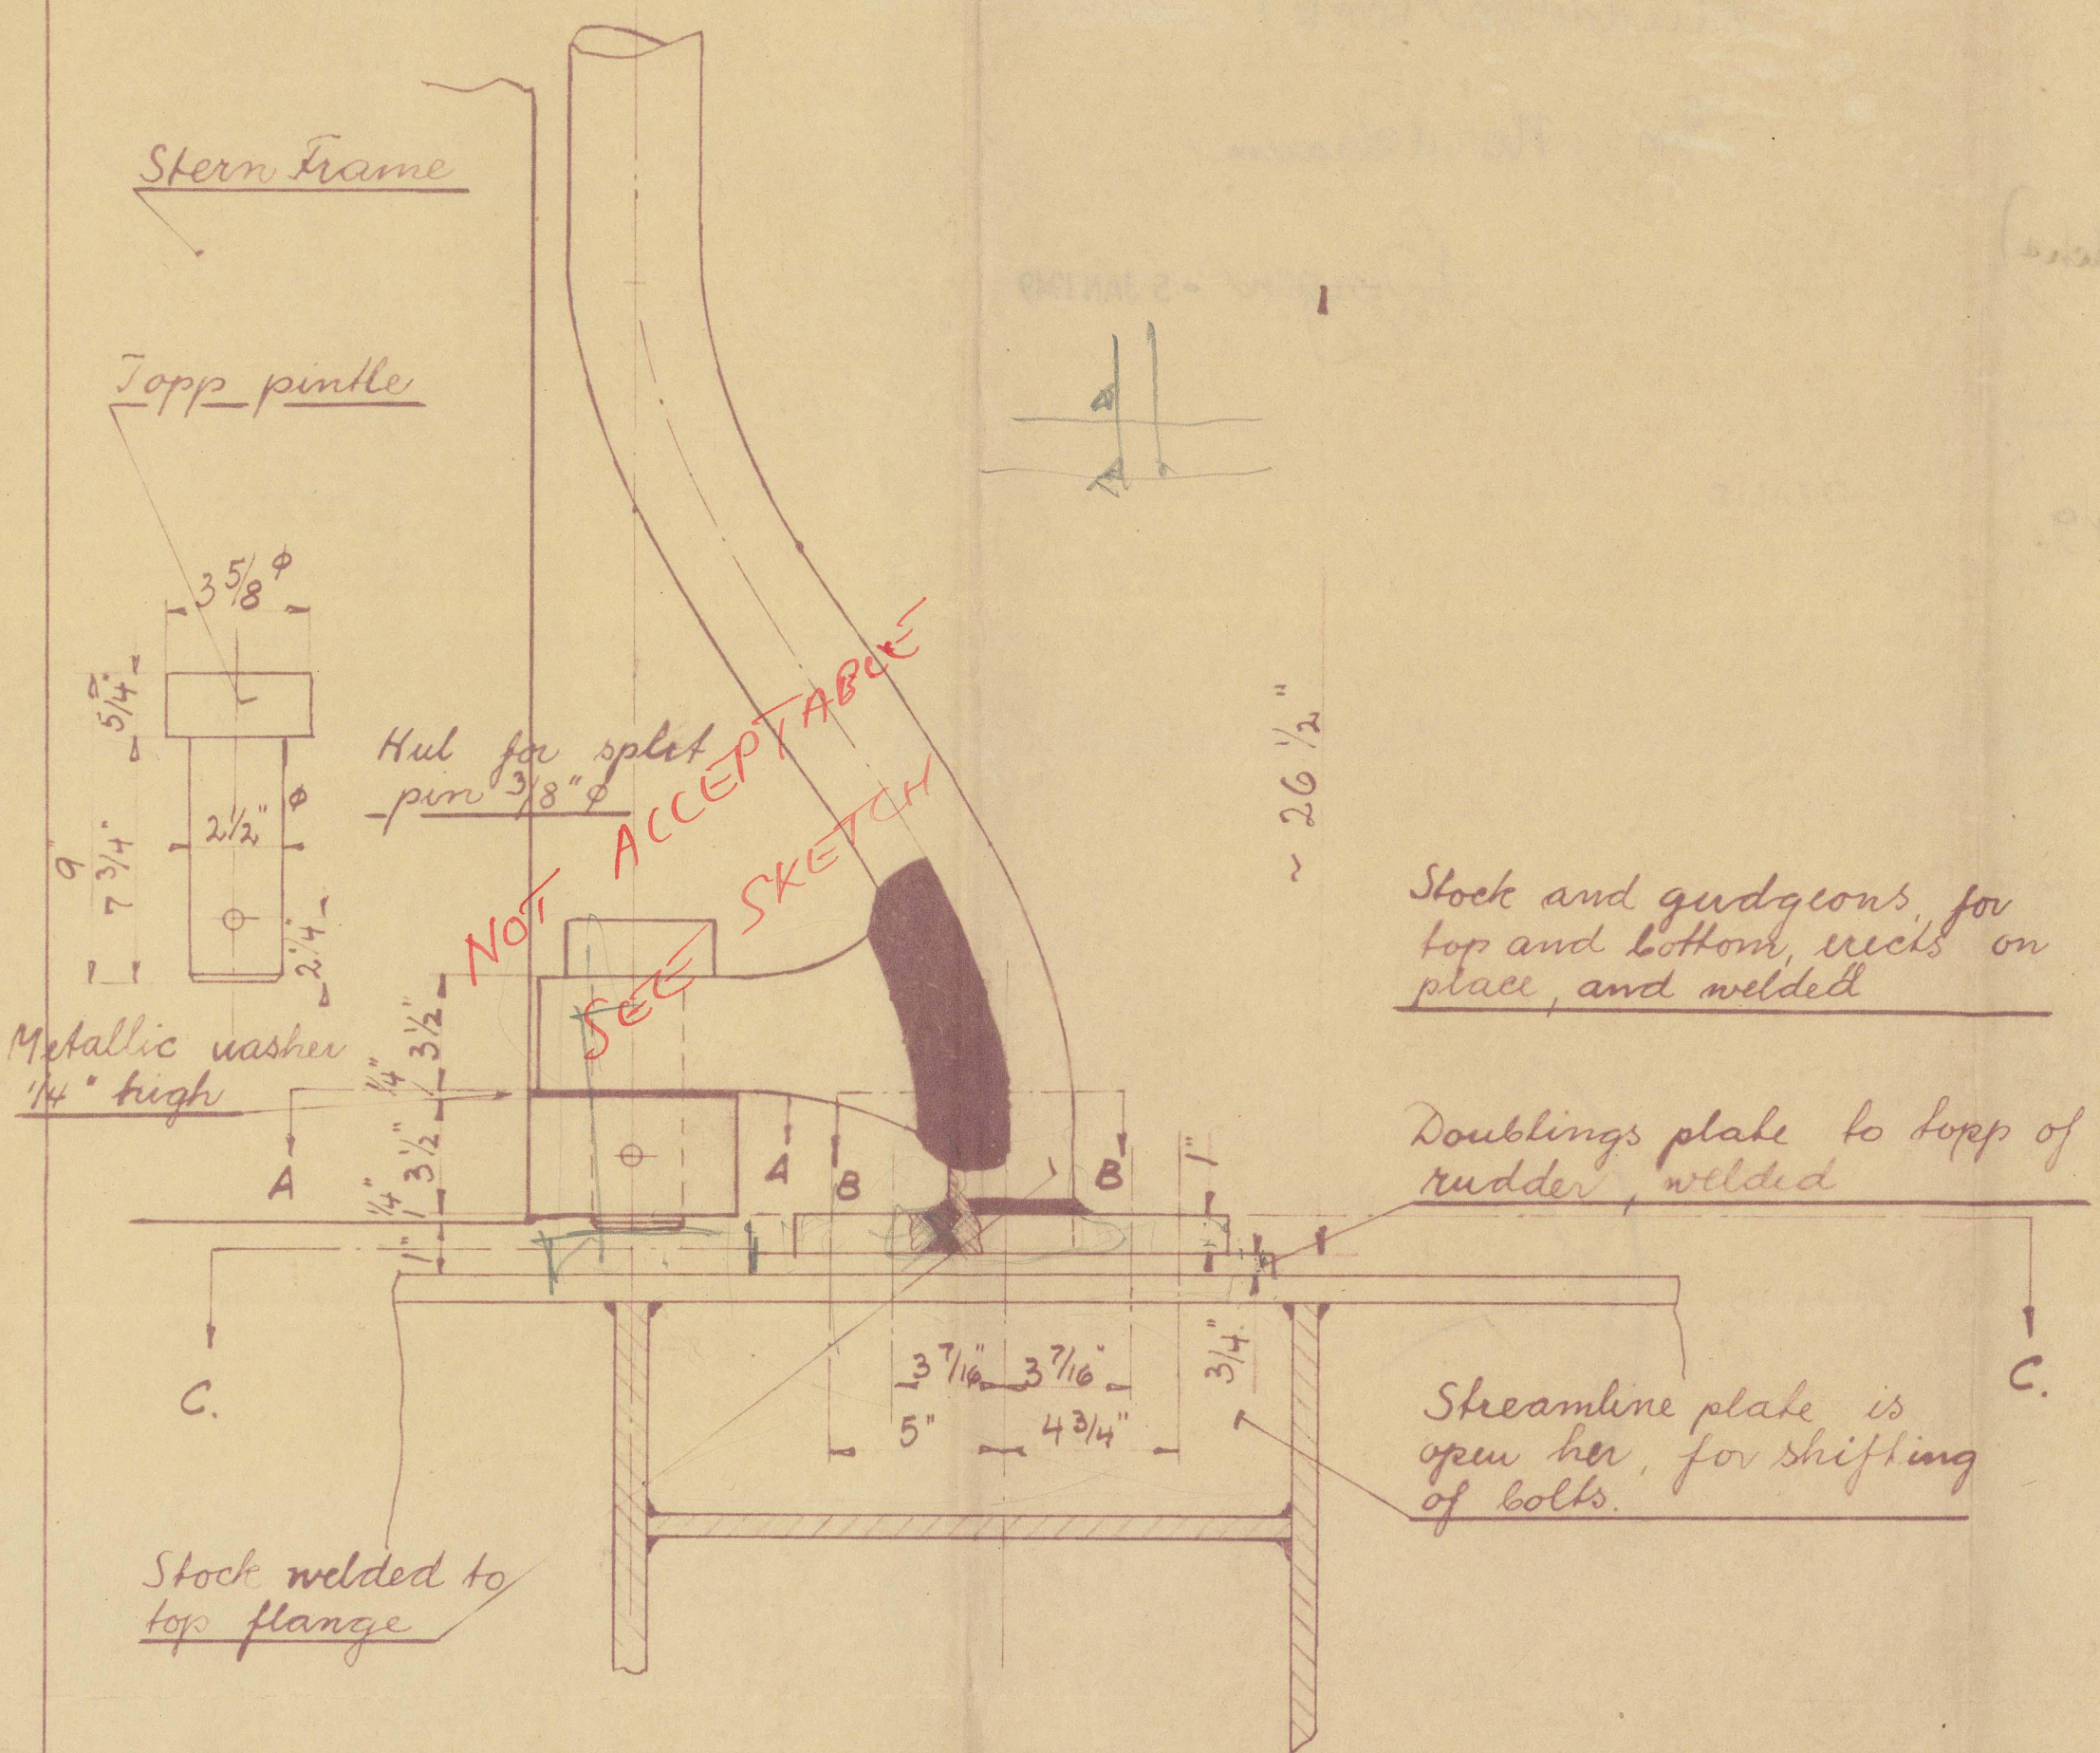

M/S NORDSTRAUM.

BALANCED RUDDER

M.1.5

BERGEN 15-12-48



2

OZALID

Rudder Stock - (B.L. Sketch attcha)

S/M NORSTRAUM. ★

Bergen 21.1.49.

RECORDS DEPT.,
LONDON

7

OZALID

011947-011954-0048

Rudder Stock

OZALID

S/M Nordstraum

Bergen - 5 JAN 1949

OZALID

R

OZALID

OZALID



© 2021

Lloyd's Register
Foundation