



PROFILE & DECK PLAN

STEEL TWIN-SCREW STEAM TUGBOATS

Nos 1079-'80

110' 0" B.P. x 26' 0" MLD. x 10' 0" MLD.

TO CLASS A.1. FOR TOWING SERVICES
(ON RIVERS PARANA & PARAGUAY)

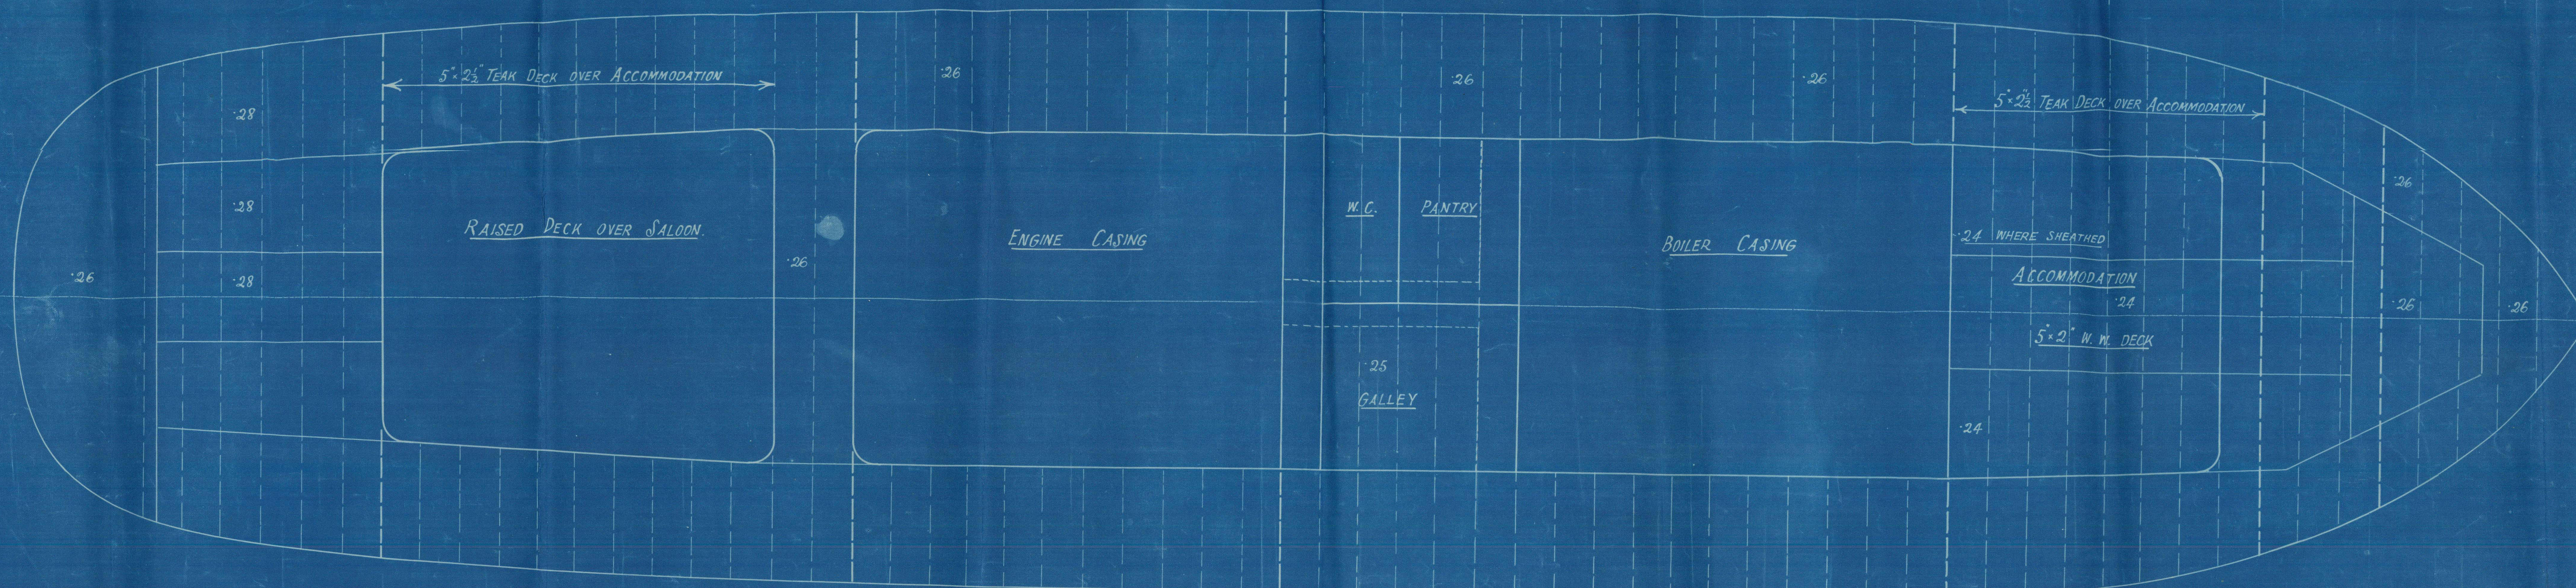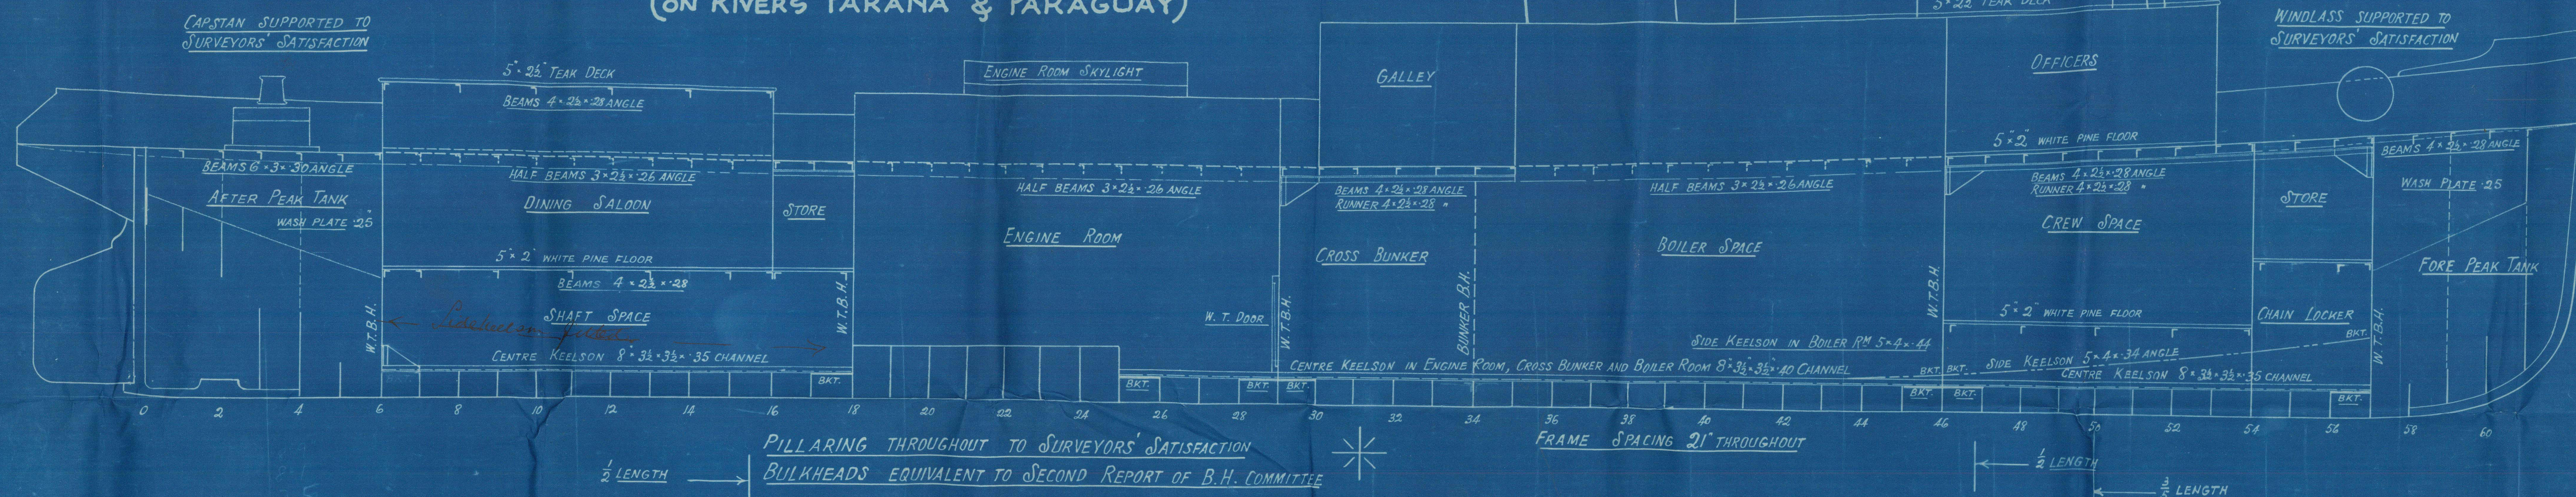

Scale 1/4" = 1 foot

No 1079

Profile & Deck (as built)

Cochrane & Sons Ltd.

S.S. "Salvador"

HULL REPORT No. 40969

PLANS TRANSFERRED
TO SISTER VESSEL

Superior
L/Bow 11.3