

SHIPS Nos 328.

PROFILE & DECKS.

SCALE: 1/8" = ONE FOOT.


DIMENSIONS:— LENGTH L.W.L. 257'-0"; BREADTH MLD. 39'-4"; DEPTH MLD. 18'-6" U.D.K., 22'-6" R.Q.D.K.

CLASS LLOYDS + 100 A.I.

ALL BULB ANGLES ARE N.B.S.

MASTS, WINDLASS, WINCHES, STEERING GEAR,
AND DECK HOUSES, SUPPORTED TO
SURVEYOR'S SATISFACTION.

*X bulk changed to be supported
direct to hull's skeleton*

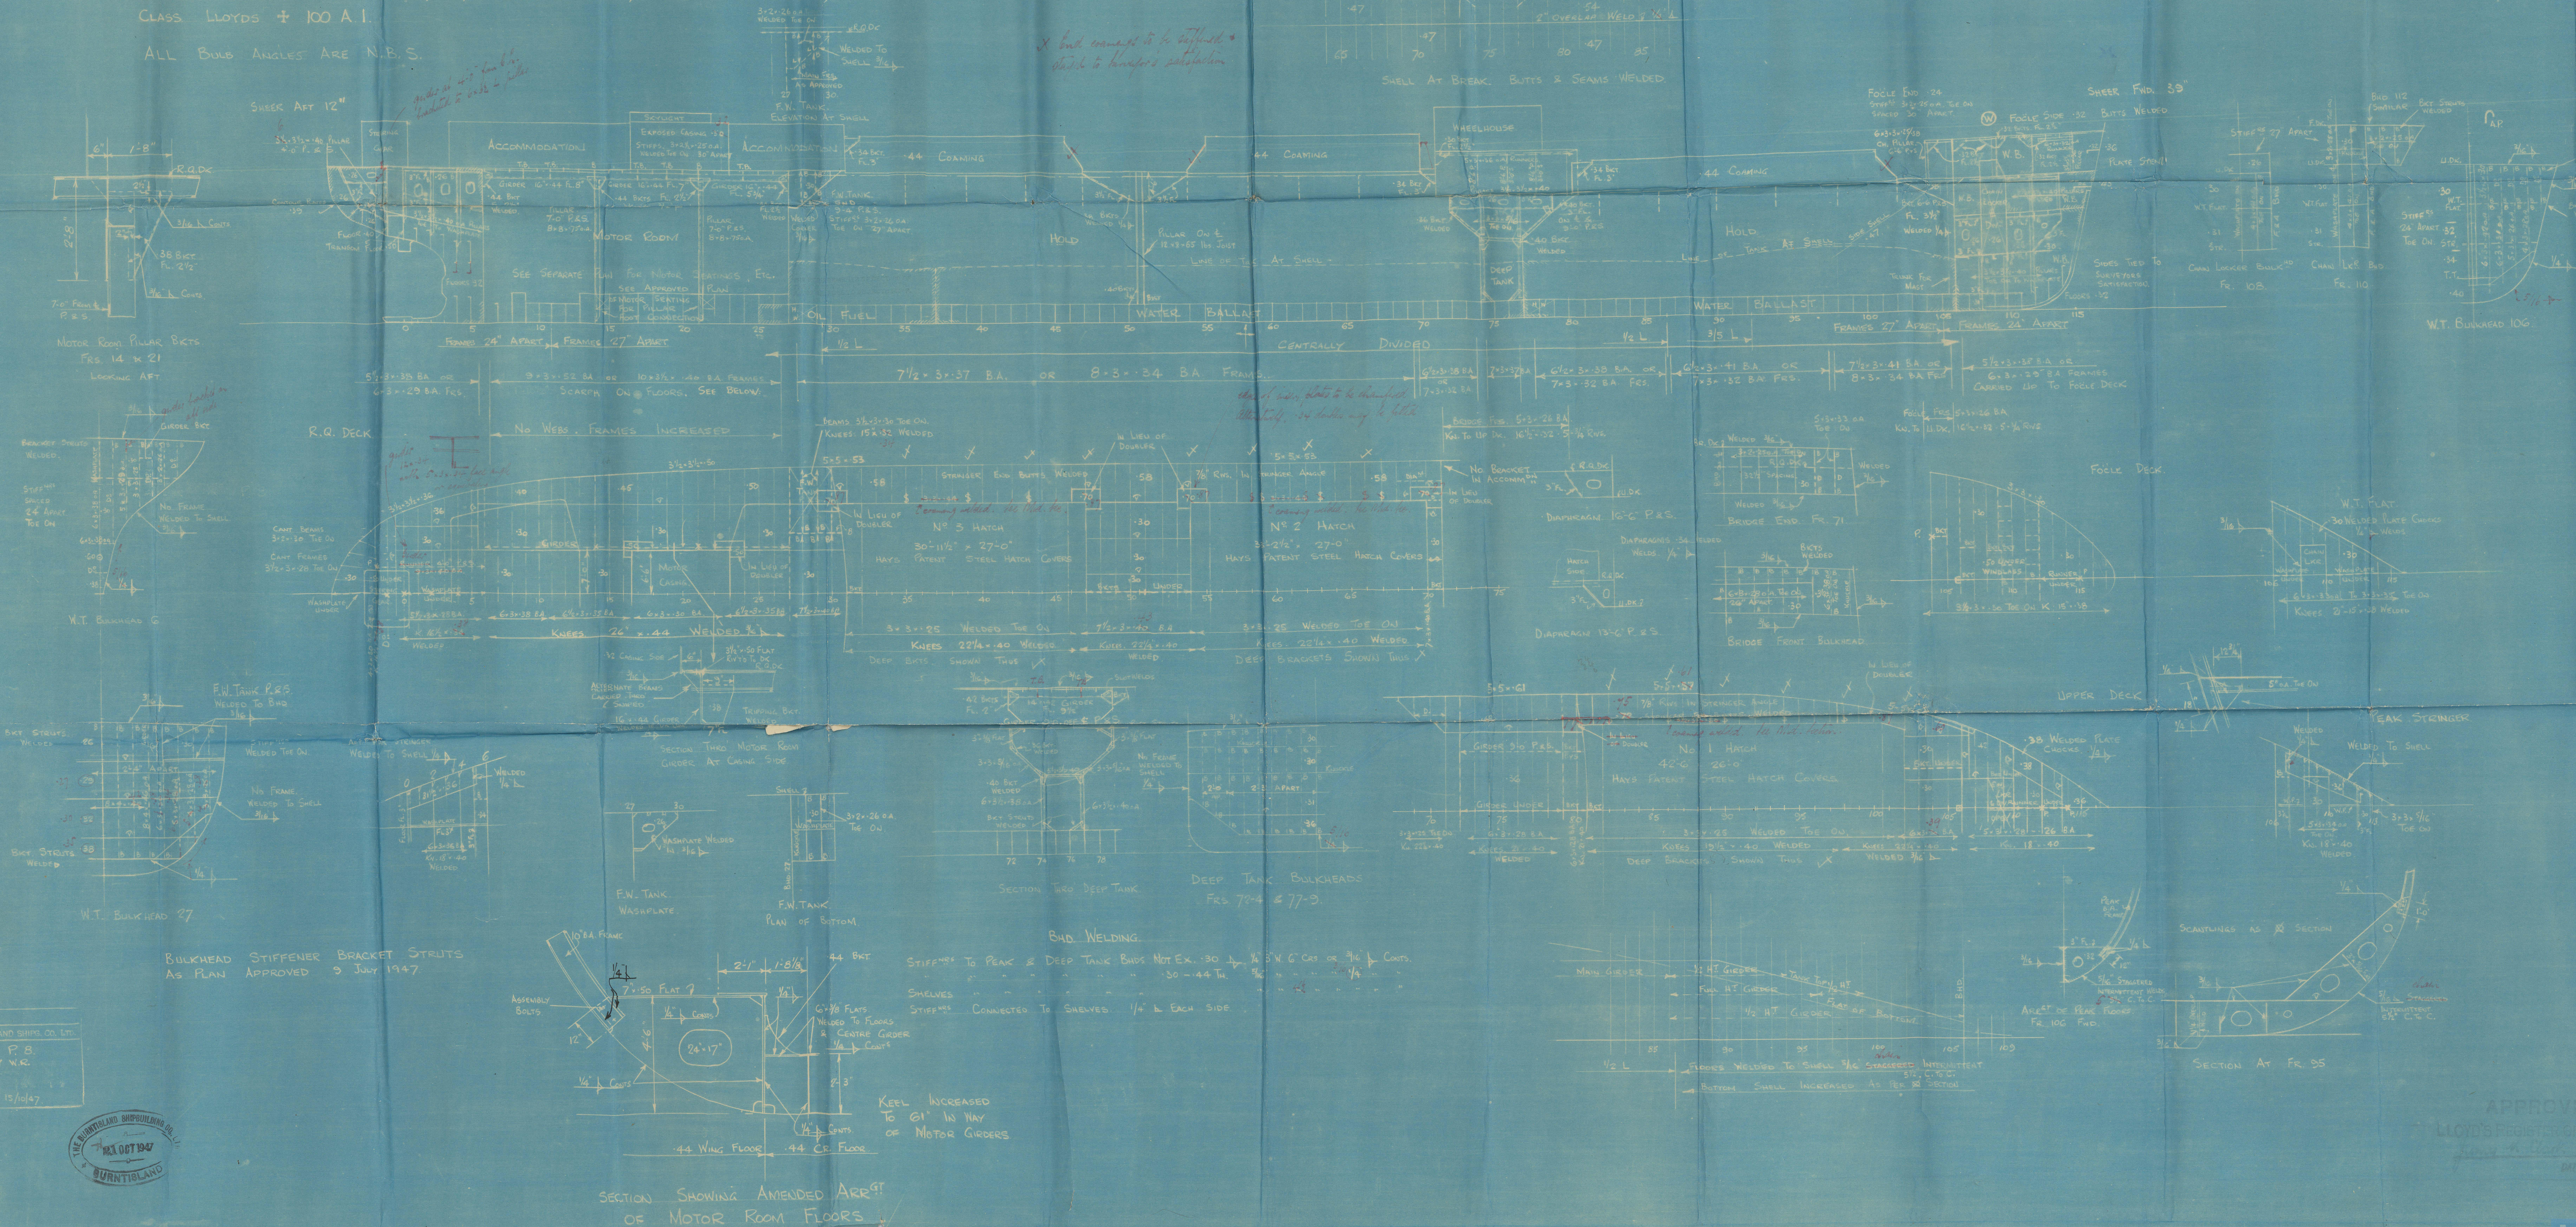

BURNITLAND SHIP CO. LTD.
PLAN NO. P. 8.
DRAWN BY W.R.
CHECKED
DATE 12/1/47.



APPROVED
LLOYD'S REGISTER OF SHIPPING
1947

Burntisland S.B. Co. Ltd.


Yard N^o 328

Profile and Decks.

M.V. "Adams Beck" ★

LEITH REPORT NO. 22248

RECORDS DEPT.
LONDON

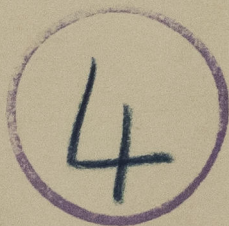

© 2021

011988-011994-0158

Lloyd's Register
Foundation