

GOOLE SHIPBUILDING & REPAIRING Co. Ltd.	
VICTORIA SHIPYARD,	
GOOLE.	
Drawing No.	1231
Made by	T.M. Checked by <i>M.H.</i>
Date	JUNE 20 TH 16

— S.T. N^o 173 —
MIDSHIP SECTION

DIMS:- 130'-0" B.P. x 22'-6" MLD x 12'-10" MLD

SCALE $\frac{1}{2}'' = 1$ FOOT

TO CLASS 100 A.I. AT LLOYDS FOR FISHING PURPOSES

NUMERALS

$$\underline{B + D} = 22.5^{\circ} + 12.83$$

35.33 TRANS. NO.

$$\underline{L \times (B + D) = 130 \times (22.5 + 12.83)}$$

= 4592.9 LONG. NO

$$a = 11.5$$

$$\frac{D}{L} = 10.13$$

EQUIPMENT

1 BOWER ANCHOR 7 1/4 CWTs STOCKLESS.


1 " " 5 1/4 " EX STOCK.

1 KEDGE 3 " " "

105 FTHS. 1 1/16 STUD LINK CABLE.

60 FTHS. 6" HAWSER MANILLA

60 FTHS. 5" WARP MANILLA.

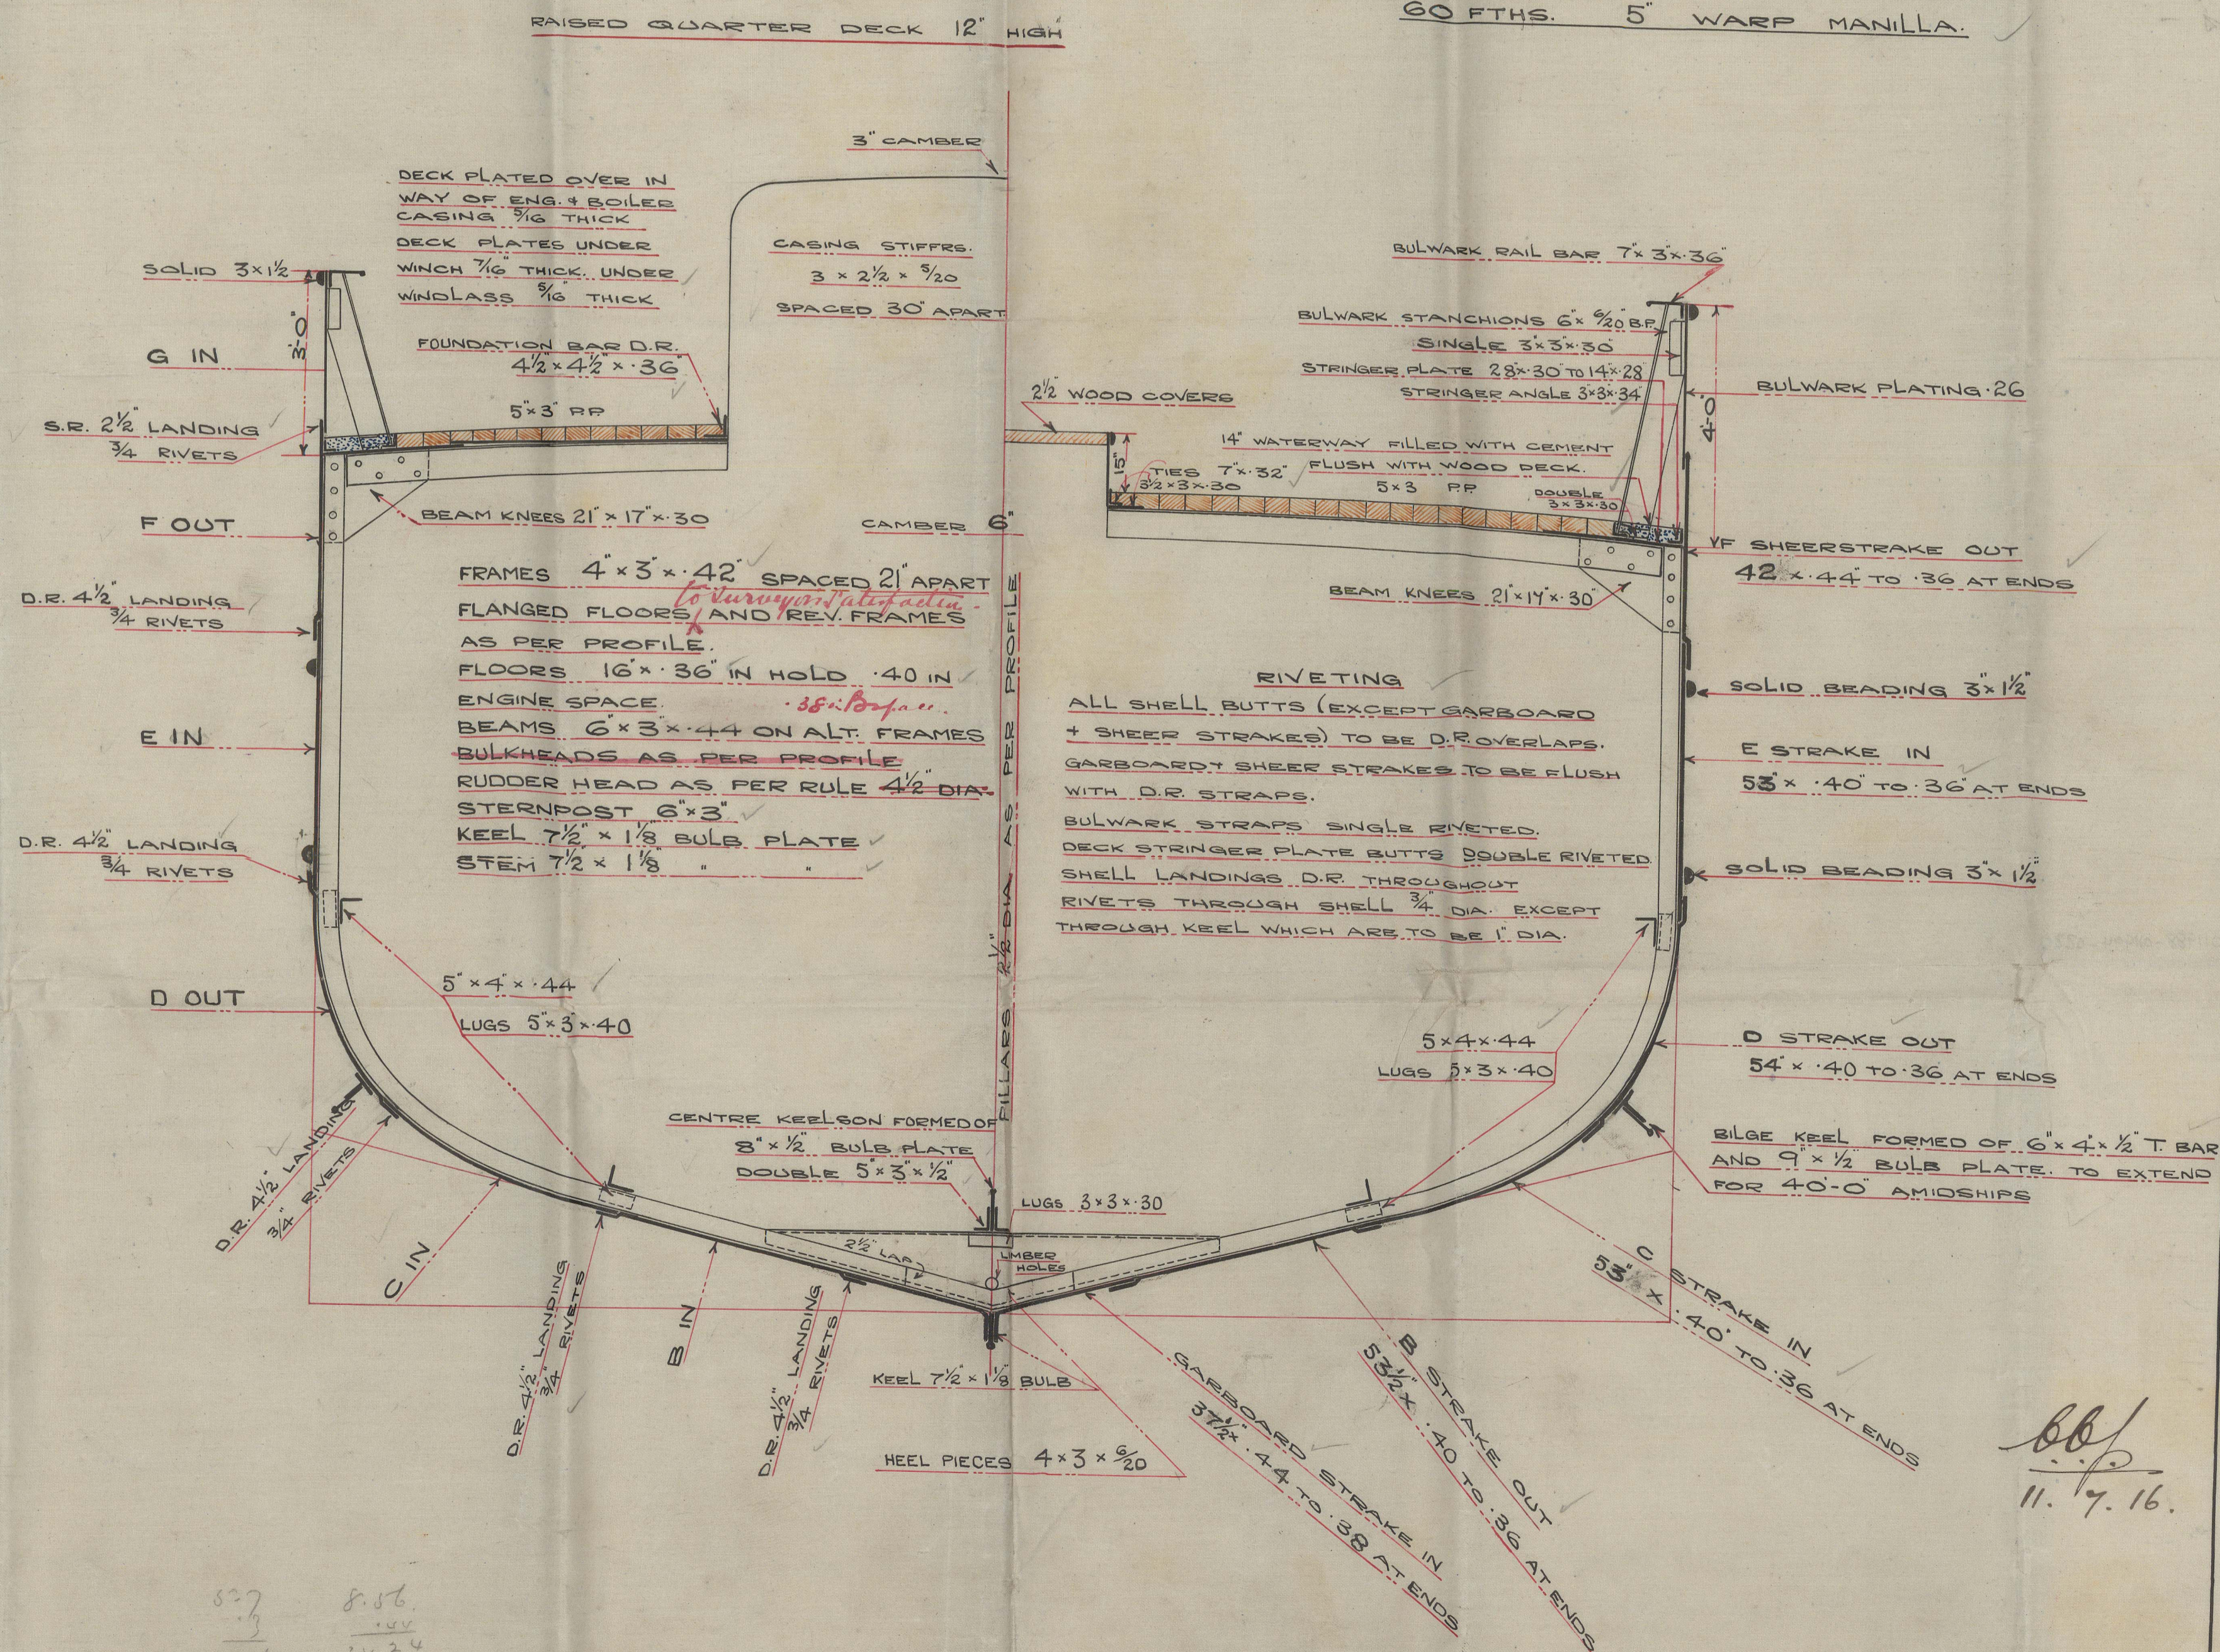

BB/
11. 7. 16

s/ Springwell -
Hull Report No. 29952.
-Midship Section -



© 2021

Lloyd's Register
Foundation

011988-011994-0220