

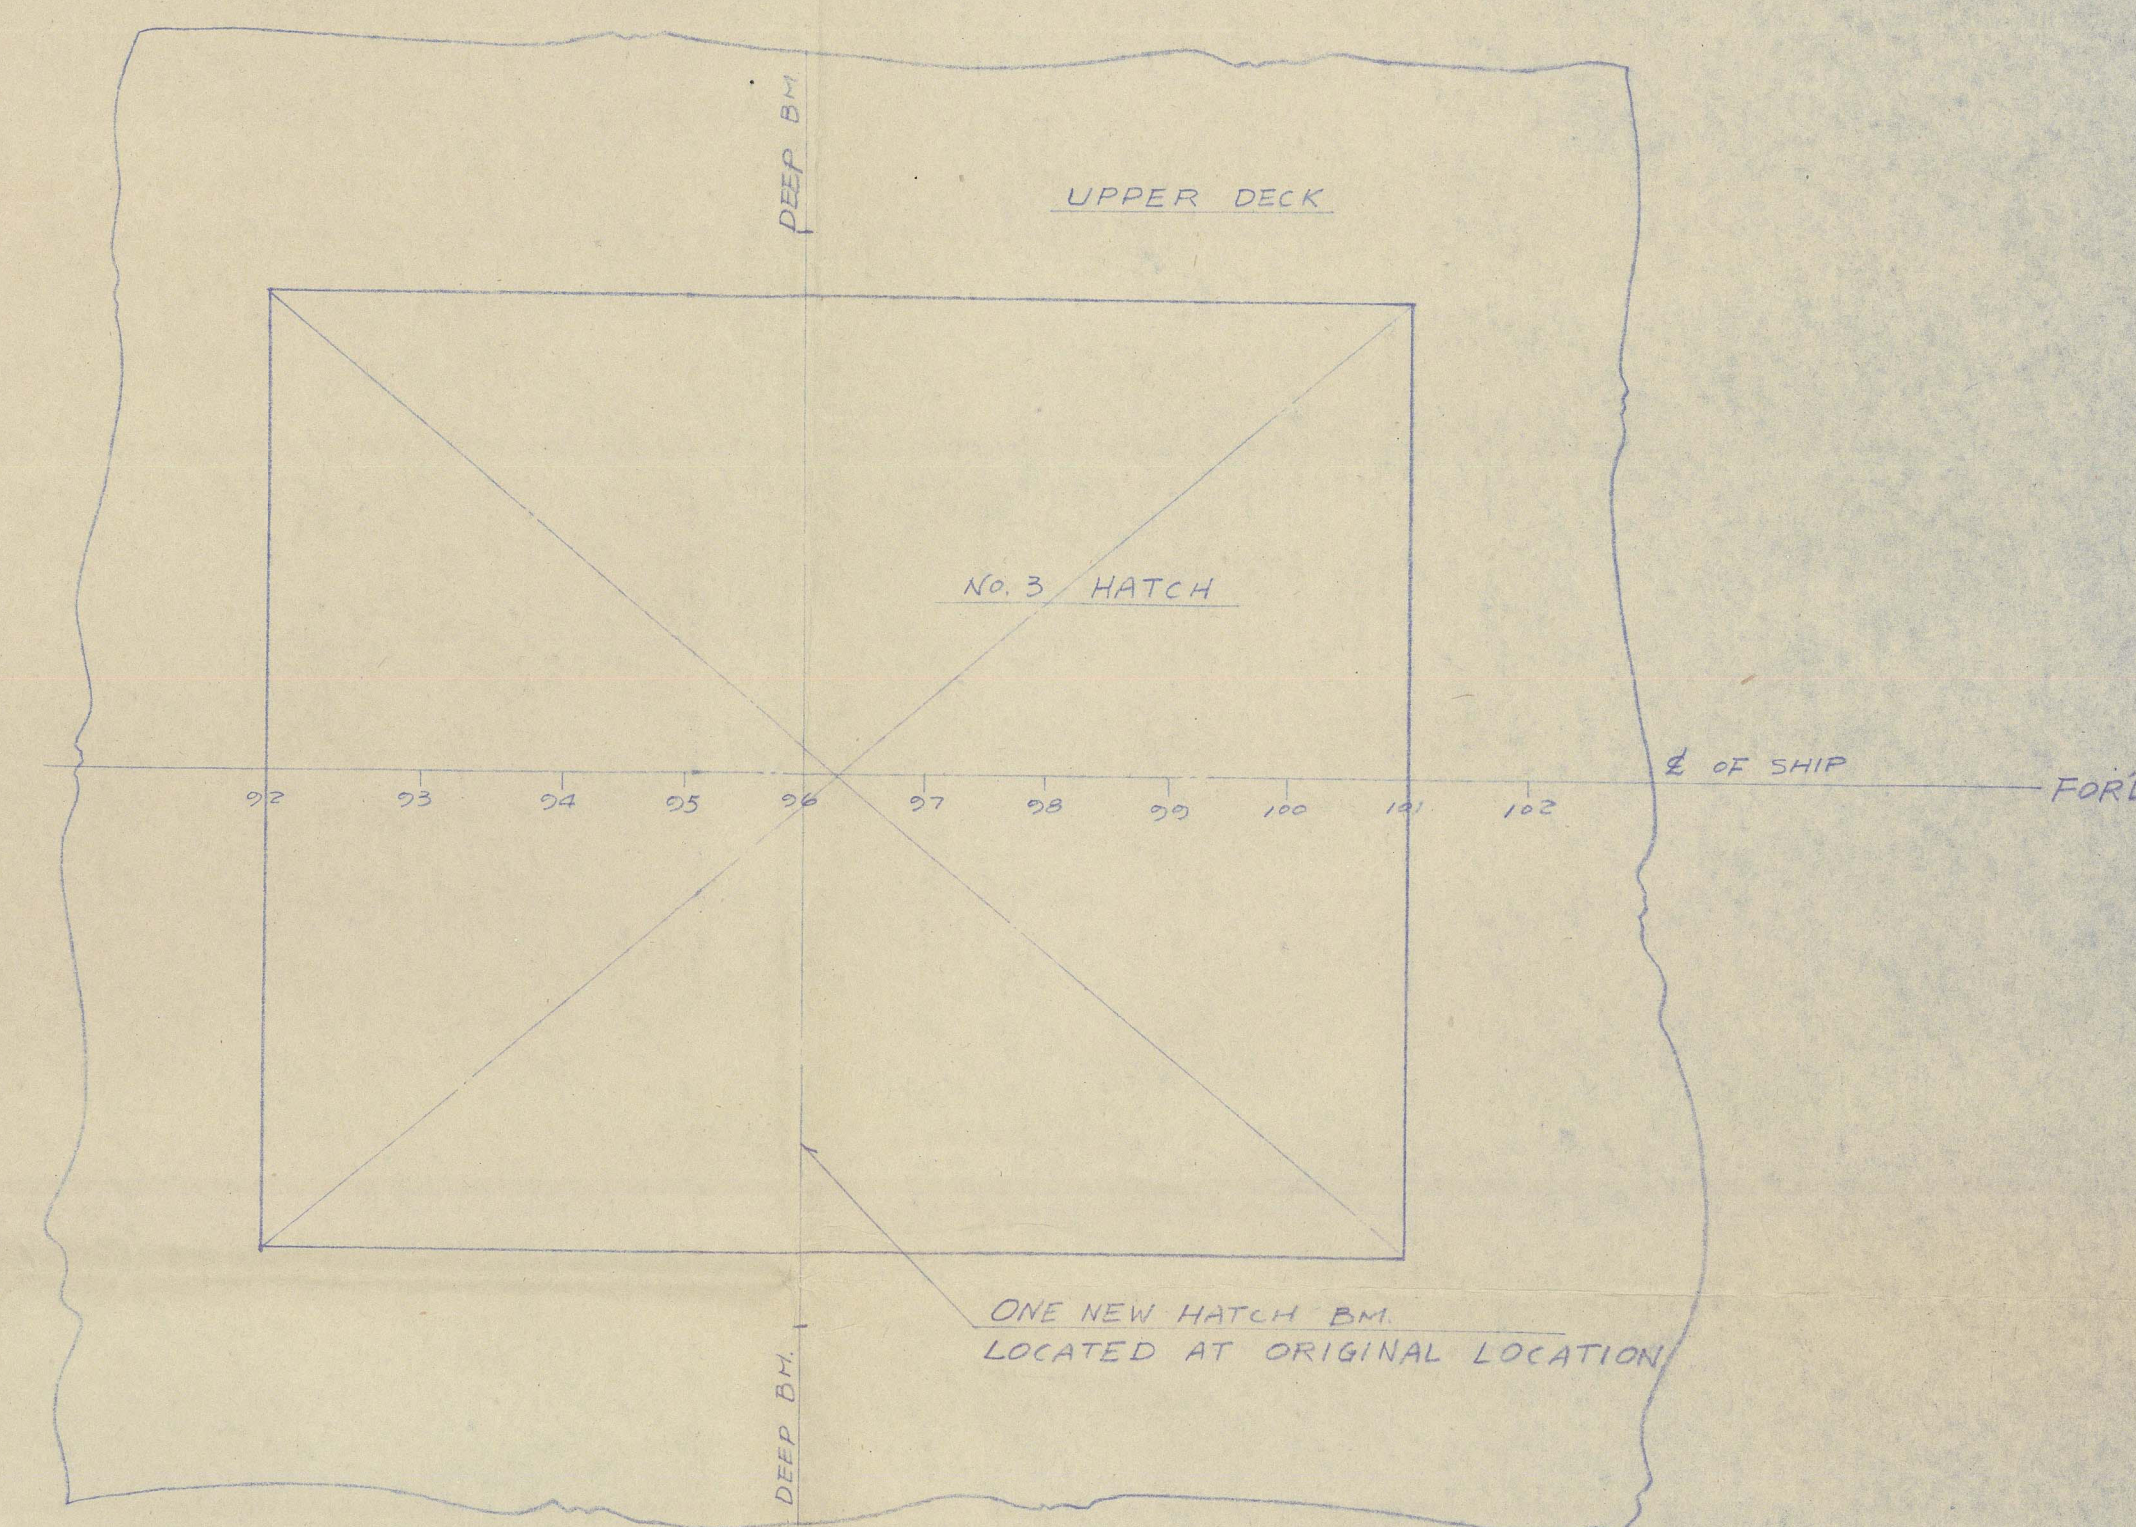
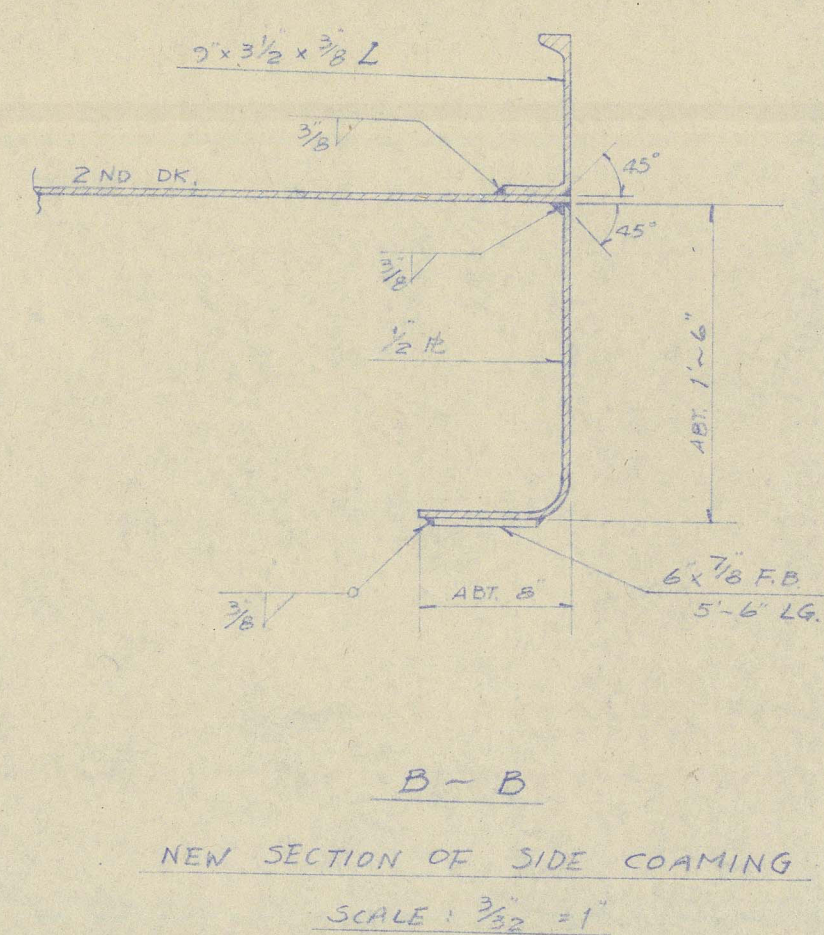


WEB FRAME & WEB BM 26  
SCALE: 1/4" = 1'-0"

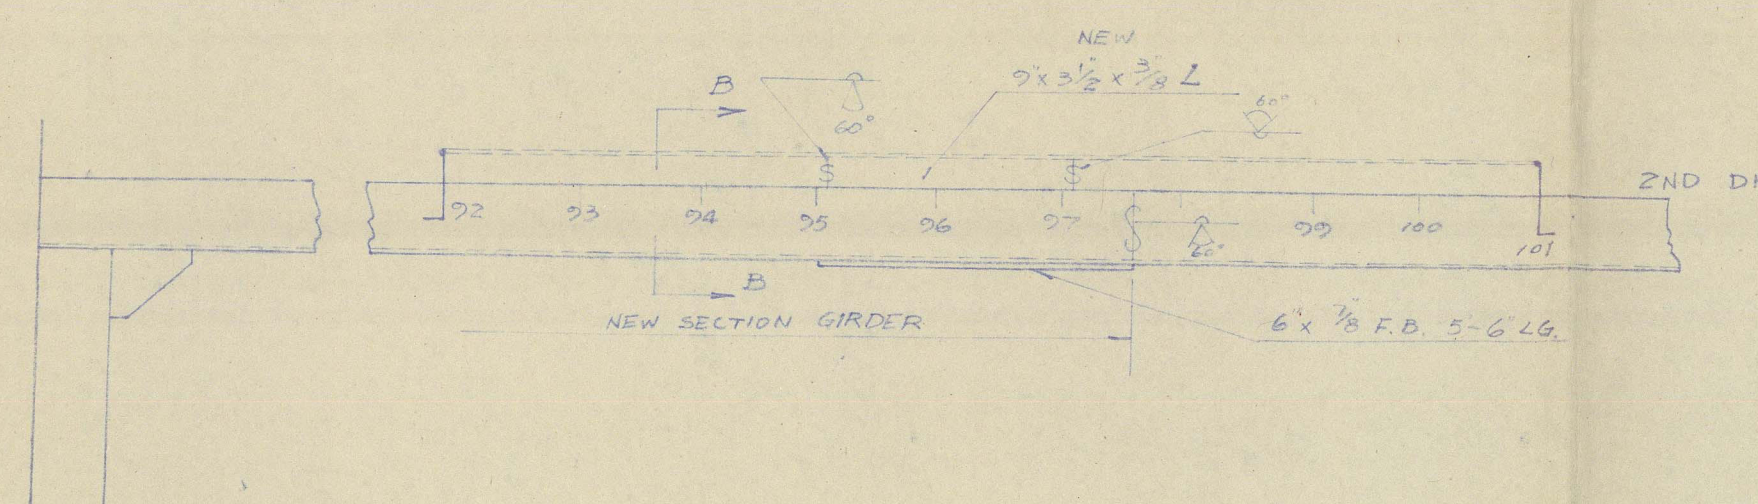

UPPER DECK PLAN: SHOWING LOCATION OF EXISTING No. 3 HATCH  
SCALE: 1/4" = 1'-0"

5/8 "EVER HAPPINESS" EX. - "EVER FORTUNE" EX. - "LEONIDAS CAMBANIS"	
FIRST STEAMSHIP COMPANY LTD.	
Drawn <u>Handwritten</u>	CONVERSION OF No. 3 HATCHES
Checked _____	
Approved _____	
Approved Date Oct. 2, 1964	Scale: As Noted

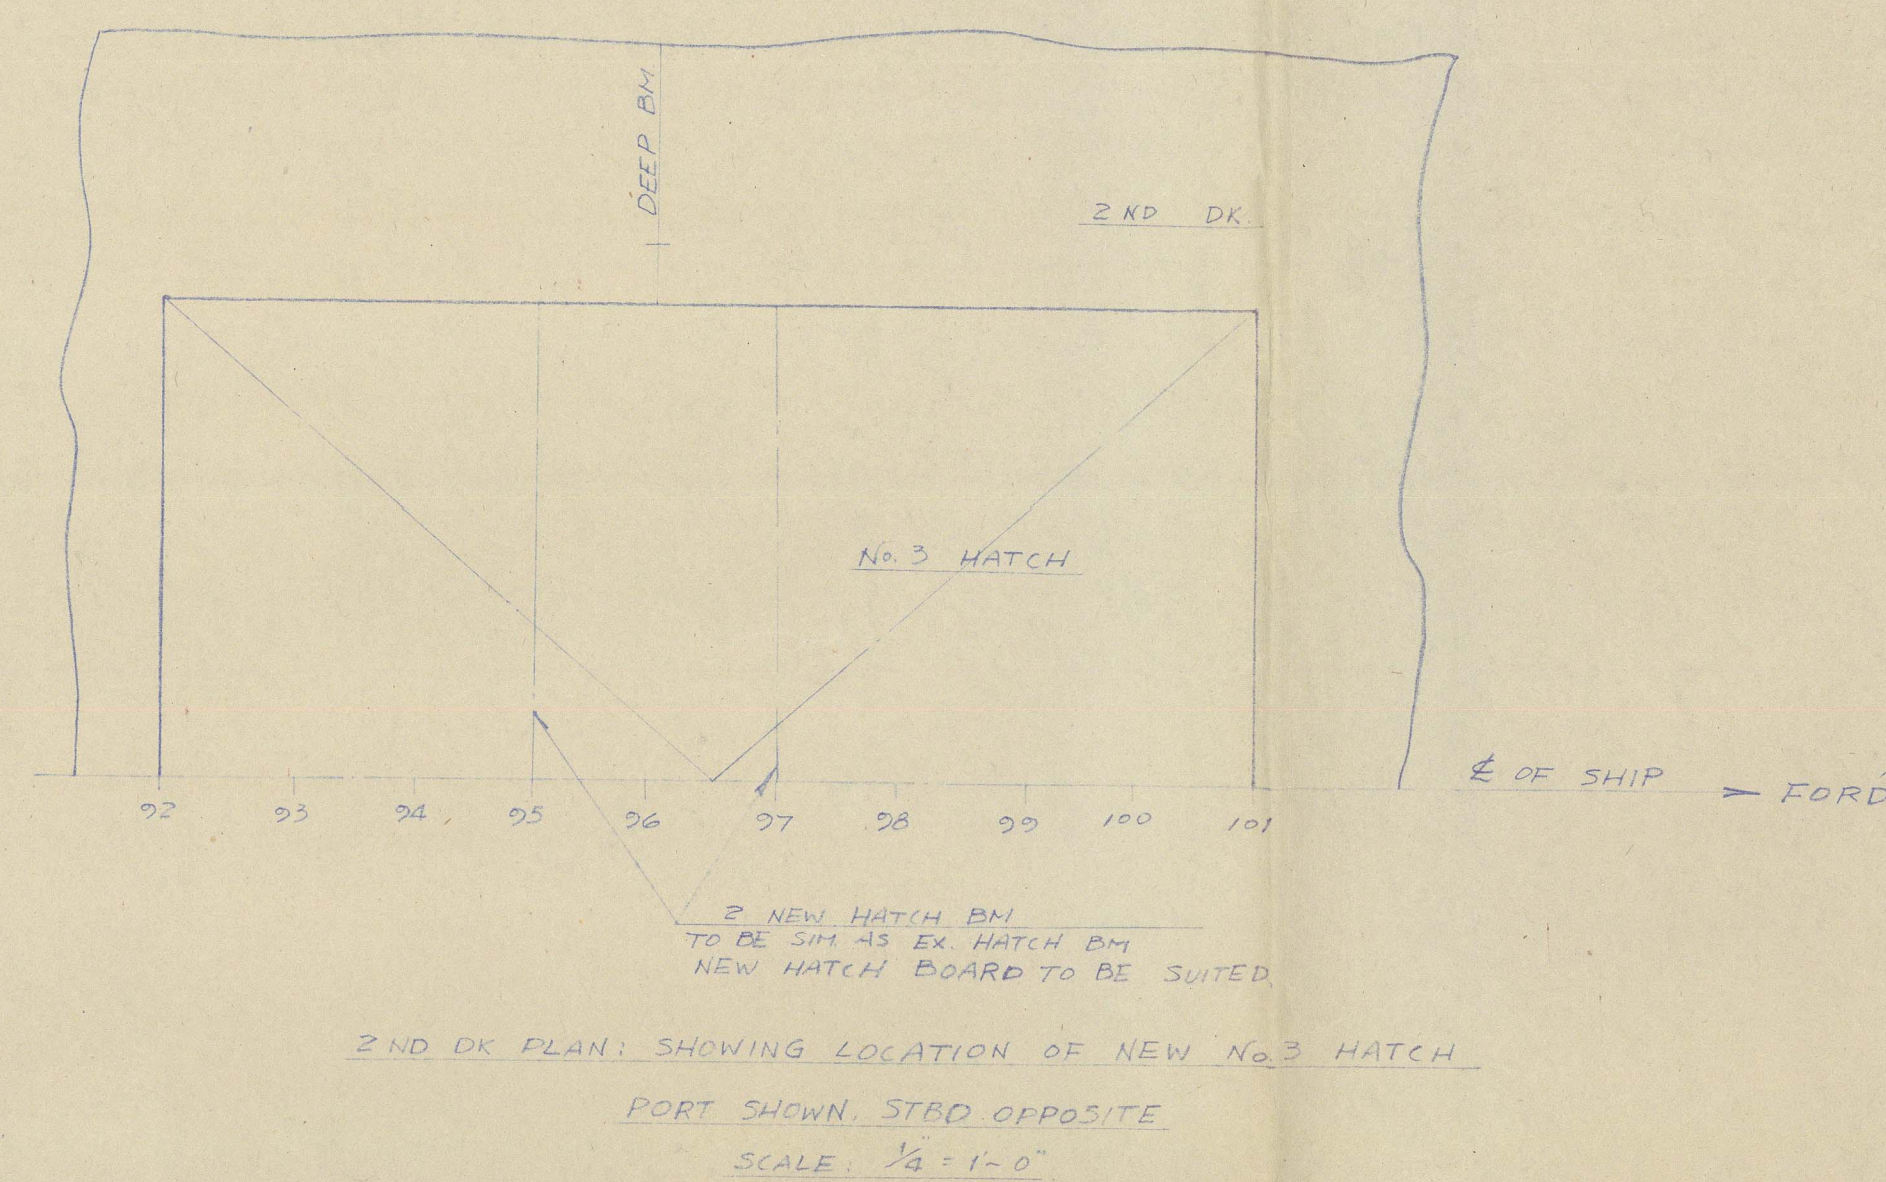

EVER HAPPINESS

011995-012002-0125



© 2020

Lloyd's Register  
Foundation