

4227/20

Copy sent to B. O. T. on 23 JUL 1932

Cardiff

1

LL. 4.C.

THE BRITISH CORPORATION REGISTER OF SHIPPING AND AIRCRAFT

SURVEY FOR FREEBOARD

23

STEAMER, TANKER, SAILER... NEW WESTMINSTER CITY S.S. WITH TIMBER DECK CARGO
 Nationality British Builders' Name and No. of Ship Wm Gray & Co. Ltd N° 1018
 Port of Registry Bideford Owners Reardon Smith Line Ltd Cardiff
 Official Number 148838 Port and Date of Survey Cardiff 7-4-32
 Gross Tonnage 4747 Name of Surveyor Joseph A. Macdonald
 Date of Build 7/1929

Particulars of Classification B.S. * (with freeboard) Names of Sister Ships "PRINCE RUPERT CITY", "TACOMA CITY", "BRADBURN", "VERNON CITY", "VICTORIA CITY", "BRADGLEN"

Type of Superstructures Complete Superstructure with middle line opening aft with full height coaming etc. (presently closed)

Give full particulars of the following:—

Fiddle and Funnel Coamings (state height of coamings, type of fiddle covers, and if these are permanently attached in their proper positions)

None coaming top. Funnel coamings 2'6", fiddle coamings 3' angle + hinged steel covers permanently attached to coaming top.

Flush Bunker Scuttles on freeboard and superstructure decks (state material, type of joints, etc., and if secured by hinge or permanent chain attachment) none

Companionways on freeboard and superstructure decks (state material, height of doorway sills, type of doors, and if these can be closed and secured from both sides)

steel house round fore & main masts with under entrance openings to all holds & between decks, steel doors made of house 5'6" x 1'10" x 6" all opening from either side, one outside door to steel house 5' x 2' with 18" sill.

Ventilators in exposed positions on freeboard, raised quarter and superstructure decks (state height of steel coamings, pitch of rivets in deck connection, type of closing arrangements)

all exposed ventilators have coamings 36" high, pitch of rivets in deck 3 1/2", wood plugs for each vent.

Airpipes in exposed positions on freeboard, raised quarter and superstructure decks (state height to opening and if satisfactory closing arrangements are provided)

minimum height above superstructure deck 26", wood plugs for closing.

Scuppers and Sanitary Discharge Pipes (state material, type and number of valves)

six scuppers each side from upper deck thru shell & above deck each with clack valve, 3 plugged permanently closed & led to main side bilge. Sanitary Disch. Pipes. Port side 4 each 1 1/2" dia w I pipe with clack valve in coaming; 3 at 1 1/2" dia w I pipe no valves. Starboard side 2 each 1 1/2" dia w I pipe with clack valve in coaming; 4 at 1 1/2" dia w I pipe no valves; other pipes discharge 20" above upper deck.

Side Scuttles to spaces below freeboard and superstructure decks (state type or pattern, and if permanent or portable deadlights are supplied)


No side scuttles below superstructure deck

Guard Rails on freeboard and superstructure decks (state type and where fitted)

Starboard 3'6" high for 1/2 length, fore & aft shell & P. forward, 3 bar transverse chain 3'6" high

012003-012010-004676

Superstructure bulkheads, trunks, deckhouses, casings, cargo and coaling hatches, extent and thickness of deck sheathing, gangway, and any other openings, etc., which would affect the seaworthiness of the ship are to be shown on the following sketches.

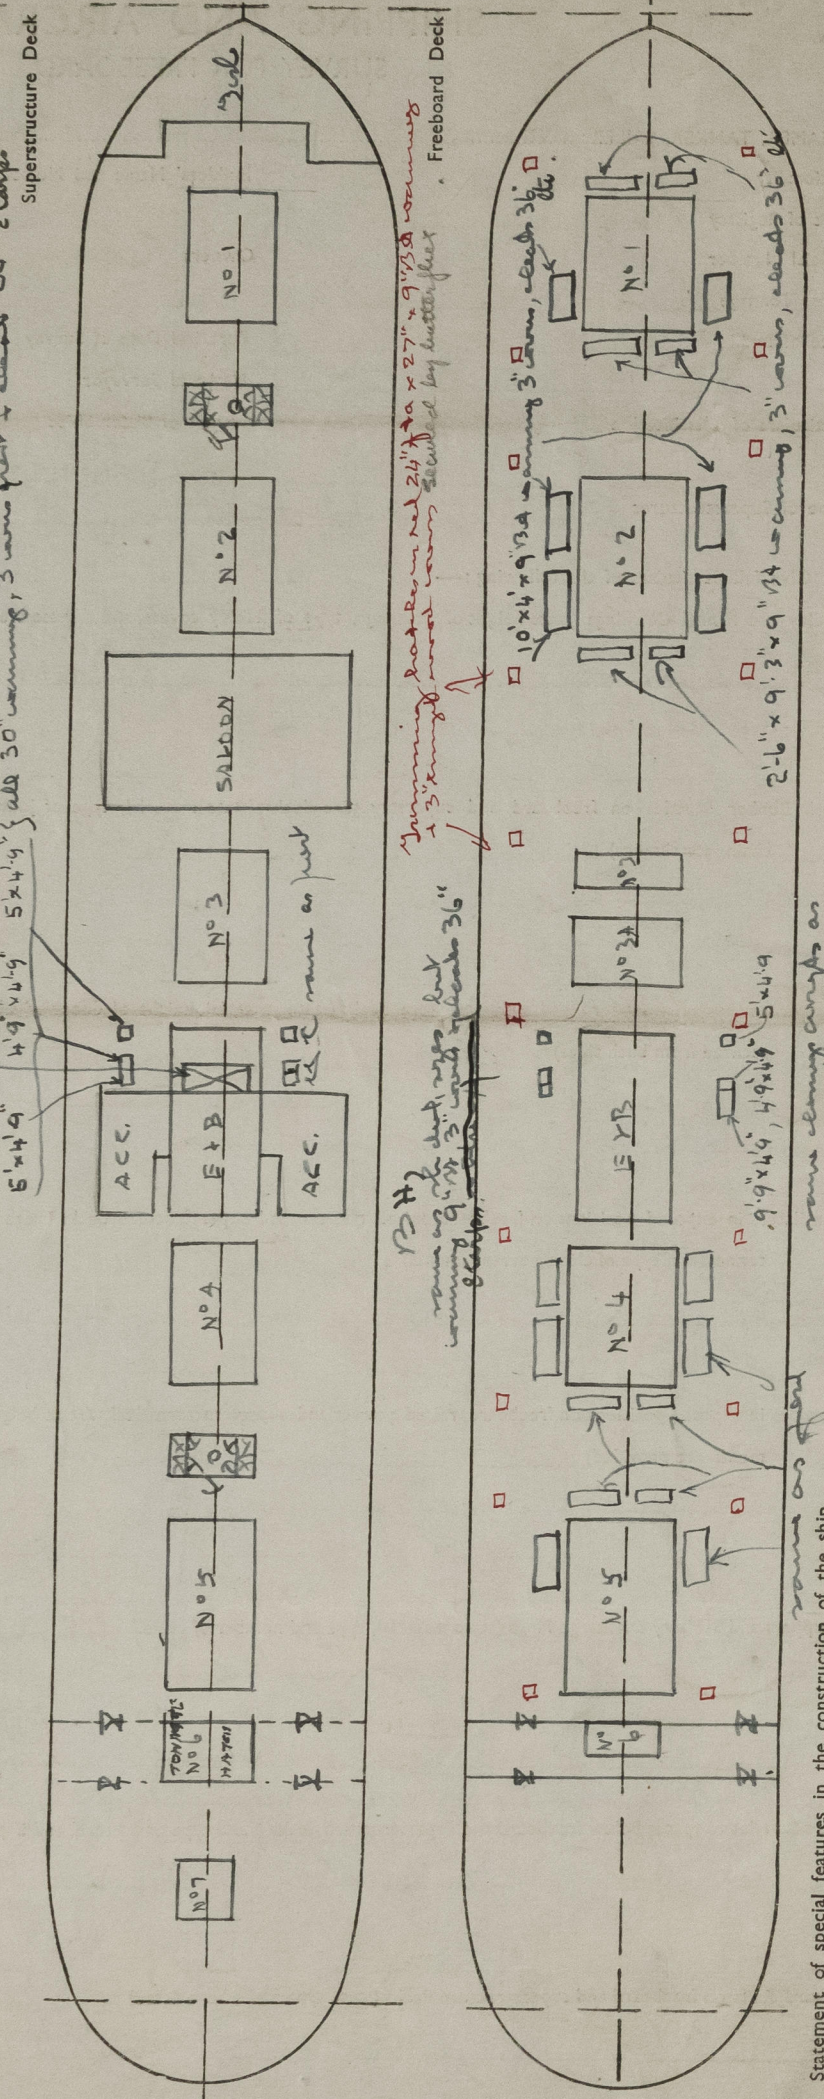

Statement of special features in the construction of the ship

0046 2/6

COMPUTATION OF FREEBOARD.

Length on summer load line 400' Moulded Breadth 54'-0 1/2" Moulded Depth 28'-0 1/2" Depth of Keel 13'
Moulded displacement (ex bossing) at moulded draught of 85 per cent. of moulded depth 11232 1/2 Tons
Co-efficient of fineness for use with tables $\frac{\Delta \times 35}{L \times B \times D \times 85} = .7628$ TC 75
Displacement and tons per inch immersion in salt water at summer load line 11902 1/2 44
Moulded depth 28.042 Deduction for Fresh Water $\frac{\Delta}{40T} = \frac{11902}{40 \times 44} = 6.77$ inches
Stringer Plate .037 Round of Beam Correction 13.5 inches
Sheathing on exposed deck T $(\frac{L-S}{L}) = 1$ Ships Round of Beam 12.97
Rise of floor (in sailers) 28.079 Standard Round of Beam $\frac{B \times 12}{50} = 12.97$
Depth for Freeboard (D) 26.667 Difference .53
Table Depth 1.412 x 3 Restricted to
Depth Correction = 4.236 Correction $\frac{\text{Difference}}{4} \times (1 - \frac{F}{L}) = .133 \times .00875 = 0$
If restricted by superstructures

	Enclosed Length	Length of Overhang	Height	Mean Covered Length (S)	Height Correction	Effective Length (E)
Poop	24.69		8'-10 1/2"	24.69		24.69
Raised Quarter Deck		F				
Bridge	368.31	A	8'-10 1/2"	368.31		368.31
Forecastle						
Trunk Aft						
Forward						
Tonnage Opening Aft	7		8'-10 1/2"	7		3.5
Forward						
Totals				400		396.5

Station	Actual Sheer	Standard Sheer	Effective Sheer	S.M.	Product
A.P.	51.0	50	51	1	51.0
1/2 L from A.P.	22.0	22.25	22	4	88.0
1/2 L from A.P.	5.75	5.5	5.75	2	11.5
Amidships	0	0	0	4	0
1/2 L from F.P.	12.5	11.0	12.5	2	25.0
1/2 L	40	44.5	46	4	184.0
F.P.	105	100	105	1	105.0
				18	464.5
Effective Mean Sheer					25.806
Standard					8.5
Difference					21.306
					6.306

Mean Actual sheer aft = greater than 1
Mean Actual sheer forward = greater than 1
Length of enclosed superstructure forward of amidships = Length of Ship
Length of enclosed superstructure aft of amidships = Length of Ship
Sheer Correction = Difference $\times (\frac{75}{2L}) = 6.306 \times .25 = 1.577$
If limited on account of midship superstructure =
to maximum allowance of 1 1/2 ins. per 100 ft. =

TABULAR FREEBOARD corrected for flush deck if required = 71.5
Correction for co-efficient = $71.5 \times \frac{1.4428}{1.26} = 75.86$

	+	-
Depth correction	4.24	-
Deduction for superstructures	-	41.55
Sheer correction	-	1.58
Round of Beam correction	-	-
Correction for thickness of deck amidships	-	-
Other corrections, scantlings, etc.	-	-
	4.24	43.13
		-38.89

Summer Freeboard in inches = 36.97
Additional allowance for superstructures on Timber carrying ships = .22
Summer Timber Freeboard in inches = 30.75
6.25
30.5

	Sailor, Tanker, Steamer	Timber
Depth to Freeboard Deck in feet	28.079	28.079
Summer Freeboard in feet	3.081	3.062
Moulded Draught (d)	24.998	25.017 (d1.)
Addition for Keel		
Extreme draught		
Deduction for Tropical and addition for Winter freeboard $d/4 = 6.25$ ins. $\frac{1}{4} \times 25 = 6.25$		
Addition for Winter North Atlantic (if required)		
Deduction for Tropical Timber Freeboard $\frac{d1}{4}$		6.25 ins.
Addition for Winter		8.34 ins.
N.A. Timber Freeboard (if required)		

0046 3/6

Reassigned (in RED) 9-5-41 in accordance with M/S memo M3381/41
See Middleborough report dated 16-5-41

SUMMER FREEBOARD recommended amidships from centre of disc to top of deck line, (steel)	3'-1" 11'-4" - 3 1/2
TROPICAL FRESH WATER LINE above centre of disc	13'
FRESH WATER LINE	6 1/2'
TROPICAL LINE	6 1/2'
WINTER LINE below	6'
WINTER NORTH ATLANTIC LINE	3'-7" 11'-10" - 3
SUMMER TIMBER FREEBOARD recommended amidships from centre of disc to top of deck line (1/2 above S)	3'-0 1/2"
TROPICAL FRESH WATER Timber line above centre of disc	12 1/2'
FRESH WATER	6 1/2'
TROPICAL	6'
WINTER below	6 1/2'
WINTER NORTH ATLANTIC	3'-7"

Increase in draught 7 1/4" Validity of LL cert. 12 months from 19-5-41

	Coaming	Plating	Stiffeners	Spacing	End Attachments	No. and size of Openings	Height of Sills	Height of Casings
Poop Bulkhead	3	3	3 1/2" x 3" x 3	38"	2 x 5' x 3'-1"	1'-8"		
R.Q.D.								
Bridge Aft Bulkhead	3	3	3 1/2" x 3" x 3	27"	2 x 5' x 3'-1"	1'-8"		
Forward								
Forecastle Bulkhead								
Trunk, Aft								
Forward								
Exposed Machinery Casings on Freeboard or R.Q. Decks								
Exposed Machinery Casings on superstructure decks	375	3	3 1/2" x 3" x 3	30"	2 each side 5' x 2' 1/2" down	1'-6"	8'-0"	
Machinery Casings within Superstructures not fitted with Cl. 1. closing appliances	375	3	3" x 3" x 3	30"	1 each side 27" x 28" 1/2" down	1'-7"	8'-10 1/2"	
Deckhouses on flush deck ships								

PARTICULARS OF CLOSING APPLIANCES (state if capable of being manipulated from both sides)

Poop Bulkhead	Weather boards full height in channels riveted to hull.
R.Q.D.	
Bridge Aft Bulkhead	Weather boards full height in channels riveted to hull.
Forward	
Forecastle Bulkhead	
Exposed Machinery Casings on Freeboard or R.Q. decks	
Exposed Machinery Casings on superstructure decks	2 each side 5' x 2'
Machinery Casings within superstructures not fitted with Cl. 1. Closing Appliances	1 each side 27" x 28"
Deck houses on Flush Deck ships	

PARTICULARS OF FREEING ARRANGEMENTS

	Length of Bulwark	Height of Bulwark	No. and size of Freeing Ports each side	Area each side	Rule Area
Tonnage After Well	7'	8'-10 1/2"	one at 2'-2" x 1'-5" opening permanently closed	3 sq	
Forward Well					
State fore and aft position and height above deck to bottom of port, for each port			middle of well, 3" to bottom of port.		
State whether freeing ports are fitted with shutters, bars or rails, and give particulars			lugged door		
Give particulars of freeing port area, etc., on superstructure decks			bulwarks 125 ft long, 4 ft high, 8 ft wide, no rails on doors, bottom of opening 8' above deck		

© 2021 Lloyd's Register Foundation

0046 4/6

PARTICULARS OF ALL HATCHWAYS ON FREEBOARD AND SUPERSTRUCTURE DECKS

0046 5/6

PARTICULARS

Number and description of Hatchway	Dimensions of Hatchway	Height above deck	Thickness	Stiffeners	Brackets or Stays	Number	Spacing	Scantling and Sketch	Bearing Surface and thickness of carriers or sockets	Number	Spacing	Unsupported lengths	Scantling and Sketch	Bearing Surface and thickness of carriers or sockets	Material	Thickness	How Fitted	Bearing Surface	Spacing of Cleats	Number of Tarpaulins
COAMINGS	27' x 20'	30"	44	7-3-4 9A 10A 11A 22																

[Surveyors are to note that wood fore and afters are to be steel shod at all bearing surfaces.]


Are wood fore and afters steel shod at all bearing surfaces?

Are battens and wedges efficient and in good condition?


are carpenter in good condition and in accordance with Rule

Are lashings provided in accordance with rule requirements?

Gangways and Lifelines

Wire life Lines from forecstle to fore end of deck house

Gangway, Cargo and Coaling Ports in sides of ship

SUPPLEMENTARY REQUIREMENTS FOR STEAMER CARRYING TIMBER DECK CARGOES

Do Superstructures and Machinery Casings comply with rules?


Is provision made for protection of steering gear, and is emergency steering gear provided?

Are efficient uprights, sockets and lashings provided according to rules?

State particulars of longitudinal subdivision in double bottom

No 2, 3, 4 & 5 bands, lower center long W.T.

State particulars of Bulwarks and Rails

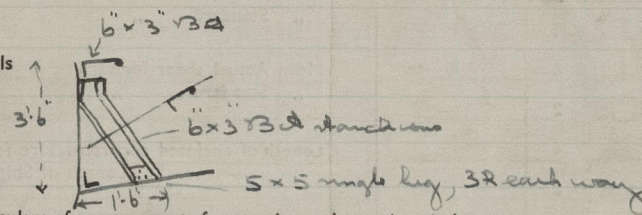

Approval date of plans and full particulars of arrangements for stowing and securing timber

The scantlings and protective arrangements being in accordance with the Freeboard rules it is submitted that the freeboard be assigned

Passed at a meeting of the Committee of Management of the British Corporation Register of Shipping and Aircraft

on the 25th May 1932.

11th June 1941

Chief Surveyor

nd Aircraft
Lloyd's Register
Foundation
Carstairs Secretary.

Secretary