

DRAWING No. 1241/2.P.

SINGLE SCREW THAMES BARGE TUG
SCANTLING SECTION

SCALE : $\frac{3}{4}" = 1'-0"$



DIMENSIONS

L (O A)	81'-3"
L (B.P)	75'-0"
B (MLD)	20'-0"
□ (MLD AM, DSHIP)	10'-6"
DRAFT (MEAN)	8'-9" (8 11/2 AM, DSH)


SCANTLING NUMERALS

L	75.0
B	20.0
D	10.5
d	8.458
$L(B+D)$	2287.5

TO CLASS LLOYDS ~~105~~ A1 (SPECIAL SURVEY) FOR TOWING SERVICE ON RIVER THAMES

EQUIPMENT.

1- 4CWT. STOCKLESS BOWER ANCHOR.
60FTMS ~ $\frac{9}{16}$ " STUD LINK CABLE.
HAWKER
60 " ~ $\frac{5}{8}$ " MANILLA MOORING ROPE.
WARP

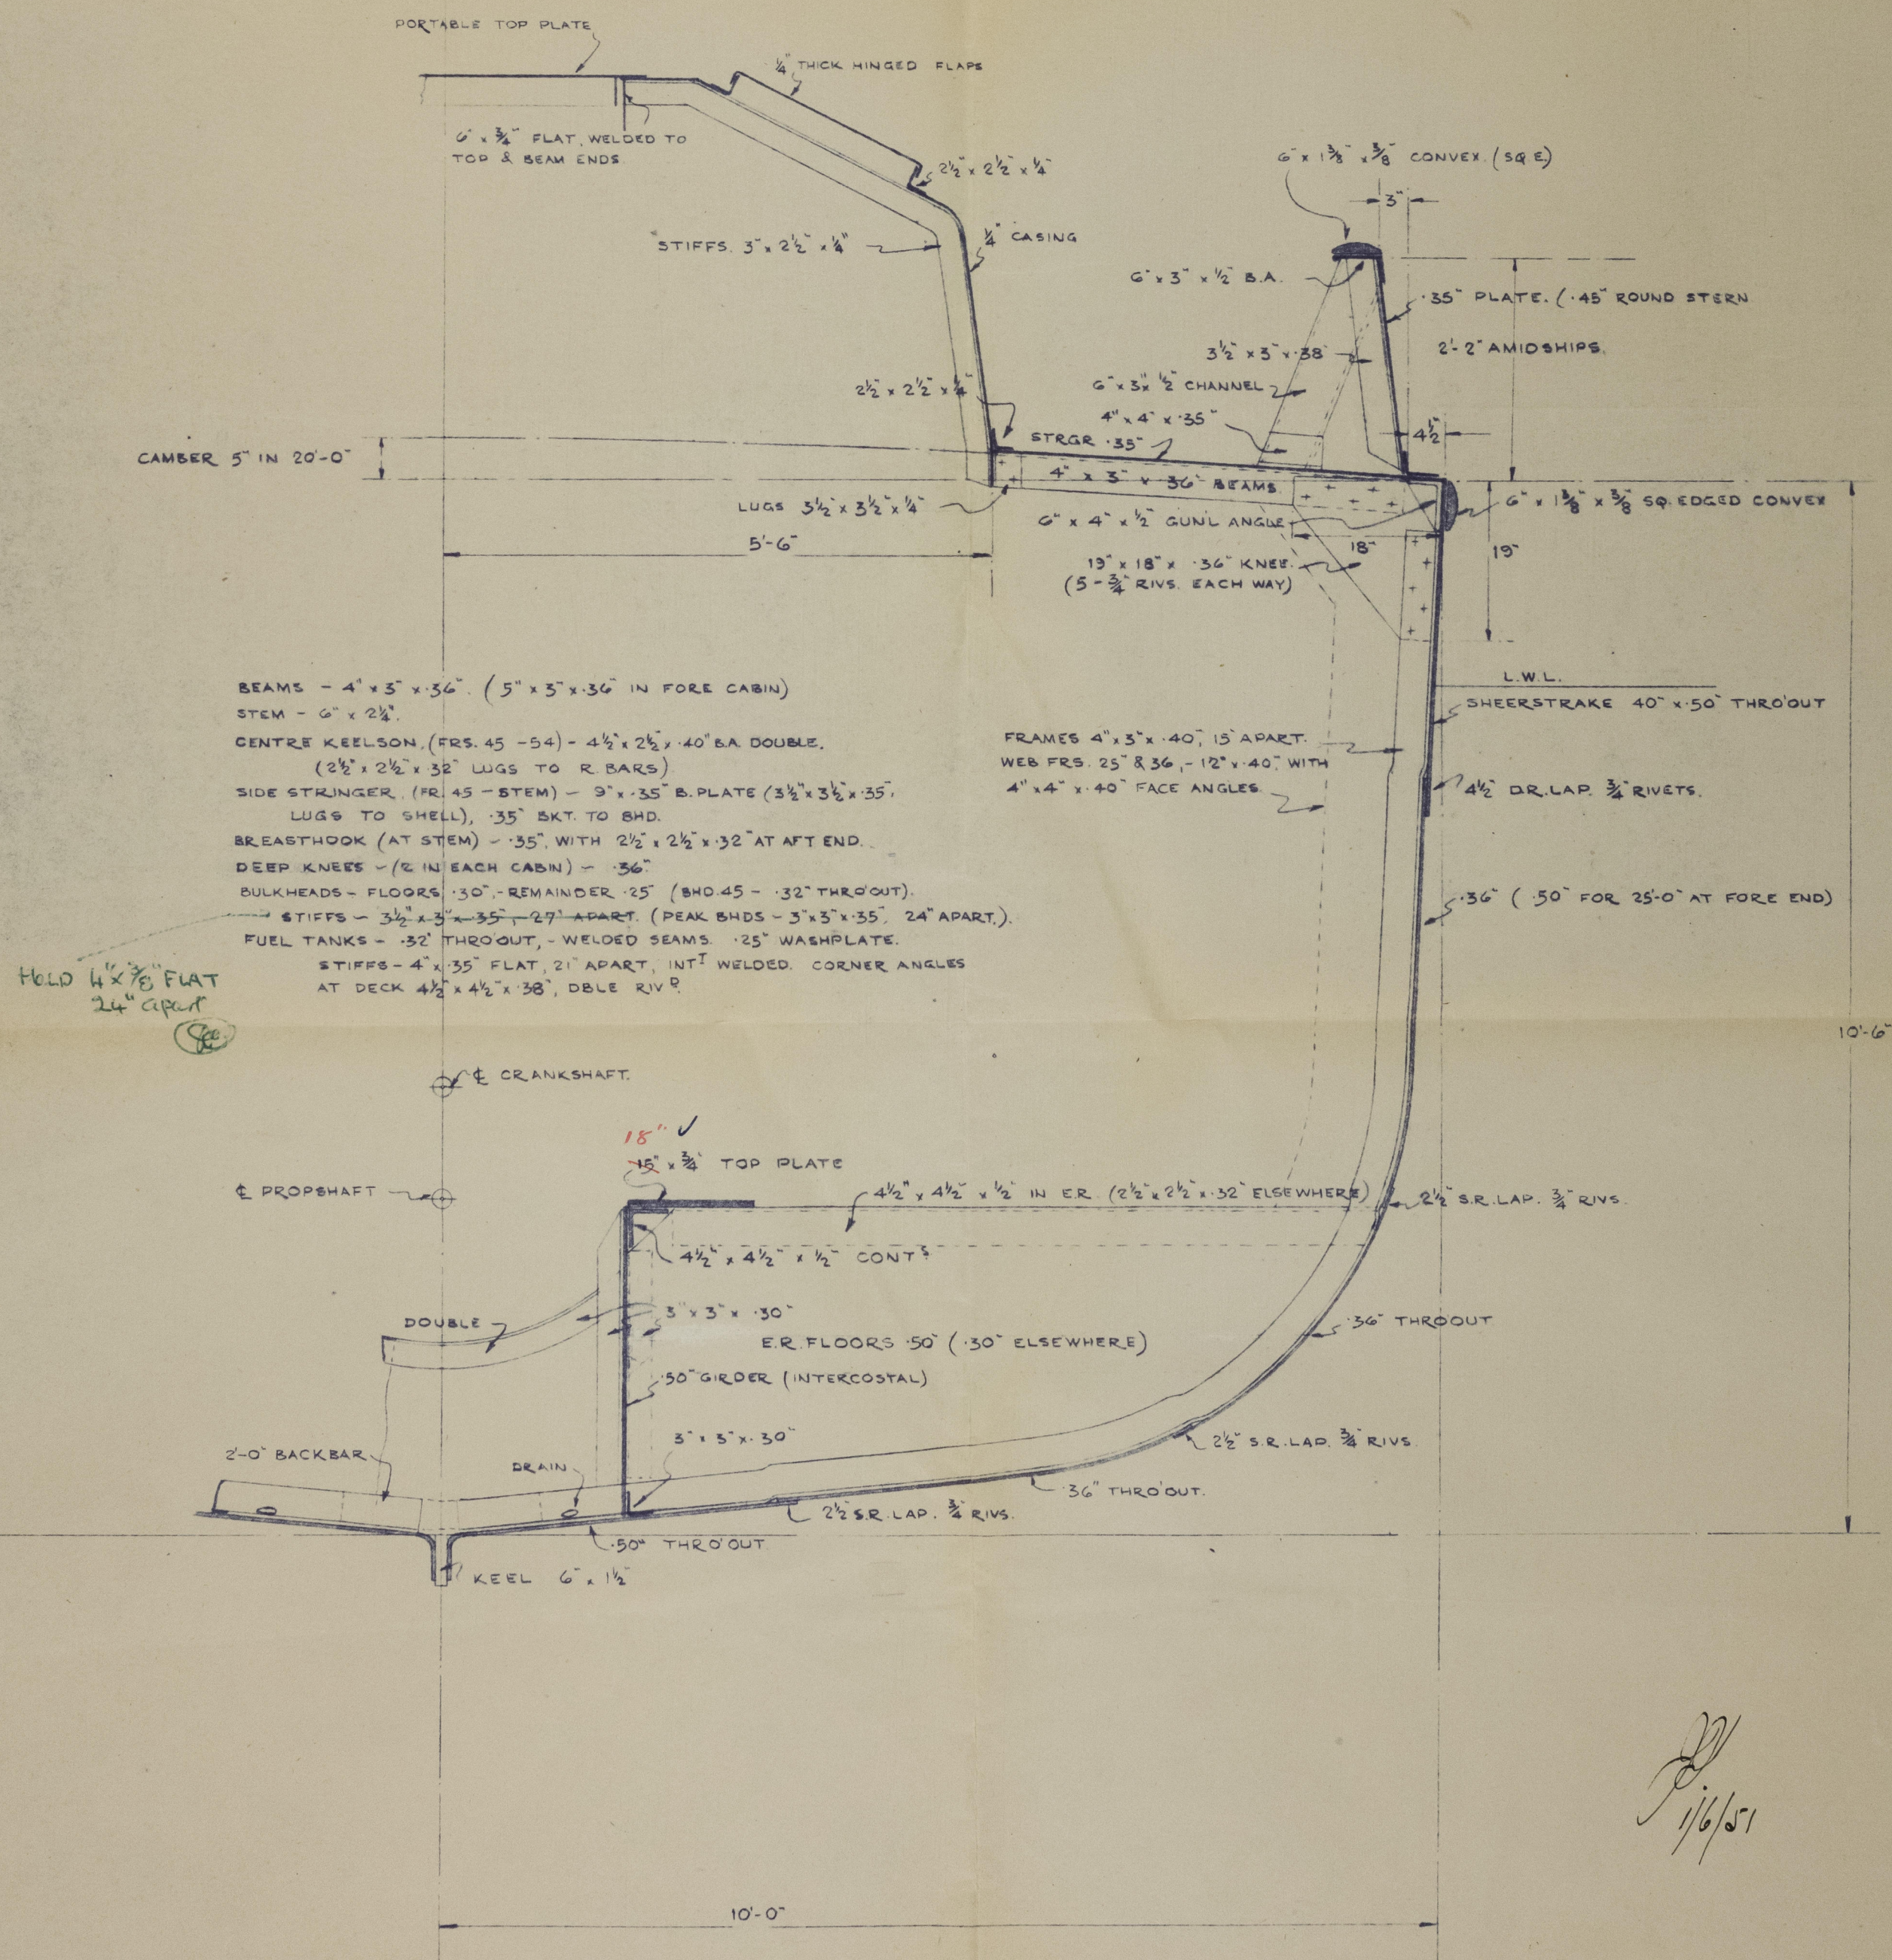

YARD No:- 1241.

PLY. RPI 8235


PHILIP & SONS 1241

TUG 'HEMBO'

Hembo ★

RECORDS DEPT.
LONDON

SCANTLING SECTION

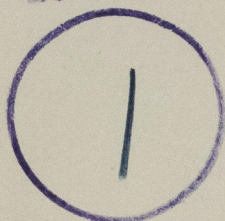

Scantling section

012008-012010-0111



© 2021

Lloyd's Register
Foundation