

SCALE - $\frac{3}{8}'' = 1'-0''$

JUN 1950

DIMENSIONS


L. (O.A)	81'-3"
L. (B.P)	75'-0"
B. (MLD)	20'-0"
D. (MLD AMIDSHIPS)	10'-6"
DRAFT (MEAN)	8'-9"

SCANTLING NUMERALS

L	75.0
B	20.0
D	10.5
d.	8.458
L(B+D)	2287.5

TO CLASS LLOYD'S ~~100~~ A.1. (SPECIAL SURVEY) FOR TOWING SERVICE ON RIVER THAMES.

CAMBER 5' IN 20'-0"

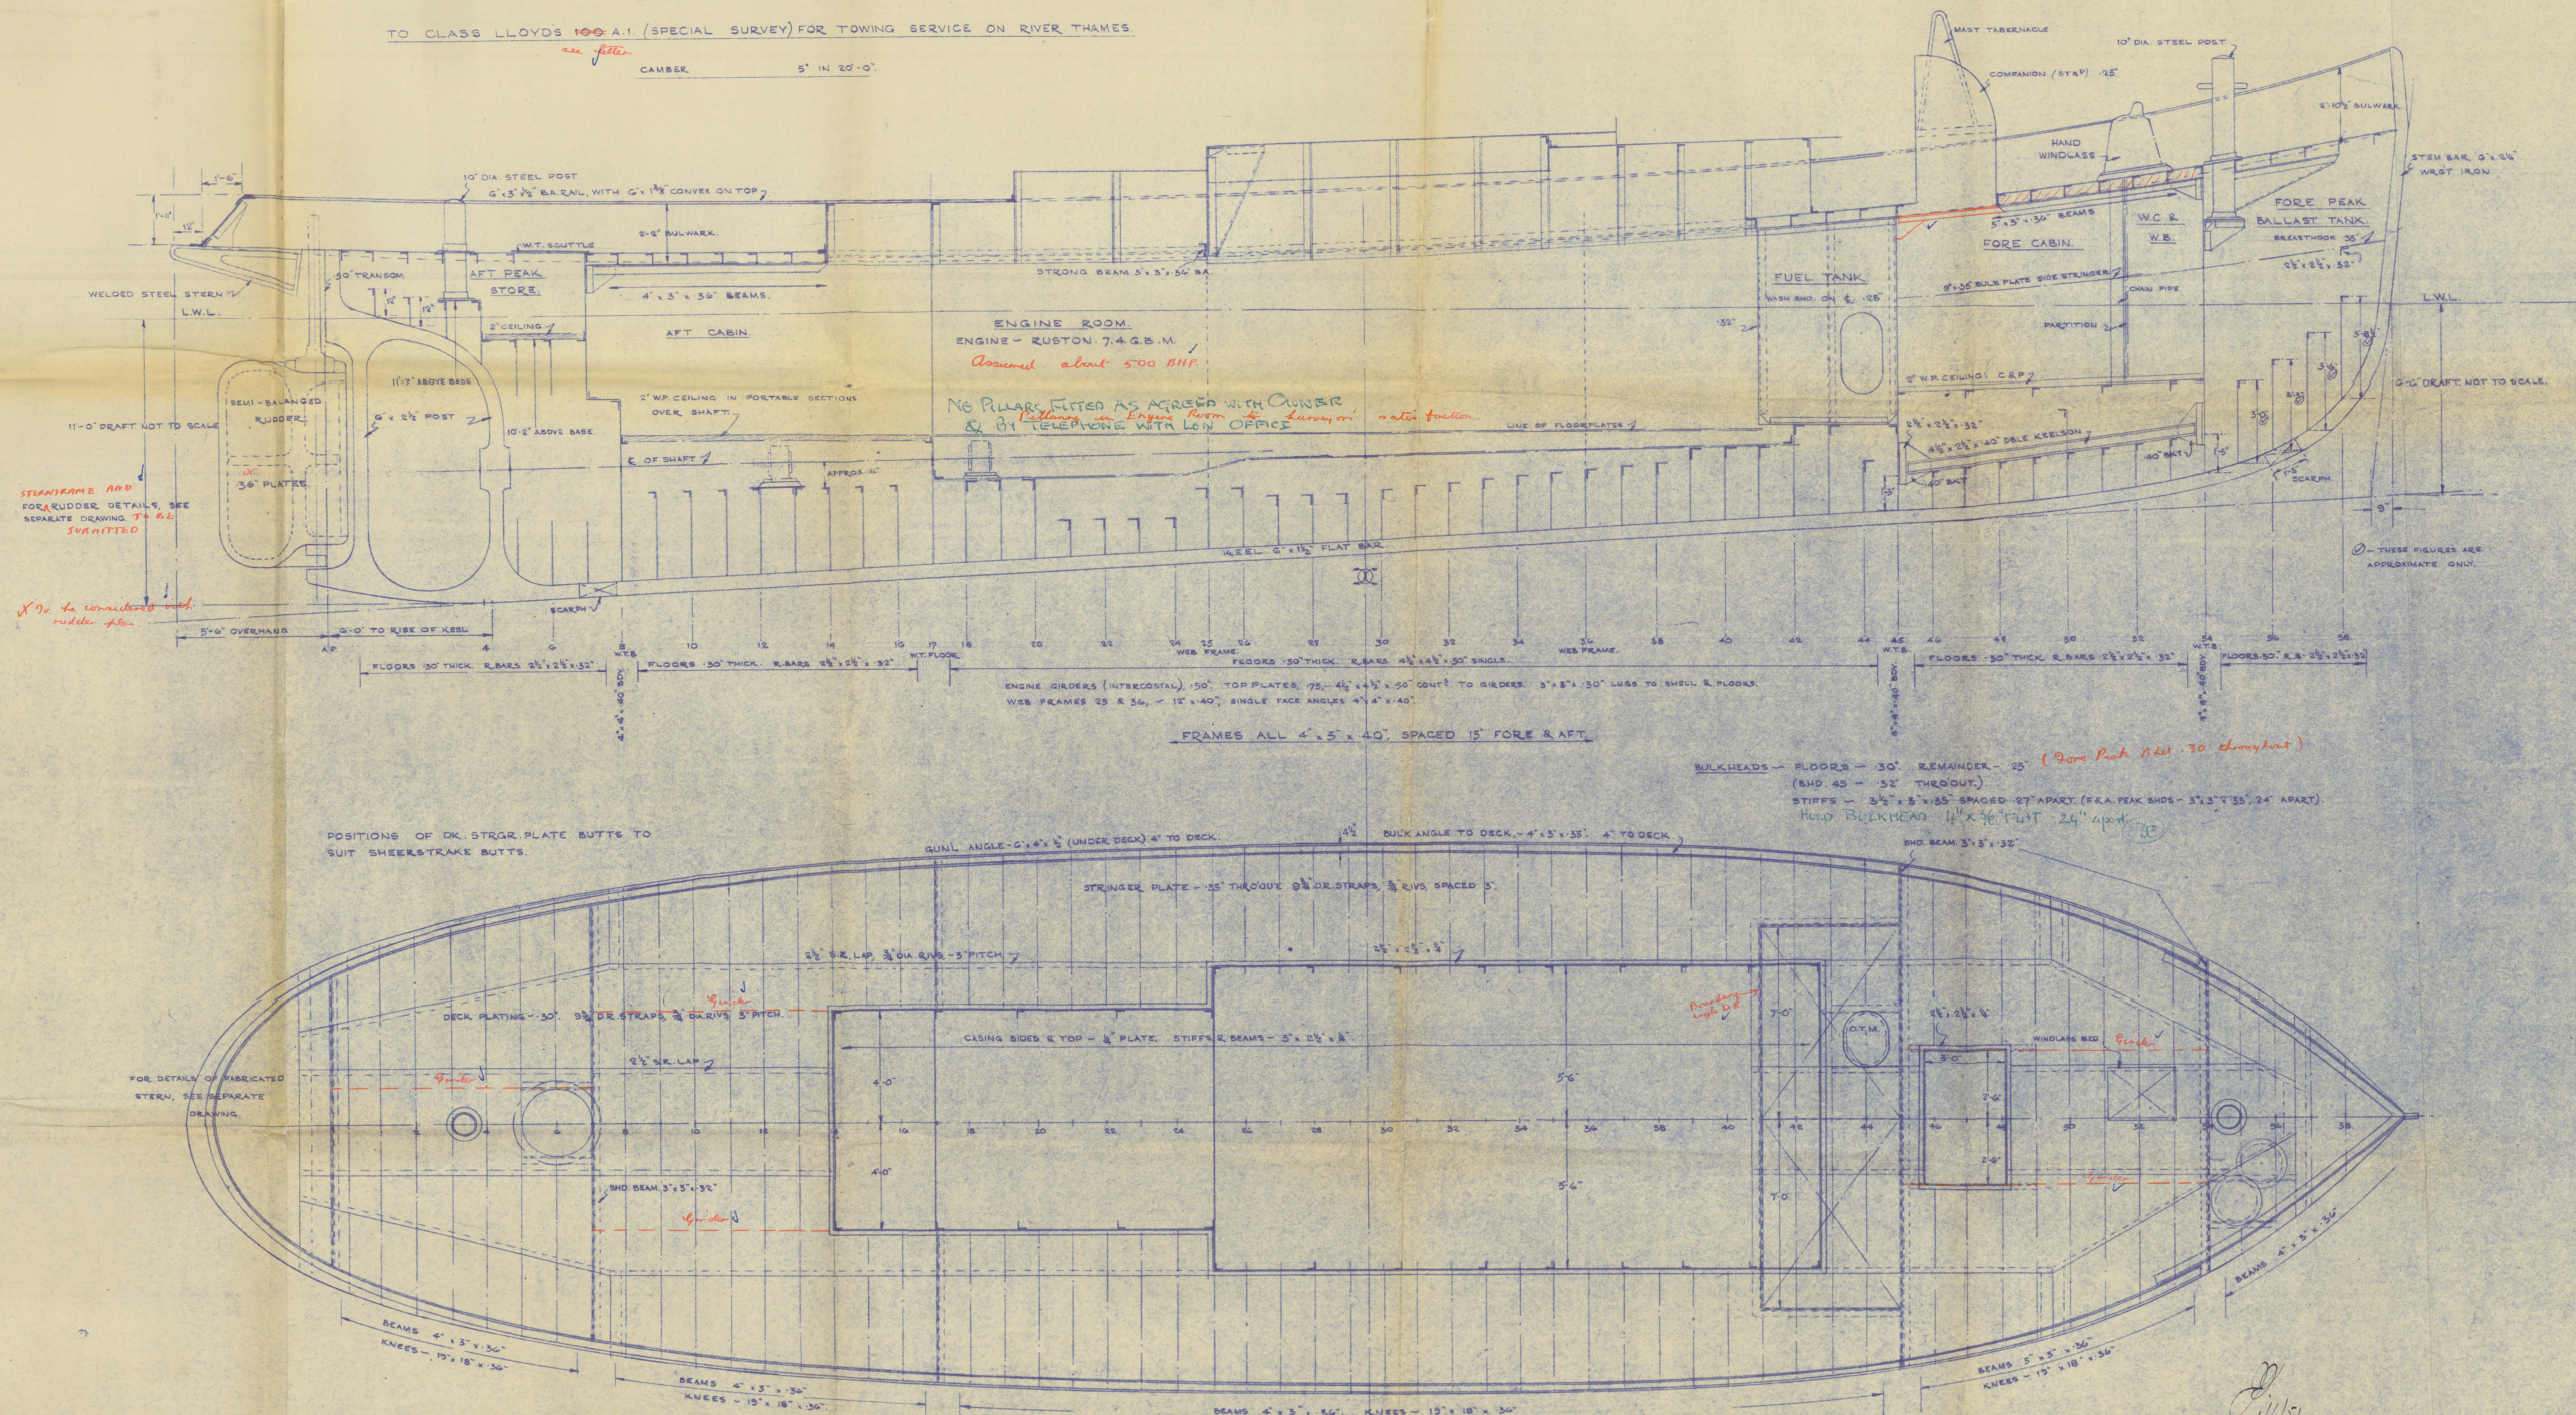

YARD No. 1241.

PLY RPT 8235

PHILIP & SONS 8235

RECORDS DEPT.
LONDON

TUG HEMBO

2

Hembo
Scantling Profile

SCANTLING PROFILE



© 2021

Lloyd's Register
Foundation

012093-012010-0112