

1501-0-11-20-24 DESIGNED TO DMS 2022

ALTERNATION FROM H-SPID ARE MARKED WITH RED

UNDER WINDS TO BE SPECIALLY STRENGTHENED & PILLARED SUITABLY

Planned no hanging cargo on holes in beam deck


Things to be suitably increased under 1000 lbs of cargo

Back to be suitably increased under 1000 lbs of cargo

DAVID KATUN
SINGLE SKEW CARGO MOTOR SHIP

CONSTRUCT PROFILE
AND
DECK PLAN

APPROVED
OCT 28 1955

K.C. 9-1

DIMENSION 148' x 205' x 125'
SCALE 1:100 CLASS NK LR
SHIP DESIGNING DEPARTMENT

CHARTERED BY
SHEWAN TOMES & CO. LTD.
HONGKONG

SHIP NO 1453 DMS 2022

K.C. 9-1

'BROOKLYN MARU' ★



Construction Profile & deck.
(Sheet 1)

SHIMONOSEKI

RPT. NO. FE1069

DATED. _____

RECORDS DEPT.
LONDON.

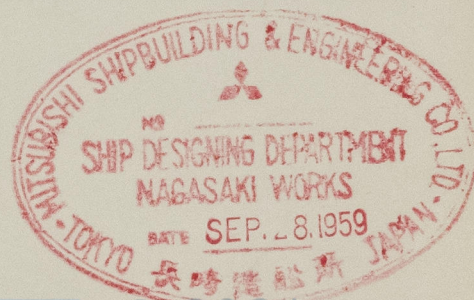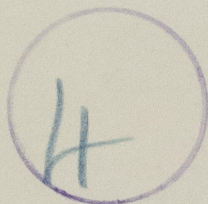

T. Okabe



Lloyd's Register
Foundation

012036-012041-0002