

DAIDO KAIUN
BROOKLYN MARU

RUDDER

(FINISHED PLAN)

DIMENSION 148"0" x 20"5" x 12"5"

SCALE 1/32 CLASS N.K.

HULL DESIGNING SECTION
SHIP DESIGNING DEPARTMENT
MAGASAKI WORKS

CHIEF OF DESIGN: *[Signature]*

HEAD: *[Signature]*

CREATED: *[Signature]*

DRAWN: *[Signature]*

DATE: *[Signature]*


SHIP NO. 1532

DWG NO. H-203

★ BROOKLYN MARU

Rudder


CERTIFIED COPY OF APPROVED PLAN	
PLACE OF APPL	K O B E
DATE	OCT. 30. 1959
CERTIFIED BY	S. Koguchi
DATE	AUG. 2 1960

SHIMONOSEKI

RPT. NO. FE1069

RECORDS DEPT.
LONDON.

12

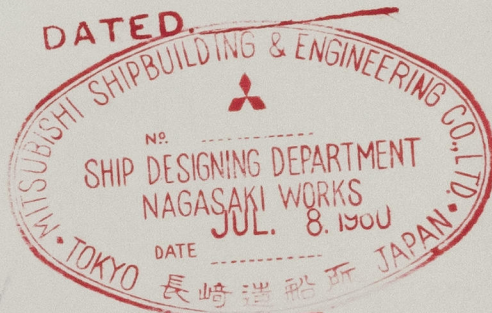

T. Okabe



© 2021

Lloyd's Register
Foundation

012036-012041-0005