




8 DET. (1/20)

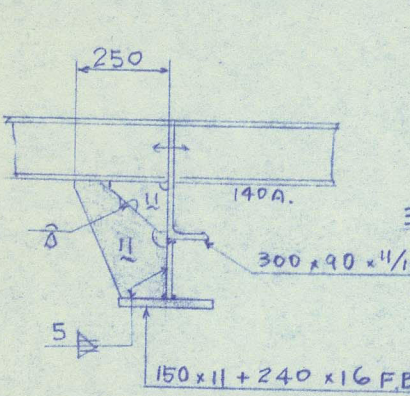


7 DET. (1/20)

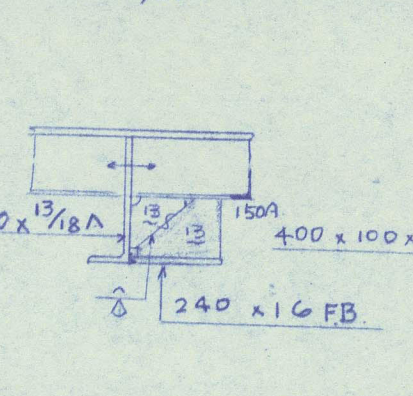


6 DET. (1/20)

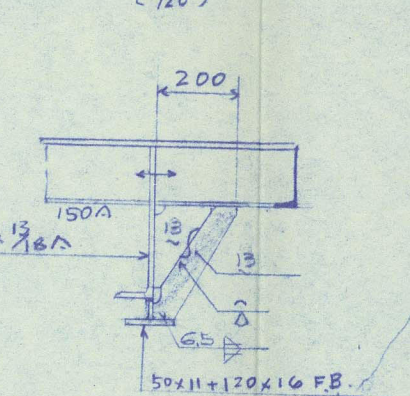

5 DET. (1/20)

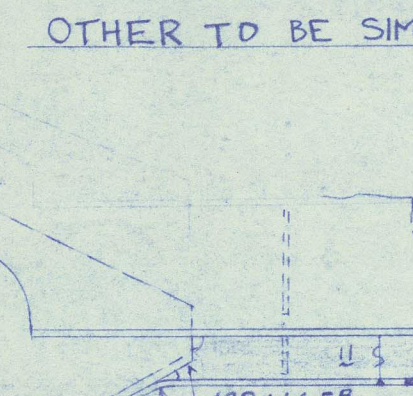

4 DET. (1/20)

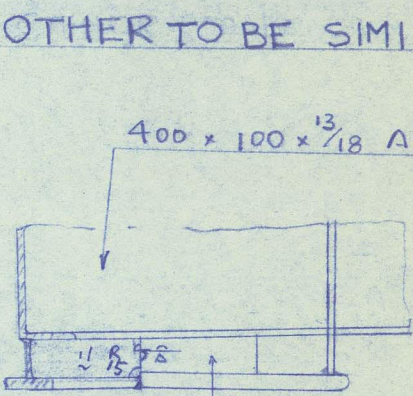

NO. 1 CHEMICAL TANK SEAT

NO. 2 & 3 C. TANK SEAT TO BE SIMI.


NOTED:-

1. PORT & STBD SIDES TO BE SYMMETRICAL UNLESS OTHERWISE NOTED.
2. ALTERED PARTS ARE MARKED RED.

注:-


1. 台の側面は、P 及び R に於いて 300% 以上。
2. 台の上端は水平とし 5 = 0.

F. 57  
F. 52, 57 TO BE SIMI UNLESS OTHERWISE NOTED  
WELDING SIMI. TO F. 135

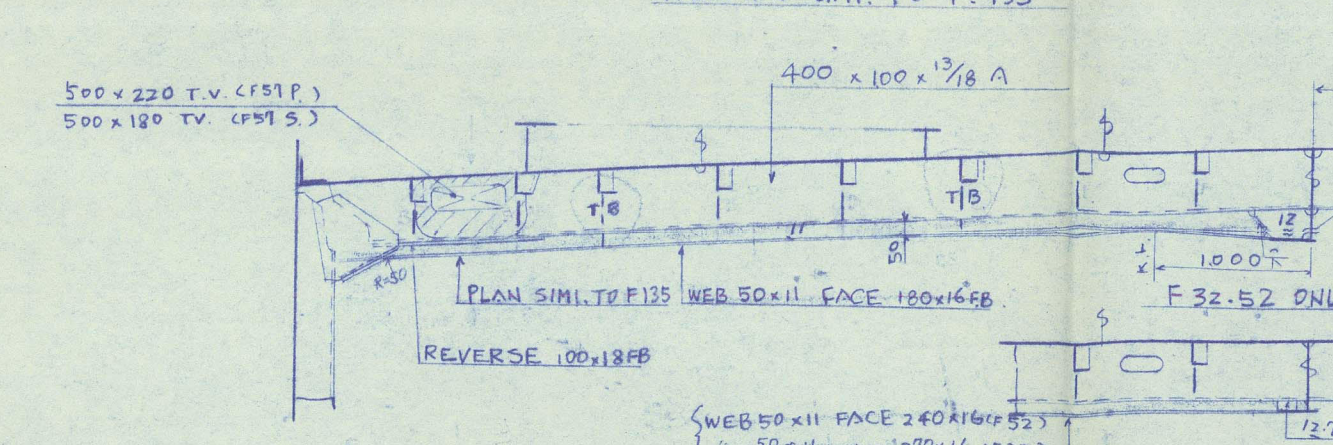

F. 135


PLAN

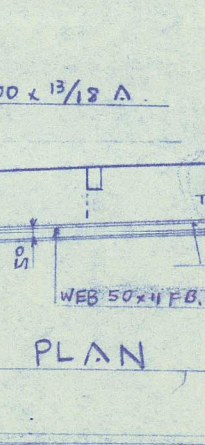

F. 26


WELDING SIMI. TO F. 135

PLAN

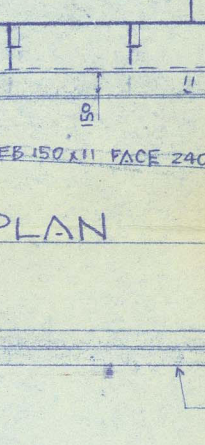




F. 130

PLAN

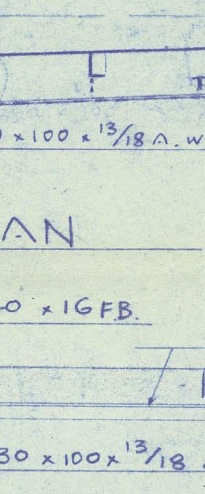

UPP. DECK PLAN

DK LONG: 150 x 90 x 9

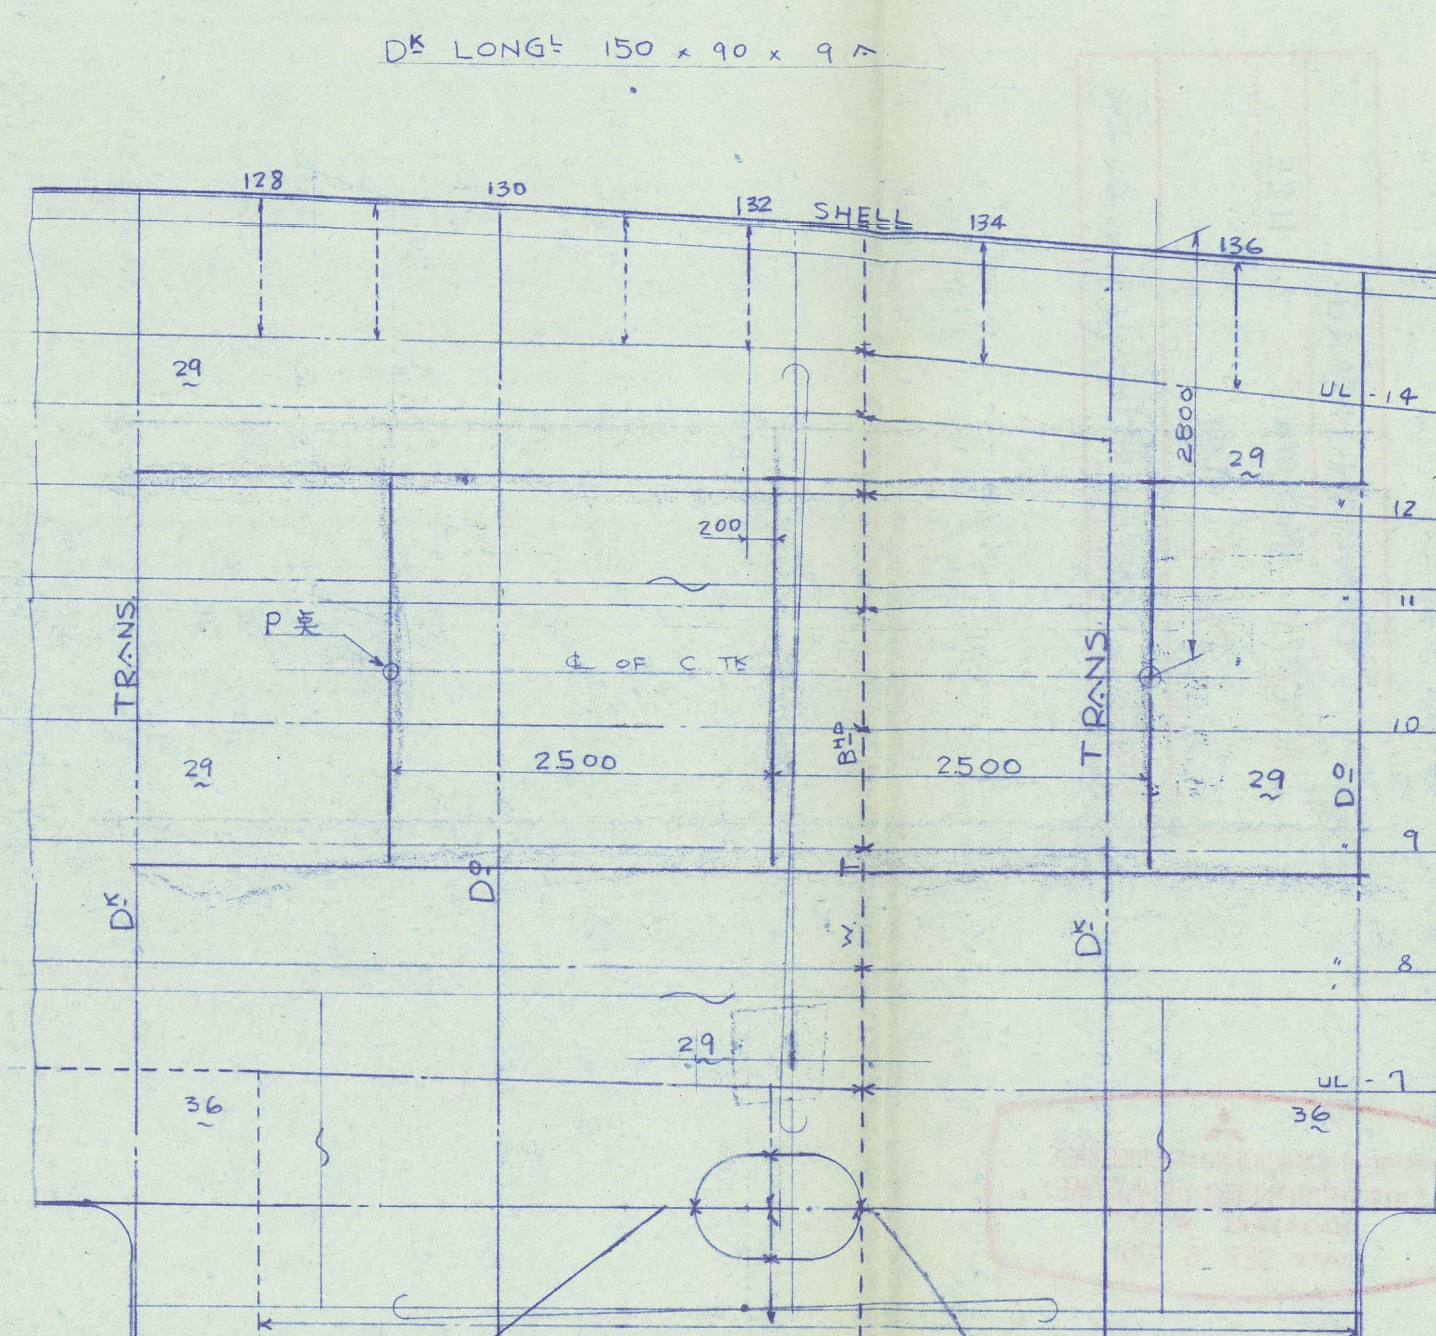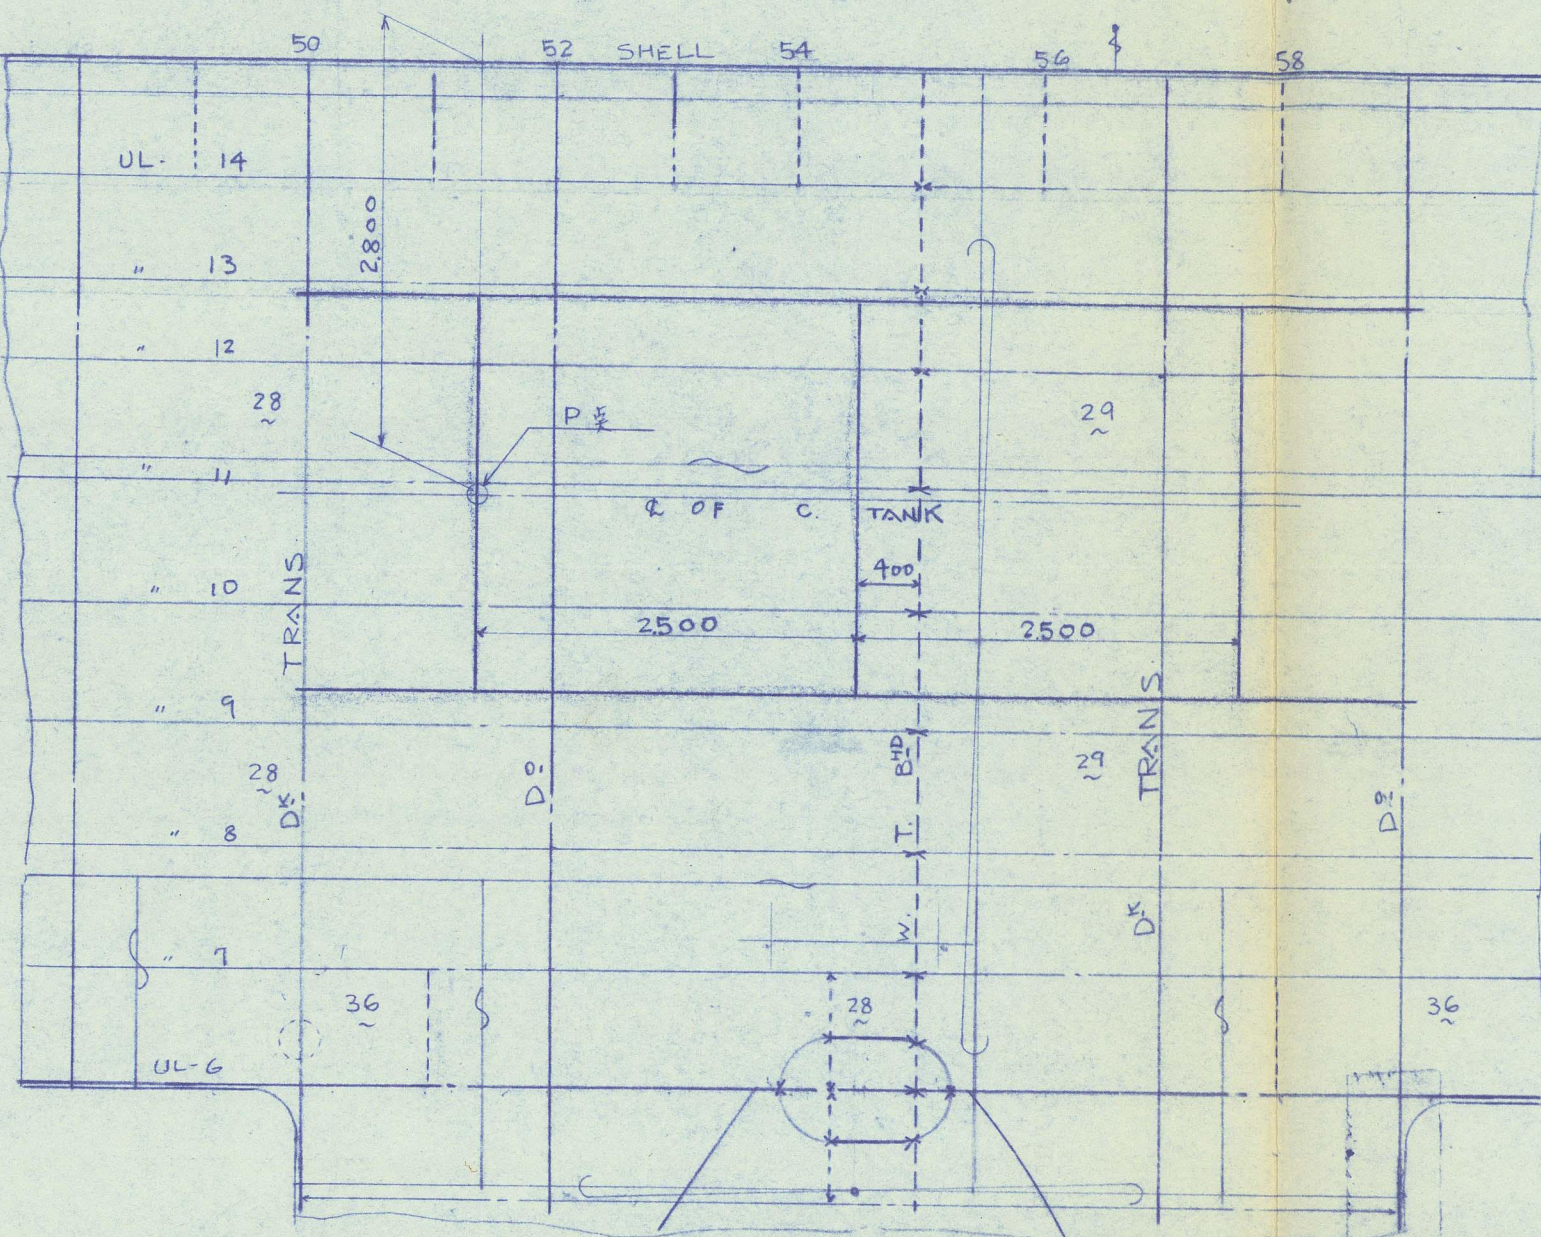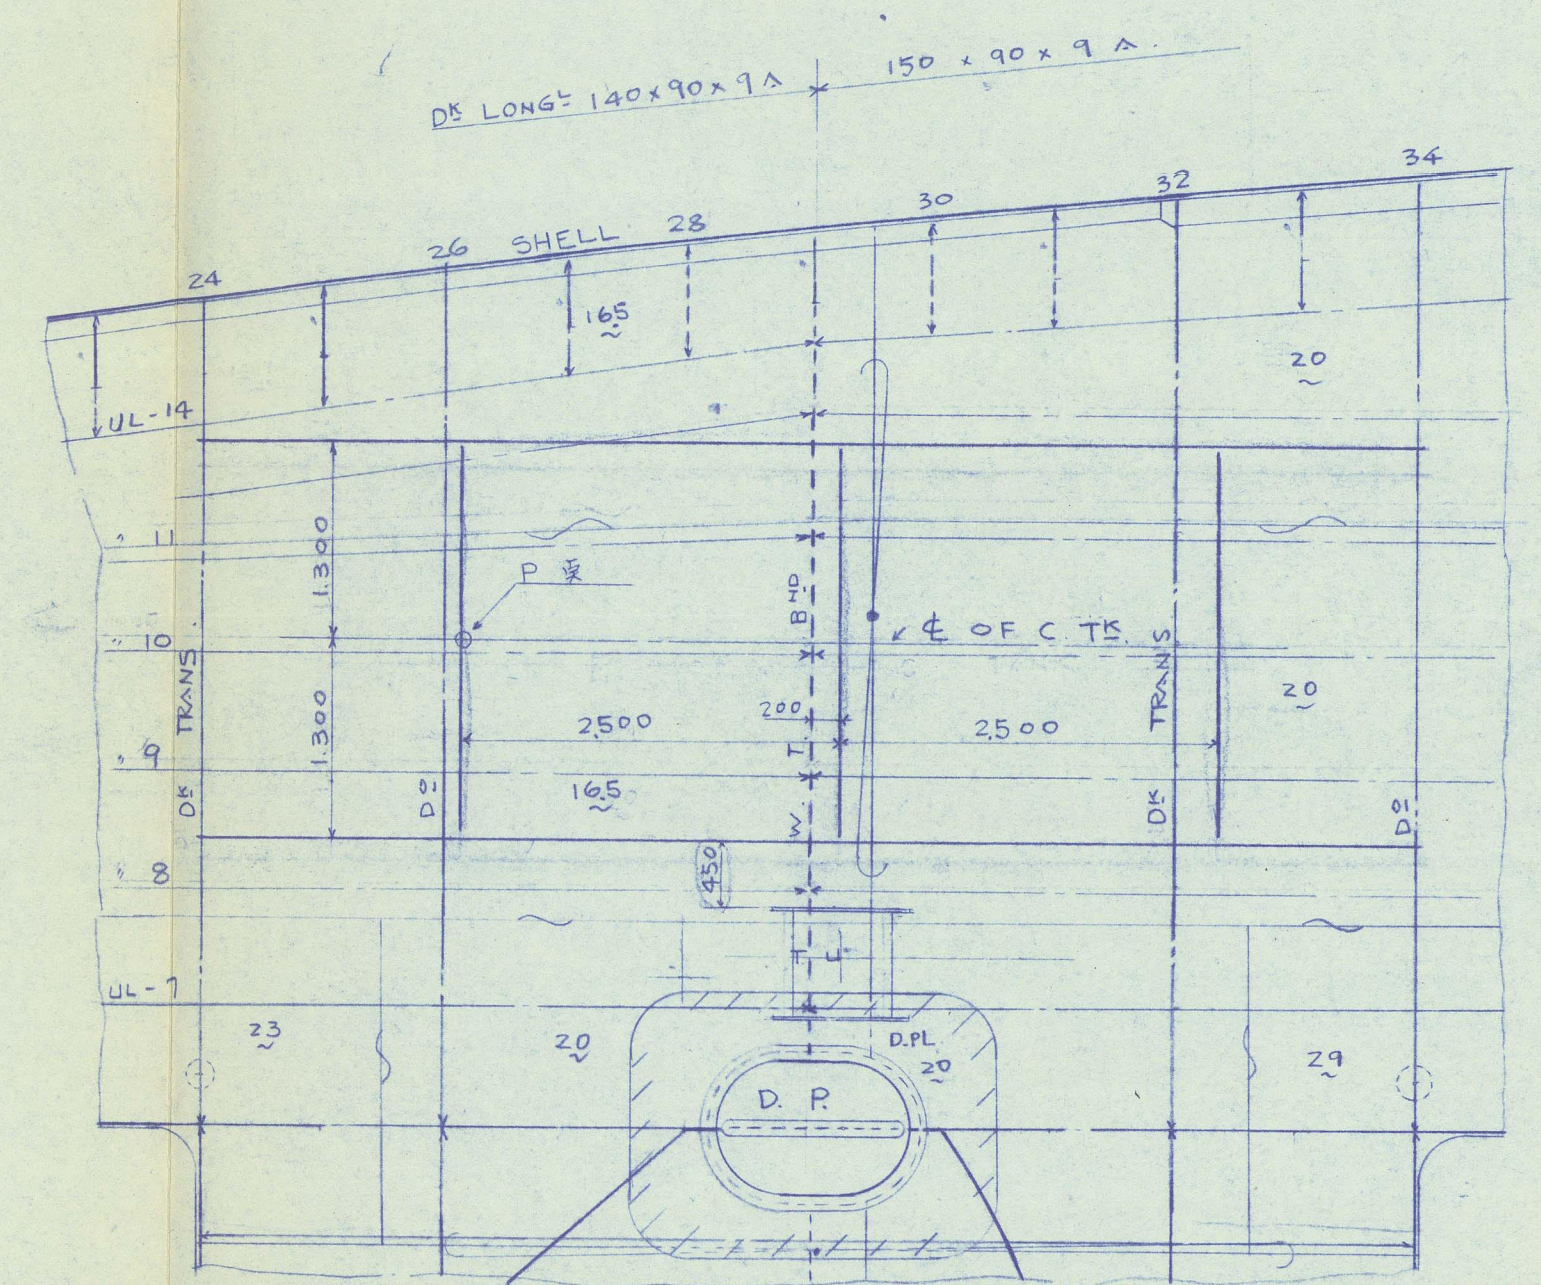


NAGASAKI RPT. 8 N. 1122

D. K. K.

BROOKLYN MARU

CHEMICAL TANK

SEAT

並下部補強

DIMENSION 148'0" x 20'5" x 12'5"

SCALE 50 CLASS L.R.

HULL DESIGNING SECTION  
SHIP DESIGNING DEPARTMENT  
NAGASAKI WORKS





DATE JULY 22-1961 REG NO.

MITSUBISHI ZOSSEN, KABUSHIKI KAISHA  
TOKYO JAPAN

SHIP NO. 22089

DWG NO. H-87 © 2024

012036-012041-0004

Lloyd's Register Foundation




圖面來歴
36-7-22 本船用として製図
36-7-31 変更図記入済

NAGASAKI RPT. 8 N° 1122

D. K. K.	
BROOKLYN MARU	
CHEMICAL TANK SEAT 並 下部補強	
DIMENSION 148"0 × 20"5 × 12"5	
SCALE 50	CLASS L.R. N.K.
HULL DESIGNING SECTION SHIP DESIGNING DEPARTMENT NAGASAKI WORKS	
CHIEF OF DEPT CHIEF <i>E. Fujita</i>	
HEAD <i>T. Nakamura</i>	
CHECKED <i>L. Suehata</i>	
DRAWN <i>H. Gusa</i>	
DATE JULY-22-1961	REG NO.
MITSUBISHI ZOSEN KABUSHIKI KAISHA TOKYO JAPAN	
SHIP NO. 22089	
DWG NO. H-87	

"MS" BROOKLYN MARU	TO ACCOMPANY NAGASAKI Rpt. No. 1122	Dated 9.61	SUBJECT :- SEATS ETC. FOR PORTABLE TANKS ON D.K.
--------------------	-------------------------------------	------------	--

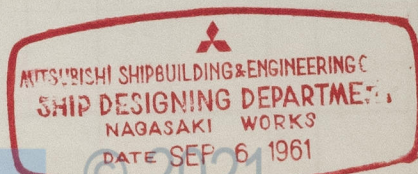

*E. Fujita*  
Lloyd's Register  
Foundation