


Class # Oil Tanker

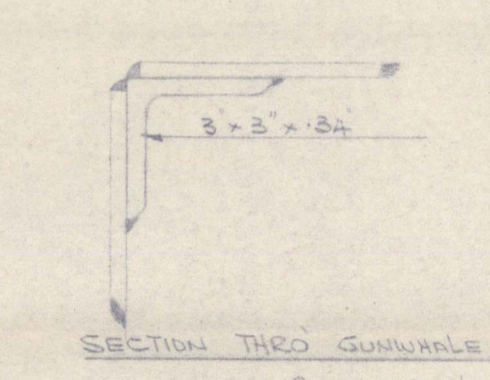

Doublings to
be fitted

~~INSERT PLATES TO HAVE 3° RAO CORNERS.~~

'AFPET 6'

ARDROSSAN DOCKYARD LTD.

YARD N° 432.

N° 1.

CONSTRUCTIONAL PLAN.

GLASGOW. 1ST ENTRY REPORT N° FEB 38



© 2021

Lloyd's Register
Foundation

012047-02057-0162