




Lloyd's Register of Shipping.

Ship's Name M/V "ALOUETTE"

Official No. 166481

Memorandum of alterations reported since ship was surveyed for assignment of Load Lines in June 1938.

As a War Emergency measure, alterations have been carried out, for the accommodation of extra personnel, as shown in the sketches given below.

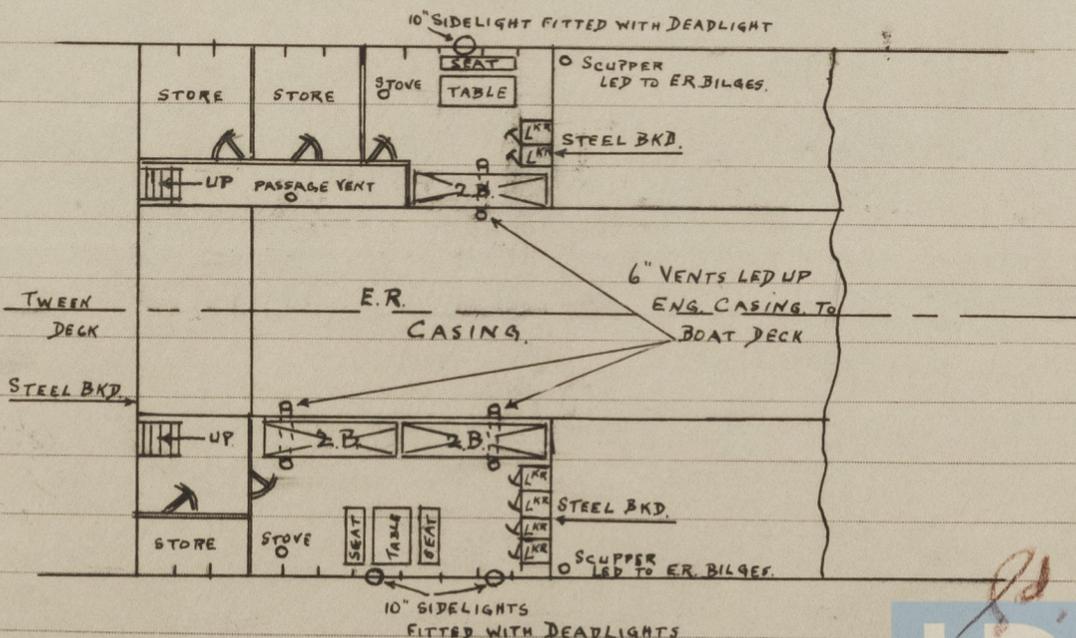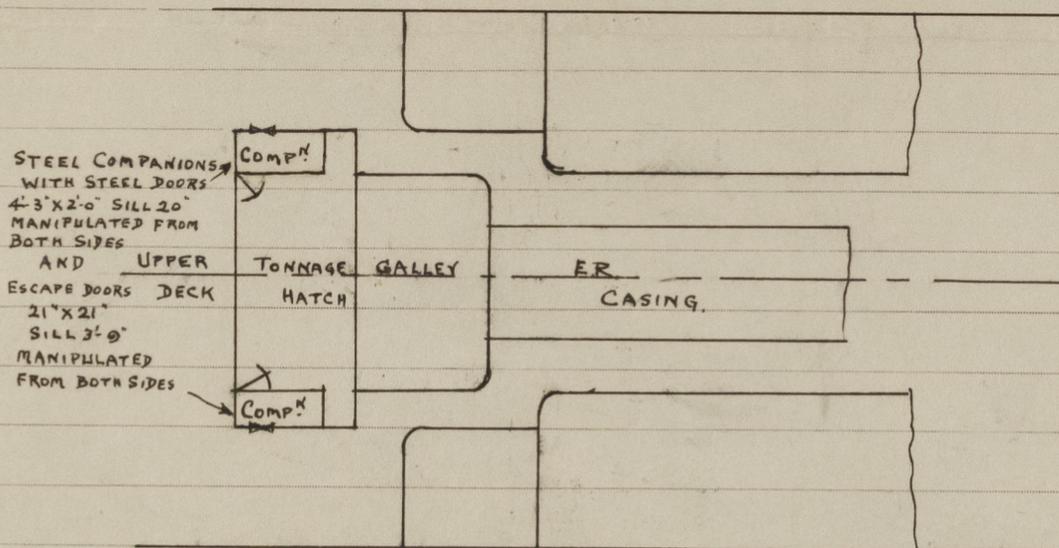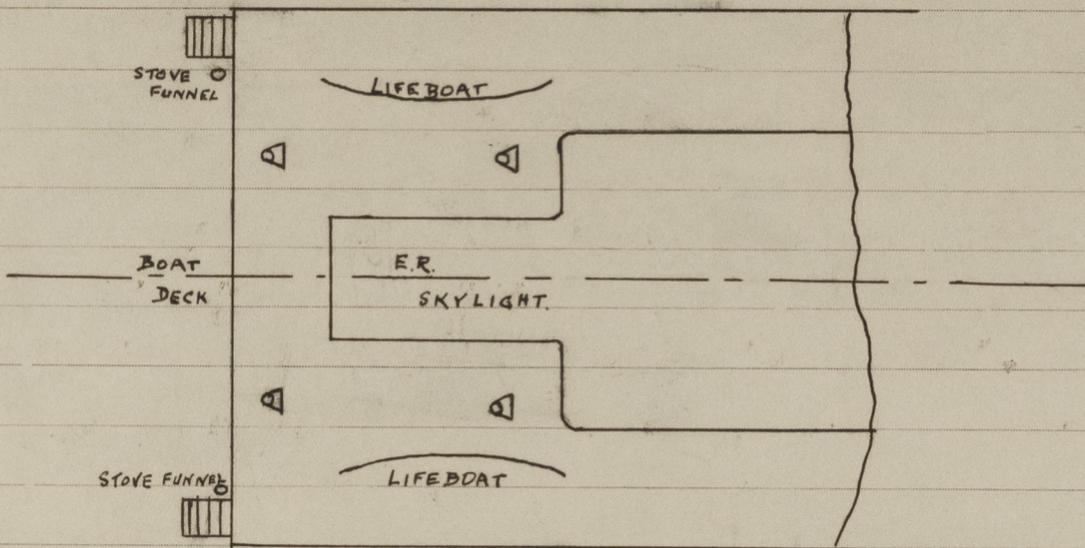

W. Sed
T. W. B.
-9 JUL 1943

R. J. Houston
© 2021
Lloyd's Register
Foundation