

5.5 "VASCO"




RULE DIMENSIONS 219'-0" ON L.W.L. \times 34'-5" MLD \times 17'-5" DEPTH MLD TO UPPER DK.
21'-33" DEPTH MLD TO RAISED GUAETER DK

PROFILE of DECKS (AS BUILT).

ROBERT DUNCAN & Co's No. 373.

S. S. "VASCO"

GRK. REPORT N^o 18574.

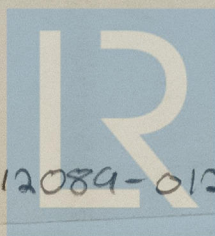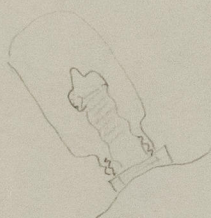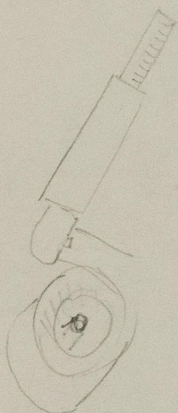

© 2021

Lloyd's Register
Foundation

012084-012095-0142