


MATERIAAL SMEEDSTAAL.

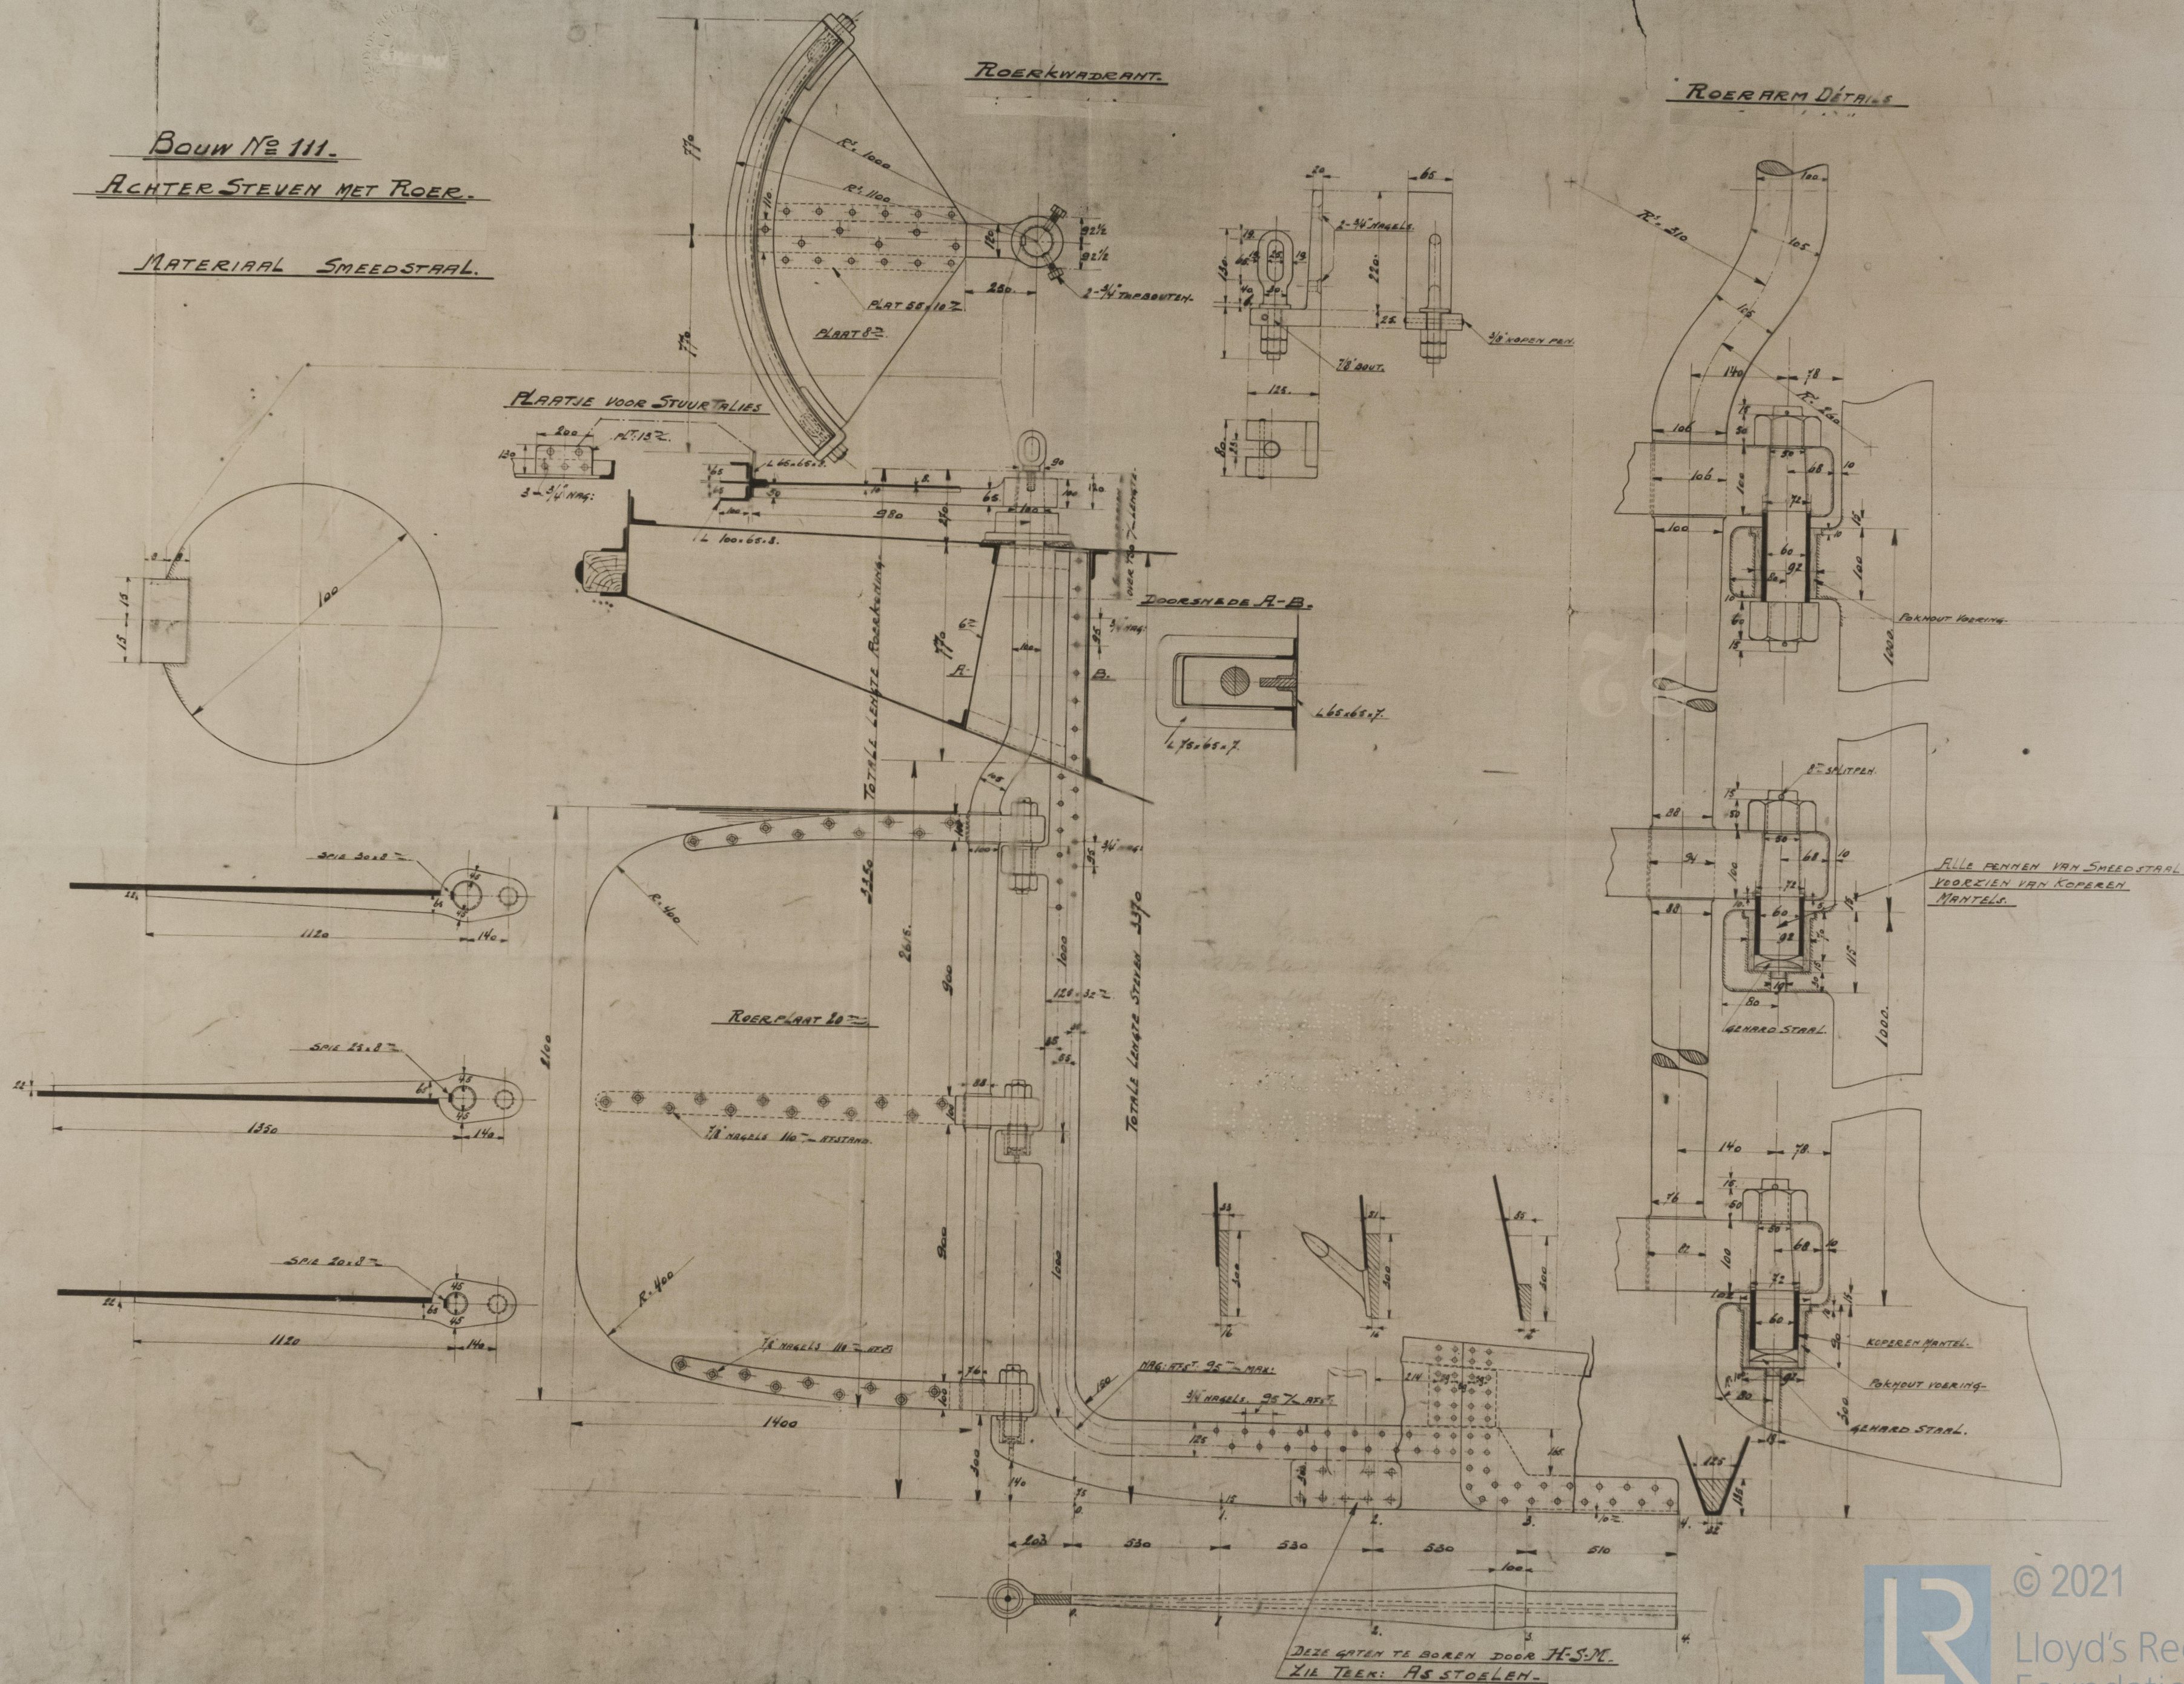

"SHELL 15" ★

~~SEA~~ STERNFRAME &
RUDDER.

3



© 2021

Lloyd's Register
Foundation

012084-012015-0252