


| DIMENSIONS | | | |
|-------------------|--------------|-----------|---------|
| LENGTH | OVERALL | 149,411 m | 490' 0" |
| LENGTH | BETWEEN P.P. | 143,253 m | 470' 0" |
| BREADTH | MOLDED | 22,860 m | 75' 0" |
| DEPTH | | 10,363 m | 34' 0" |
| FREEBOARD - DRAFT | | 7,162 m | 23' 6" |

 

S.S. AUSTRALIAN PROGRESS
Nagasaki J.R.T. 16 FEB 1921

AUSTRALIAN PROGRESS
GENERAL
ARRANGEMENT
(FINISHED PLAN)

SCALE 1/500 CLASS
OUTFITTED FOR "HILL" SECT.
SASEBO SHIP YARD
HIP DESIGN DEPT.
DEPT. CHIEF
IN CHARGE
CHECKED
DRAWN
DATE
DRAWING NO.


012046-012101-0237

Lloyd's Register
Foundation

AUSTRALIAN PROGRESS ★

GENERAL ARRANGEMENT.

RECORDS DEPT.
LONDON.

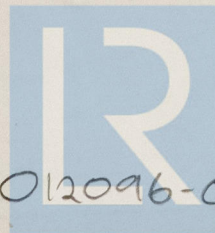

© 2021

Lloyd's Register
Foundation

012096-012101-0237