



OR FORGED
 RUDDER FRAME FORGED, WITH CAST STEEL ARMS SHRUNK ON & KEYED.
 ELL POST TO BE OF CAST STEEL.

DETAIL OF TOP GUDGEON
 SCALE 3" = 1 FOOT.

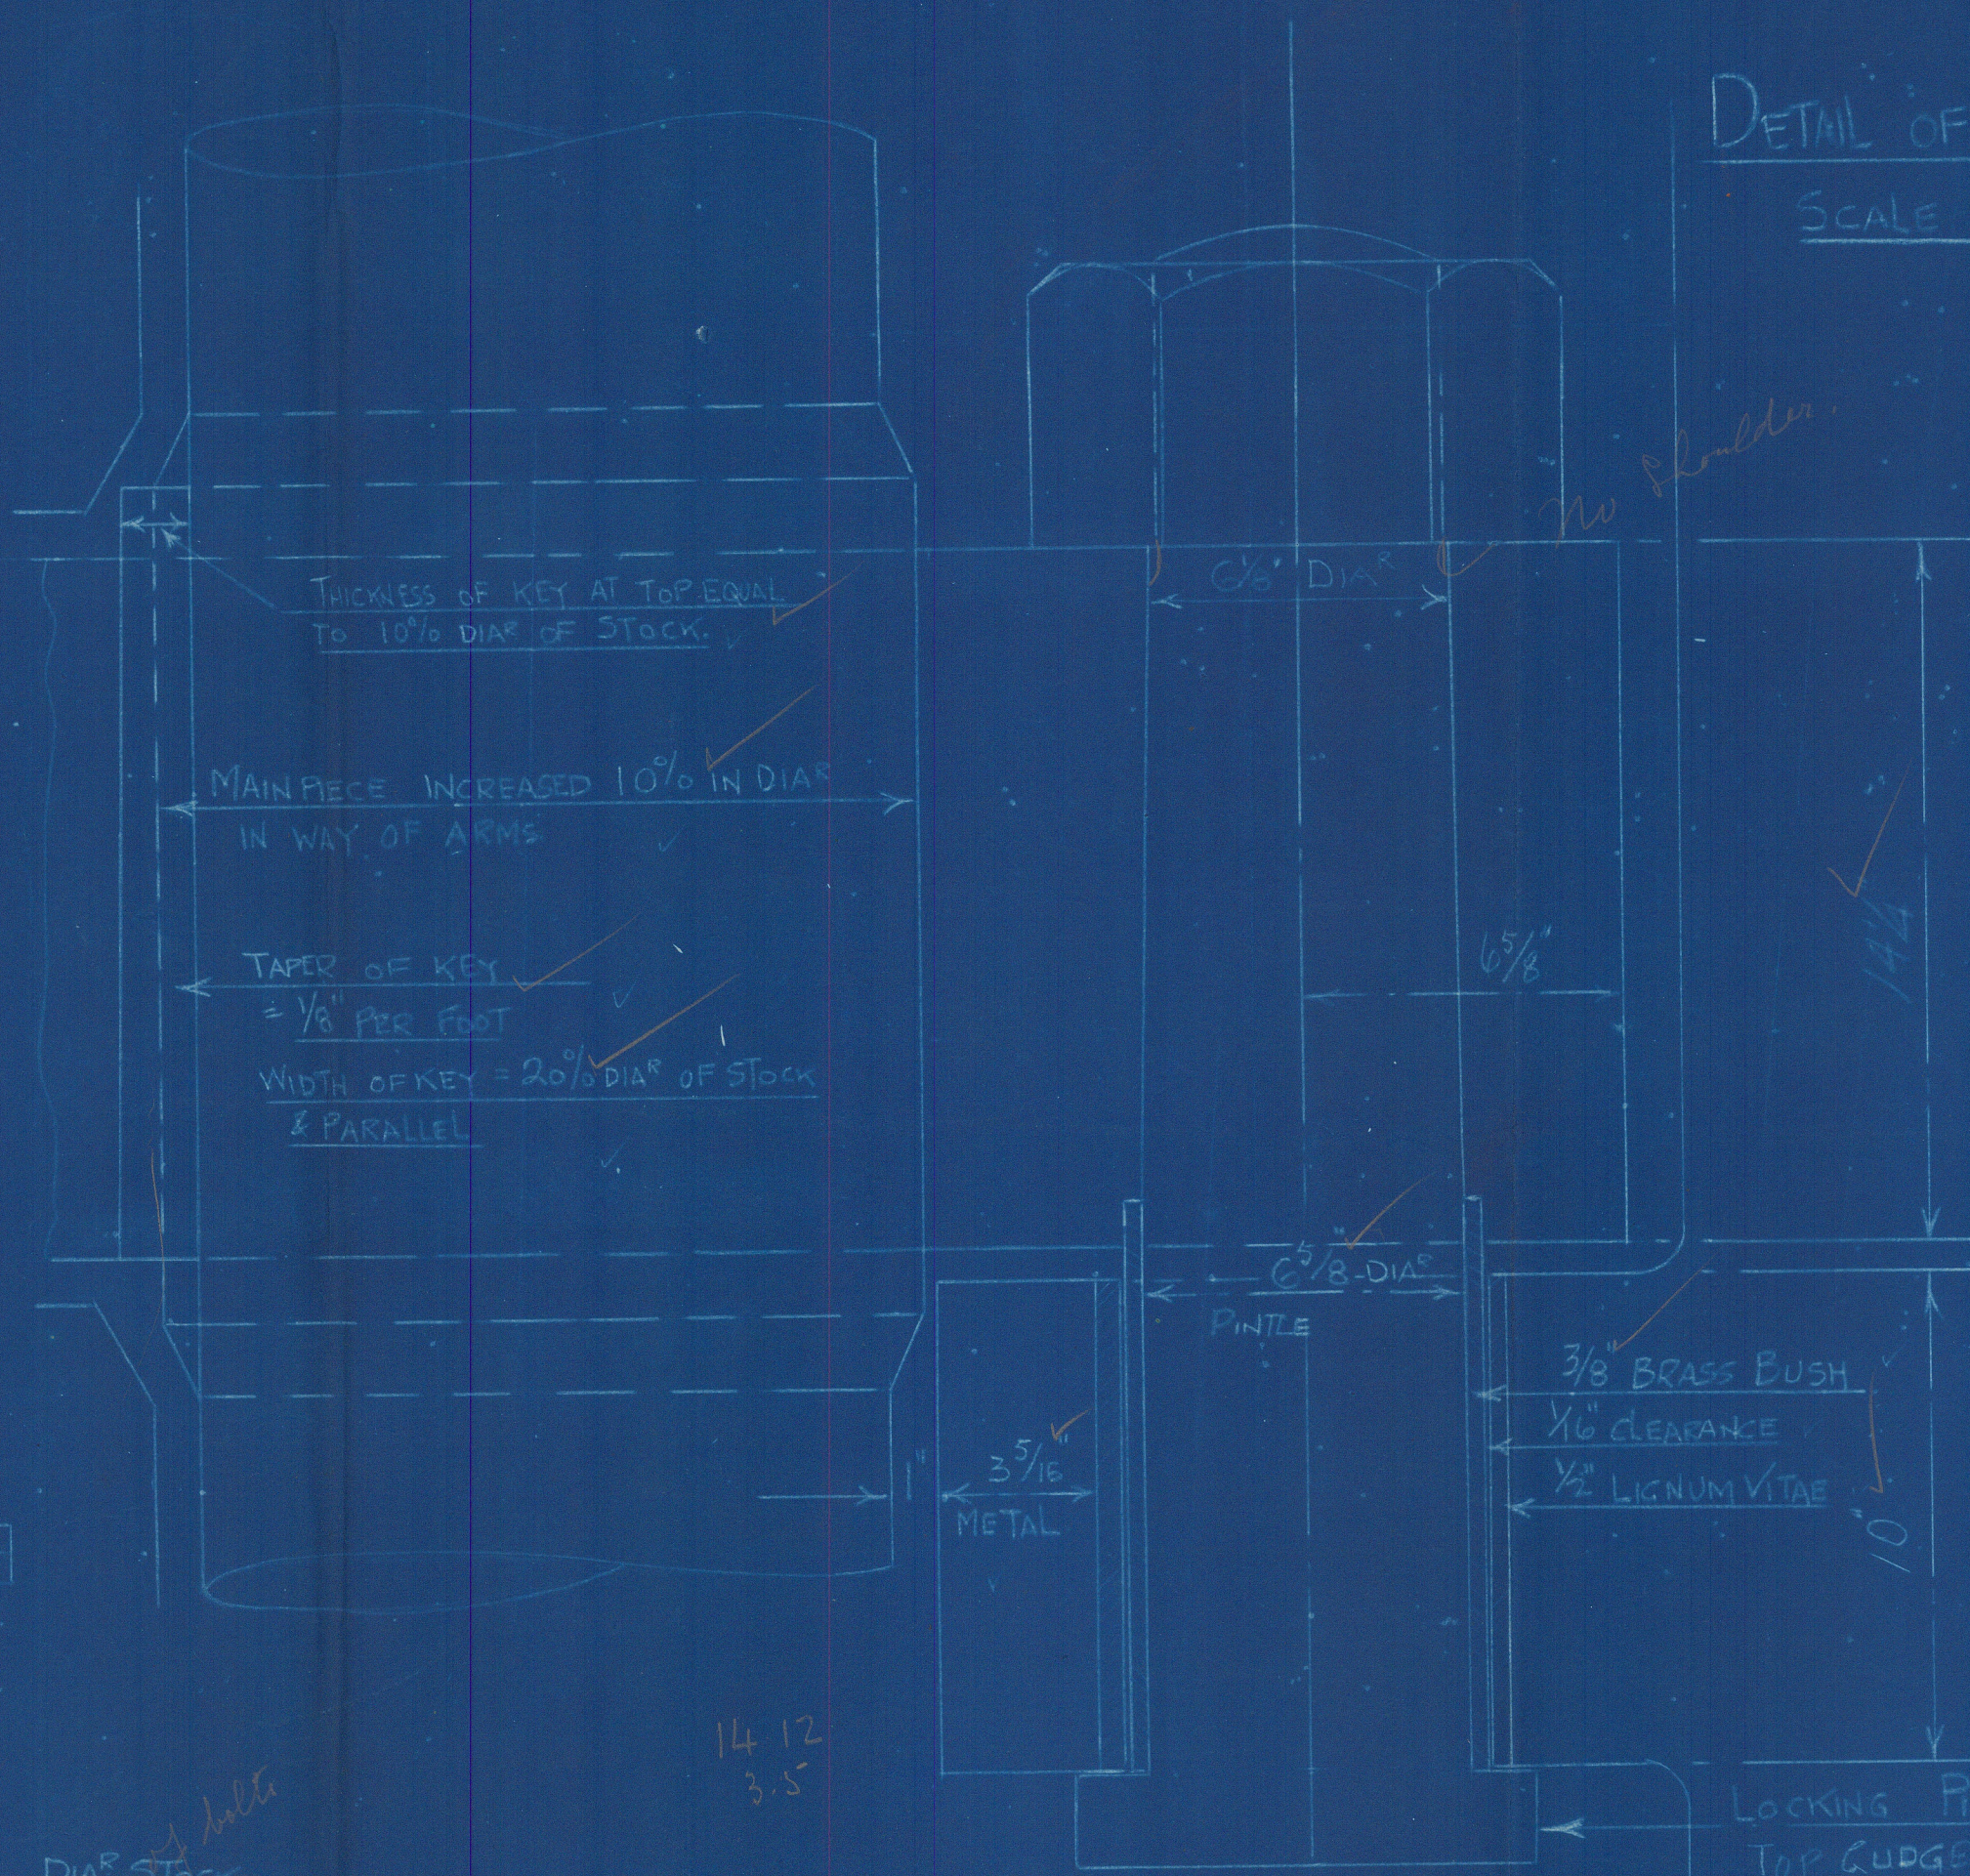

8 OCT 1928
 Approved
 3-10-28
 & Provisionally on behalf
 of B.L.

DETAIL OF LOWER GUDGEONS
 SCALE 3" = 1 FOOT.

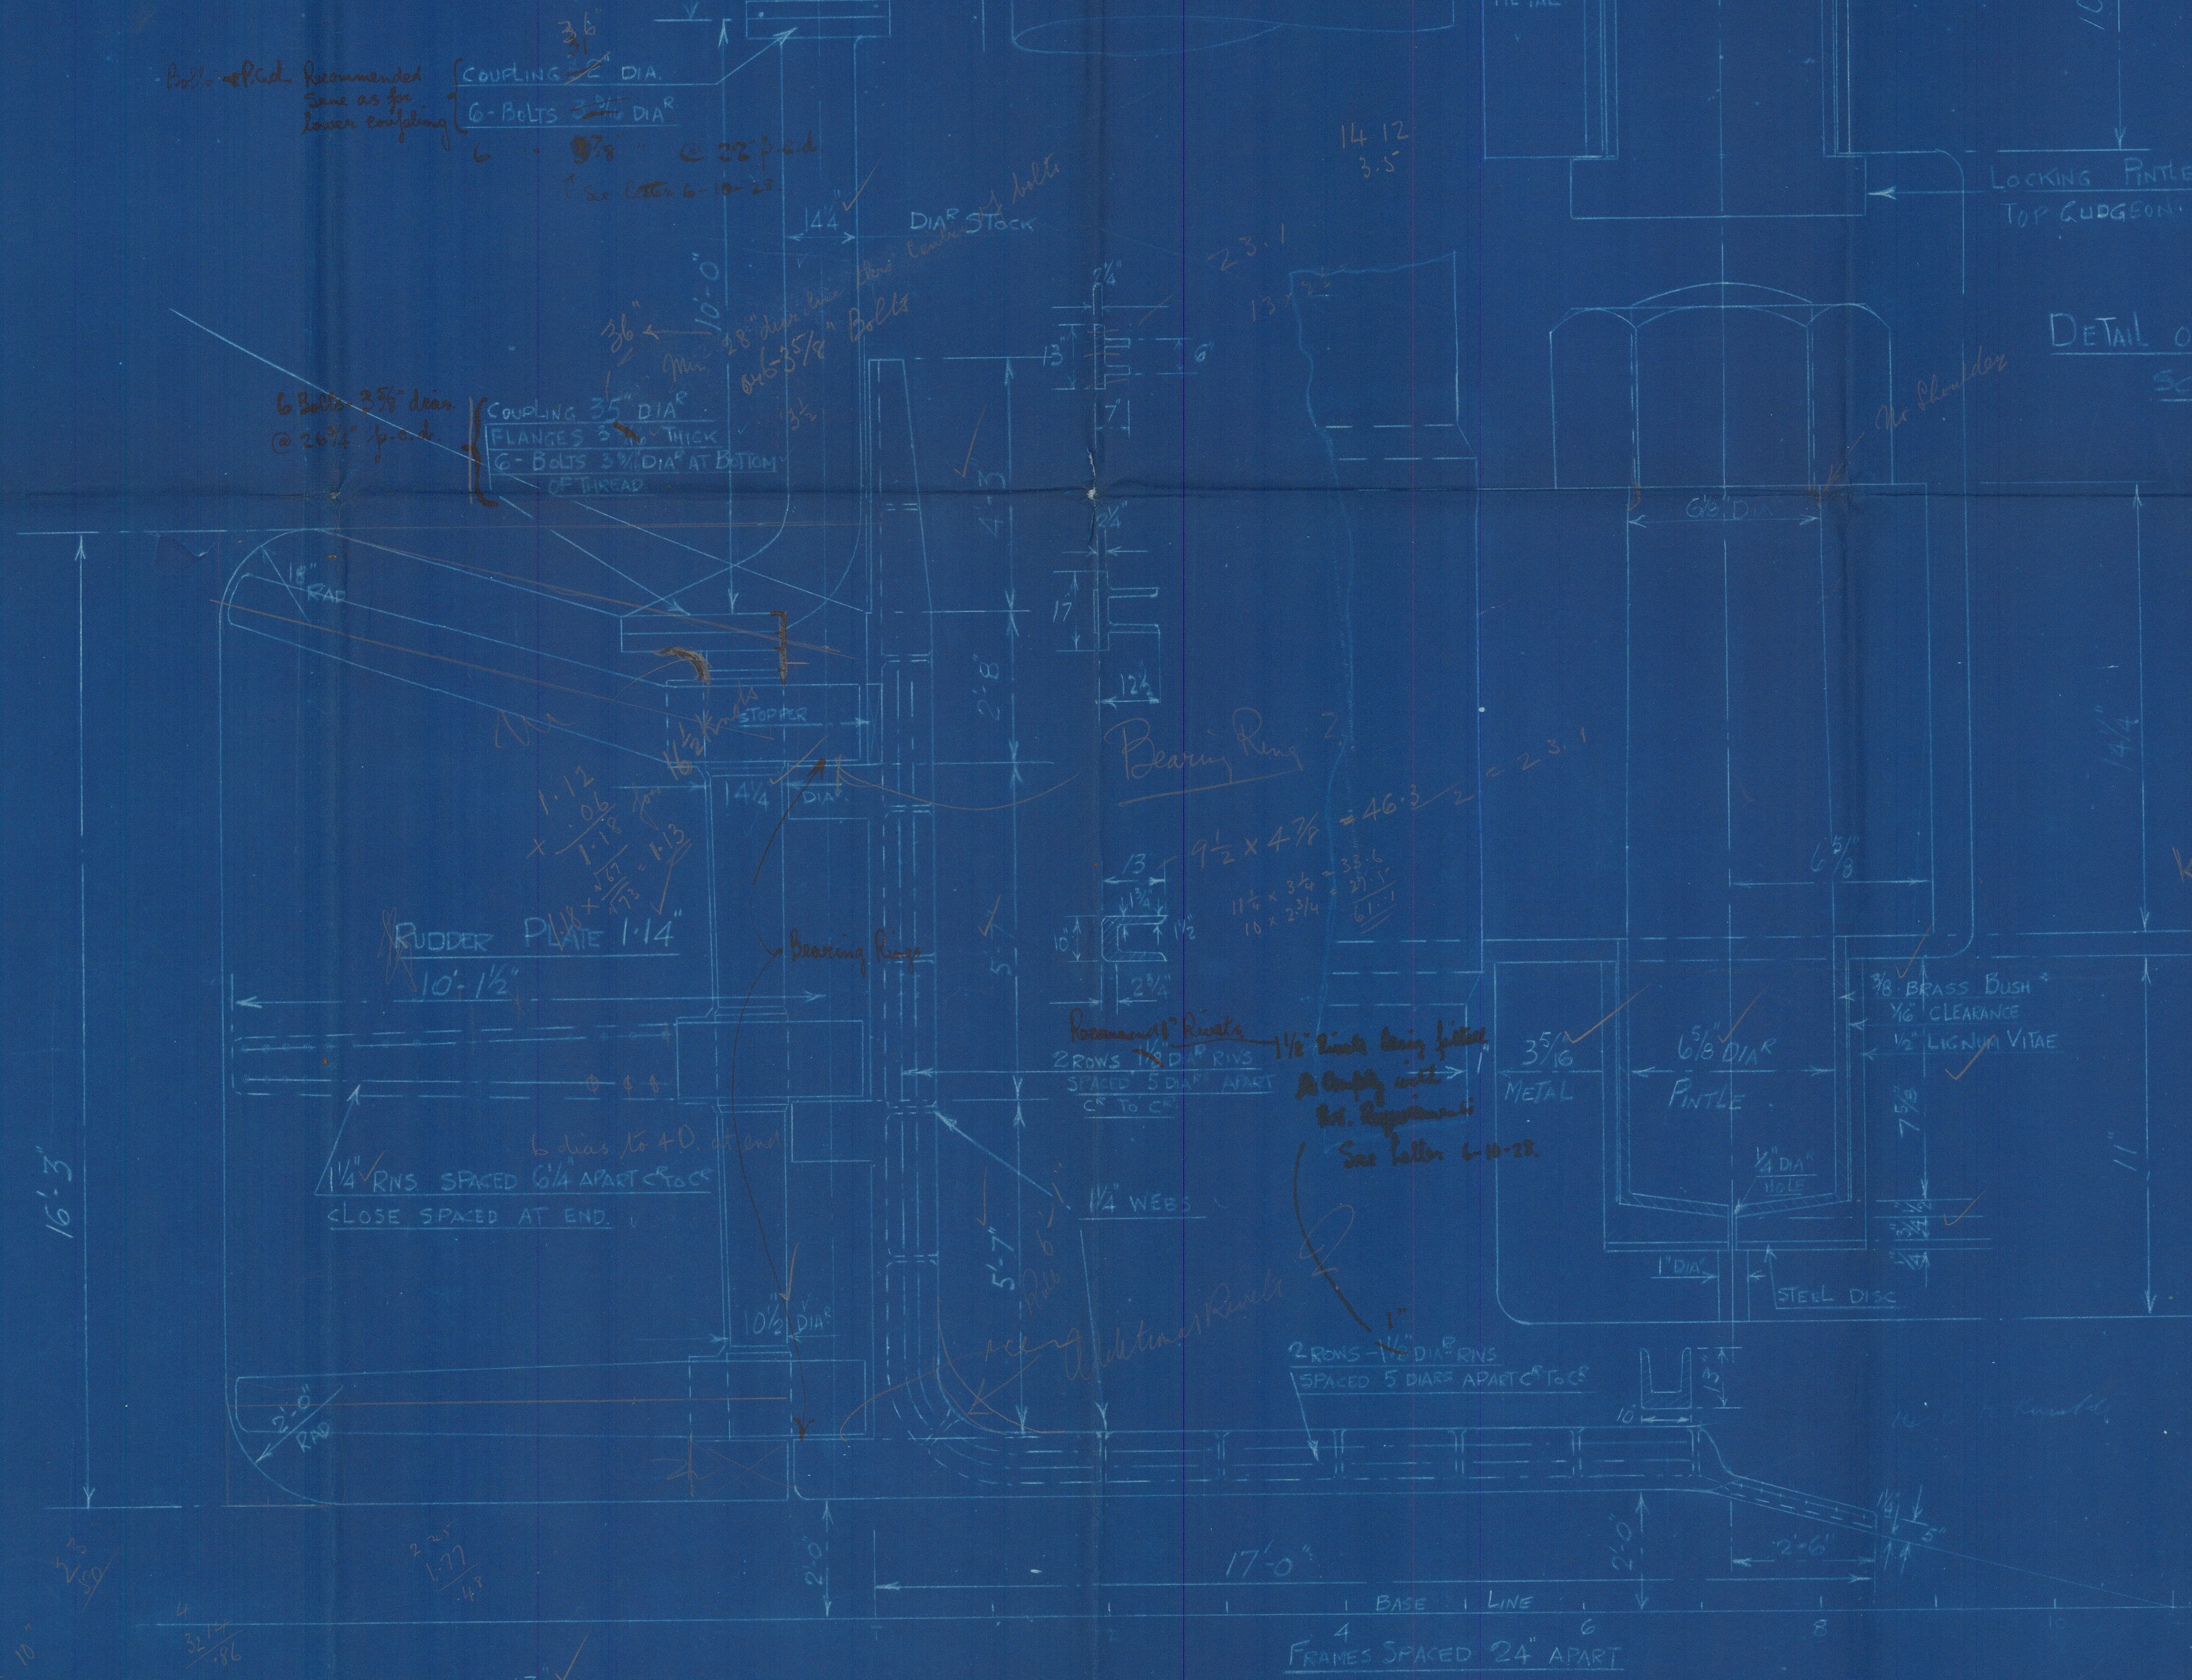

$$\frac{4}{3} \times \frac{57}{4} = \frac{35}{1} = 4.715$$

$$\frac{35}{3} = 11.666$$

$$\frac{11.666}{1.31} = 8.89$$

$$\frac{7}{8} \times \frac{29}{1} = \frac{203}{8} = 25.375$$


$$\frac{25.375}{1.31} = 19.36$$

$$\frac{35}{1} \times \frac{29}{1} = \frac{1015}{1} = 1015$$

N° 1302.
 RUDDER FRAME.
 ELL POST.

SCALE 1/2" = 1 FOOT

AREA OF RUDDER = 156 SQ FT
 CENTRE OF GRAVITY AHEAD = 5.25 FT
 Q OF PINTLES = 16 1/2 ON TRIAL
 DIA OF RUDDER STOCK = 14 1/2

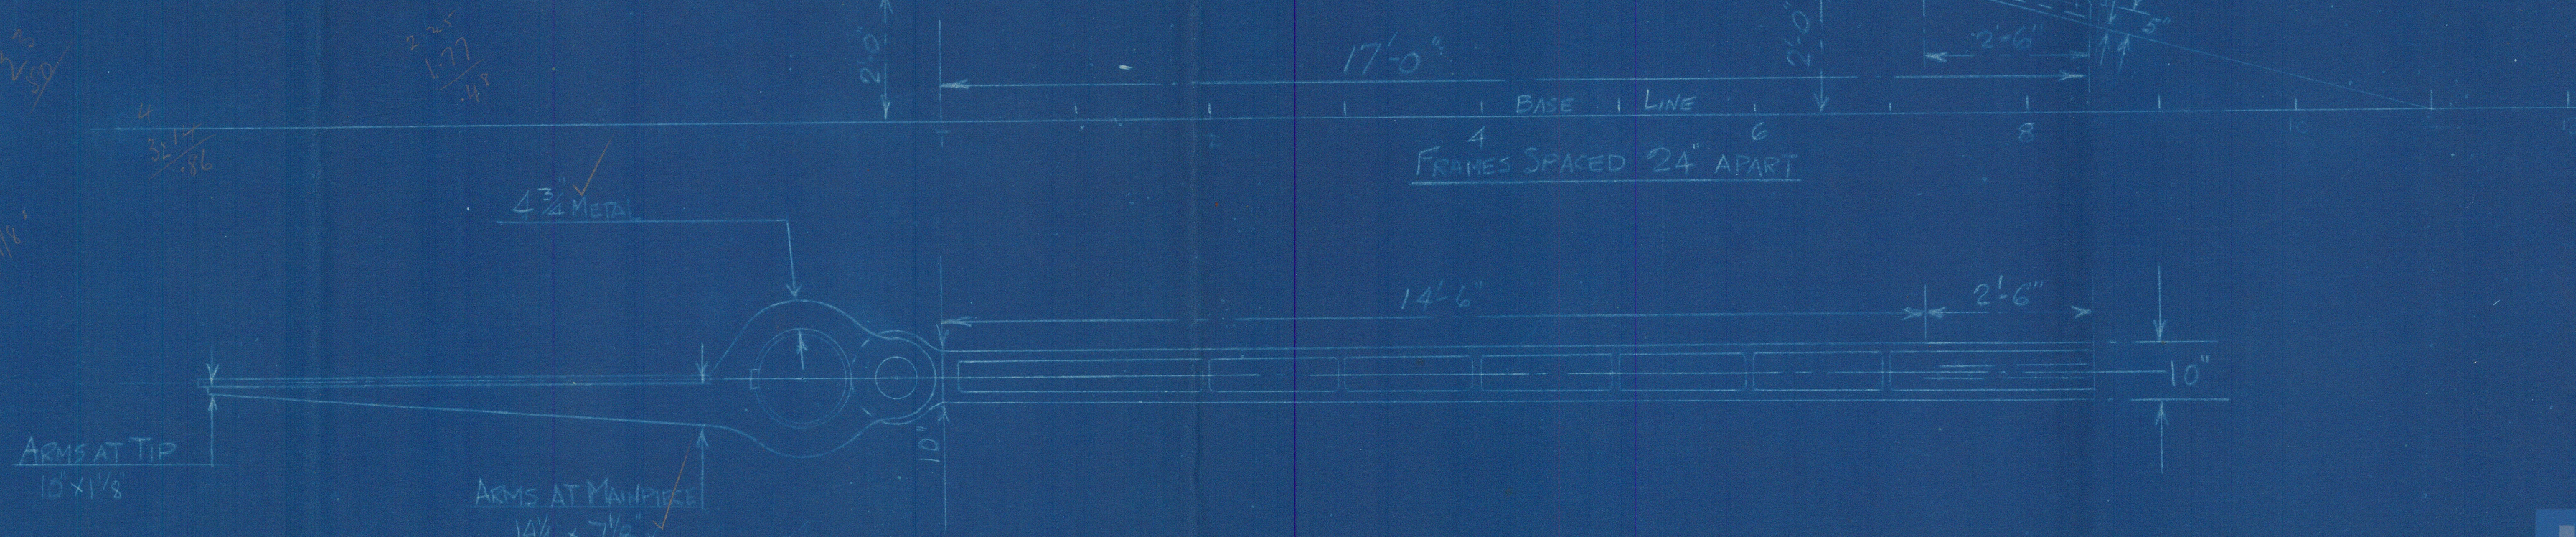

36727
 2-10-28
 10

TRANSFERRED TO:
L. R. SYSTEM

13

For Rudder Plan see N^o 23.

Rudder ^YFrame & Coll Post.

Swan Hunter & W.R.

N^o 1302.

3 " 10 - 28.

"Campana"

TRANSFERRED TO:
L. R. SYSTEM

TRANSFERRED TO:
L. R. SYSTEM



© 2021

Lloyd's Register
Foundation

012102 - 012107 - 0005

Bag

012102-012107-0005



© 2021

Lloyd's Register
Foundation