



3 OCT 1928



VIEW AT FORE END
LOOKING AFT.

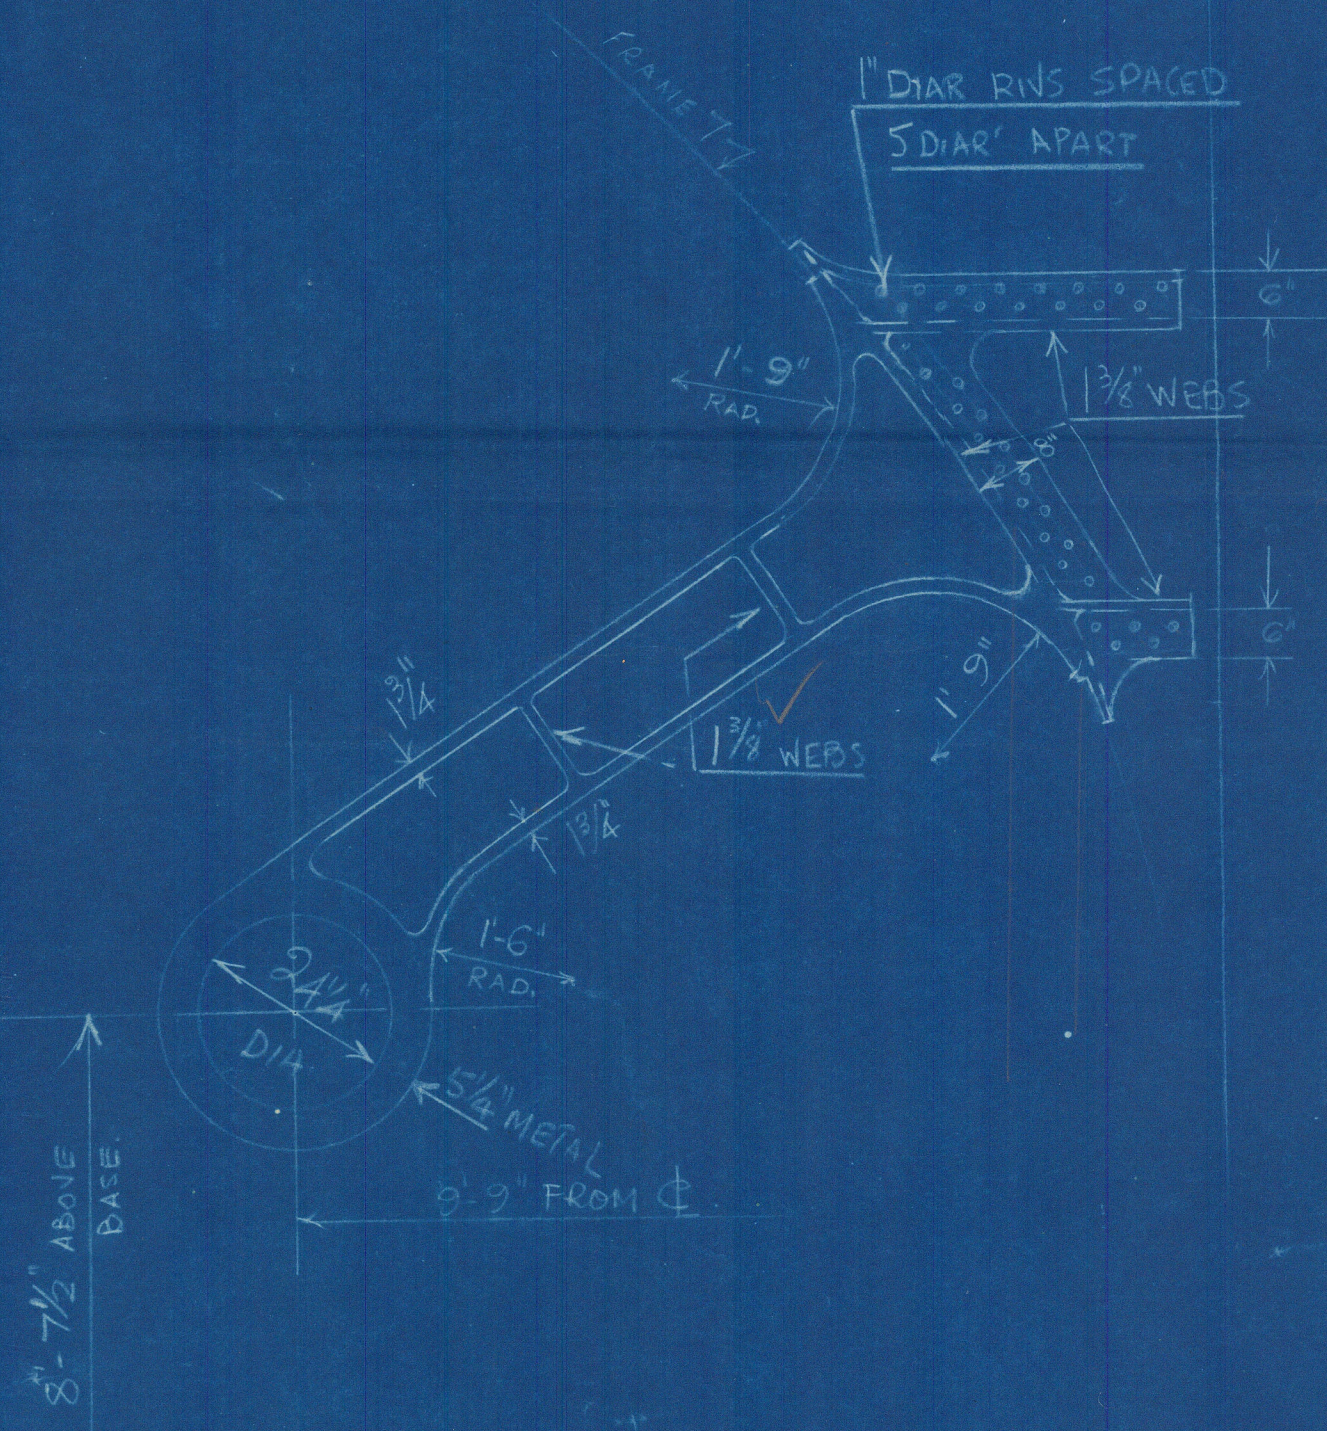

VIEW AT AFT END
LOOKING FOR

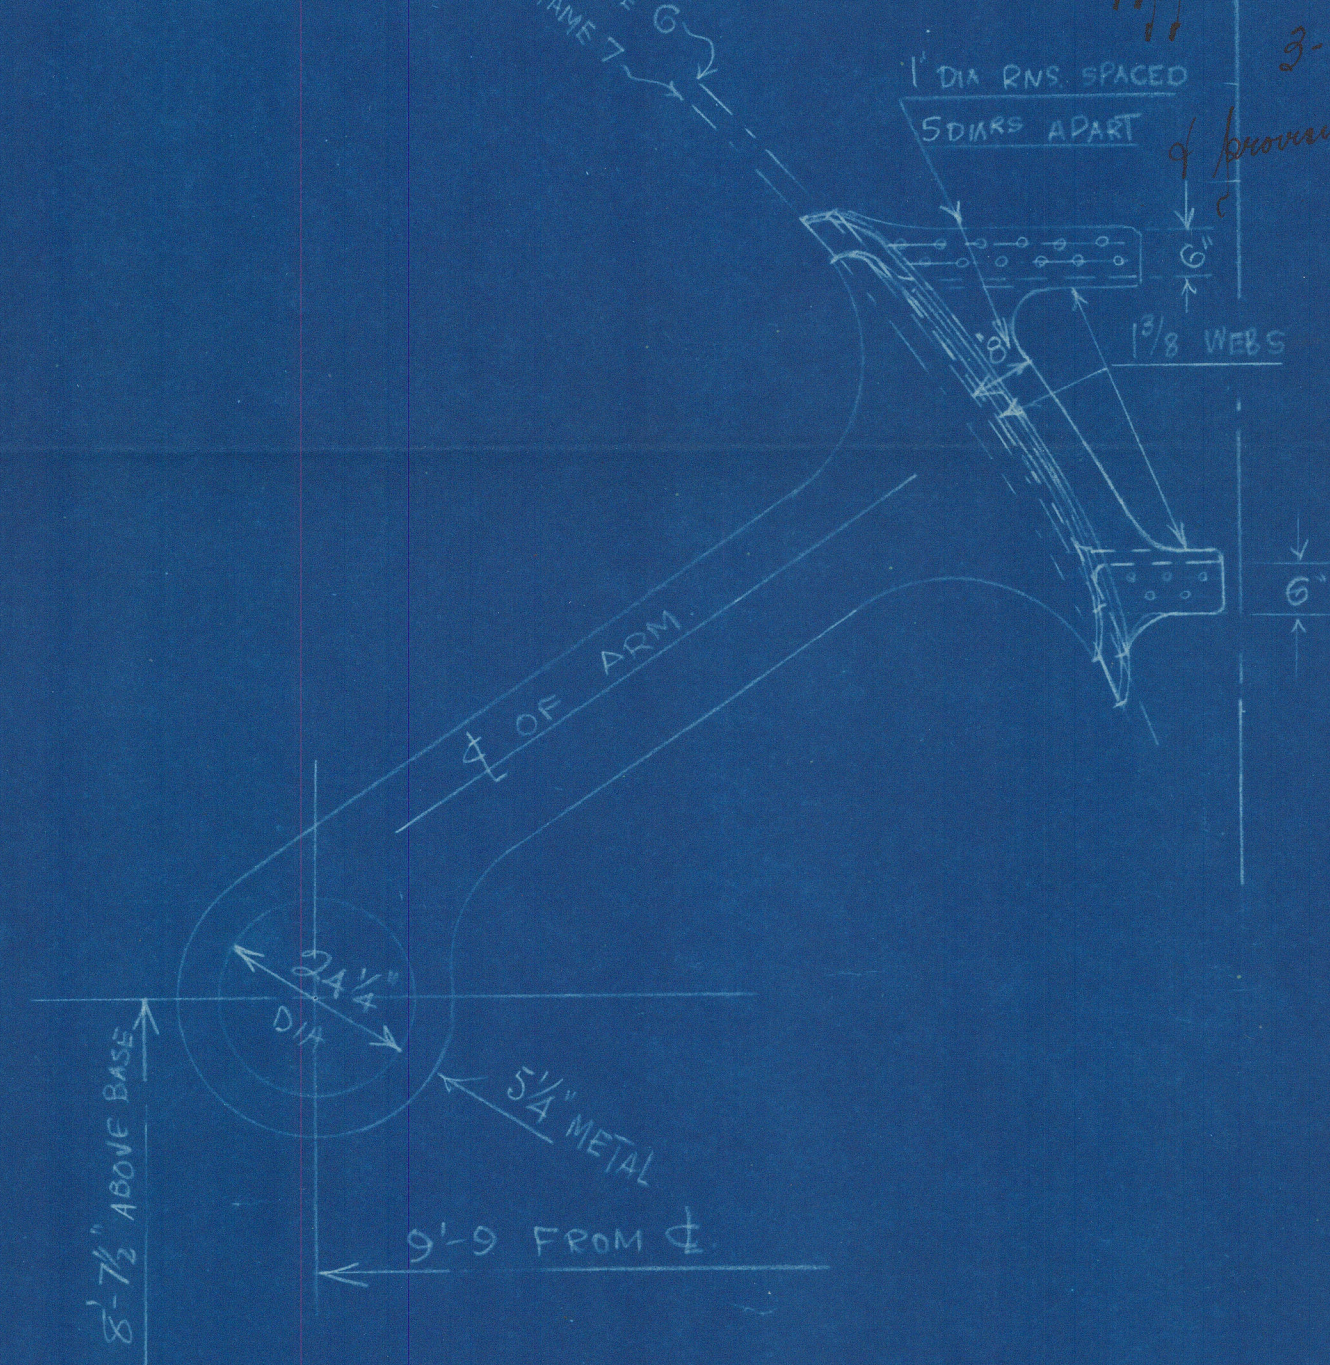

Approved
3-10-28
provisionally on behalf
of R.I.

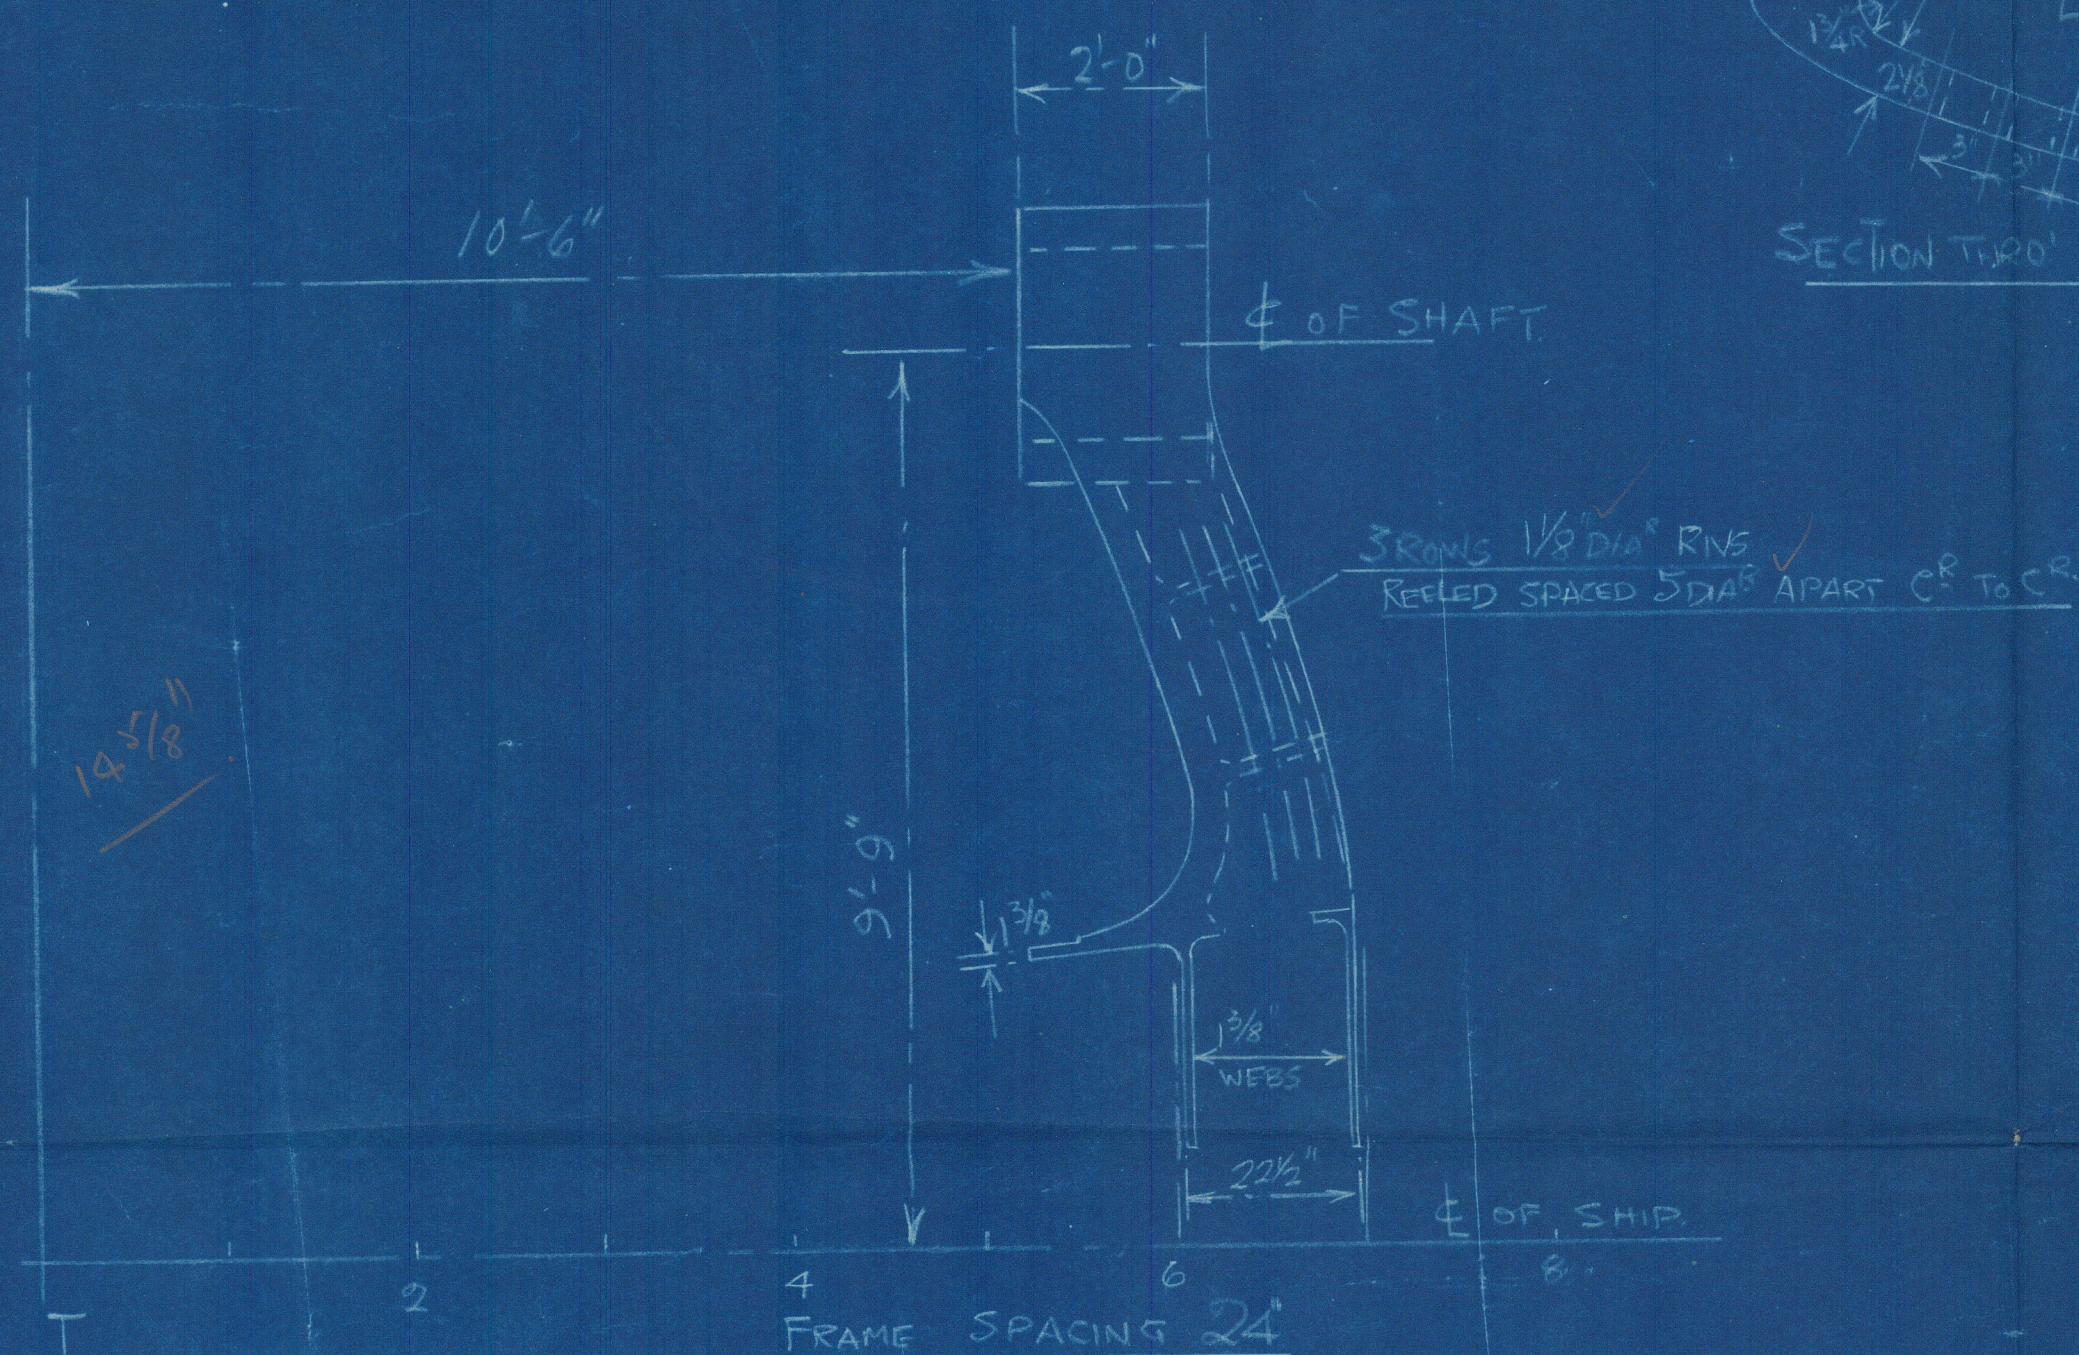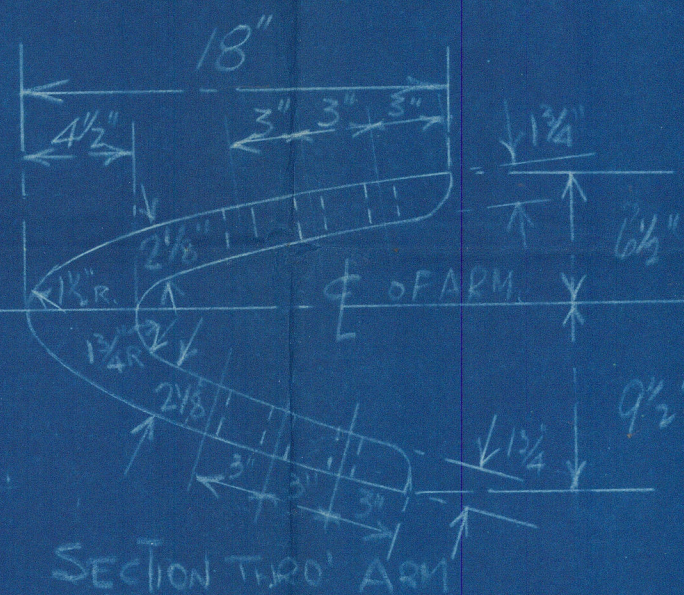

$$N_b = \frac{24 \times 24 \times 8}{100} = 1100$$

$$N_b = \frac{20 \times 8}{100} = 160$$


$$N_b = \frac{16 \times 8}{100} = 128$$

Nº 1302

SHAFT BRACKETS

SCALE 1/2" = 1 FOOT

SHAFT BRACKETS TO BE OF CAST STEEL

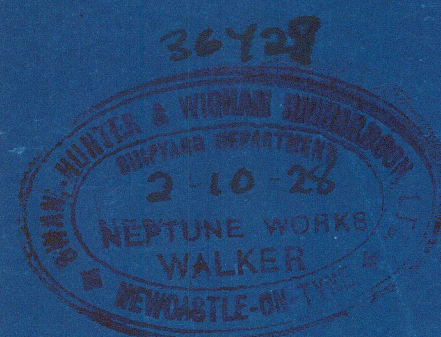

14
TRANSFERRED TO:
L. R. SYSTEM

Shaft Brackets.

Swan Hunter & WH.

.. N^o 1302.

3 - 10 - 28.

"Campiona"

TRANSFERRED TO:
L. R. SYSTEM

TRANSFERRED TO:
L. R. SYSTEM

14
Shaft Bkts

Swan Hunter 1302.

Bag



© 2021

Lloyd's Register
Foundation