



TUG "ST. ATHAN" ST. BOTOLPH

OIL FUEL BUNKERS


SCALE 1/2" = 1 FOOT

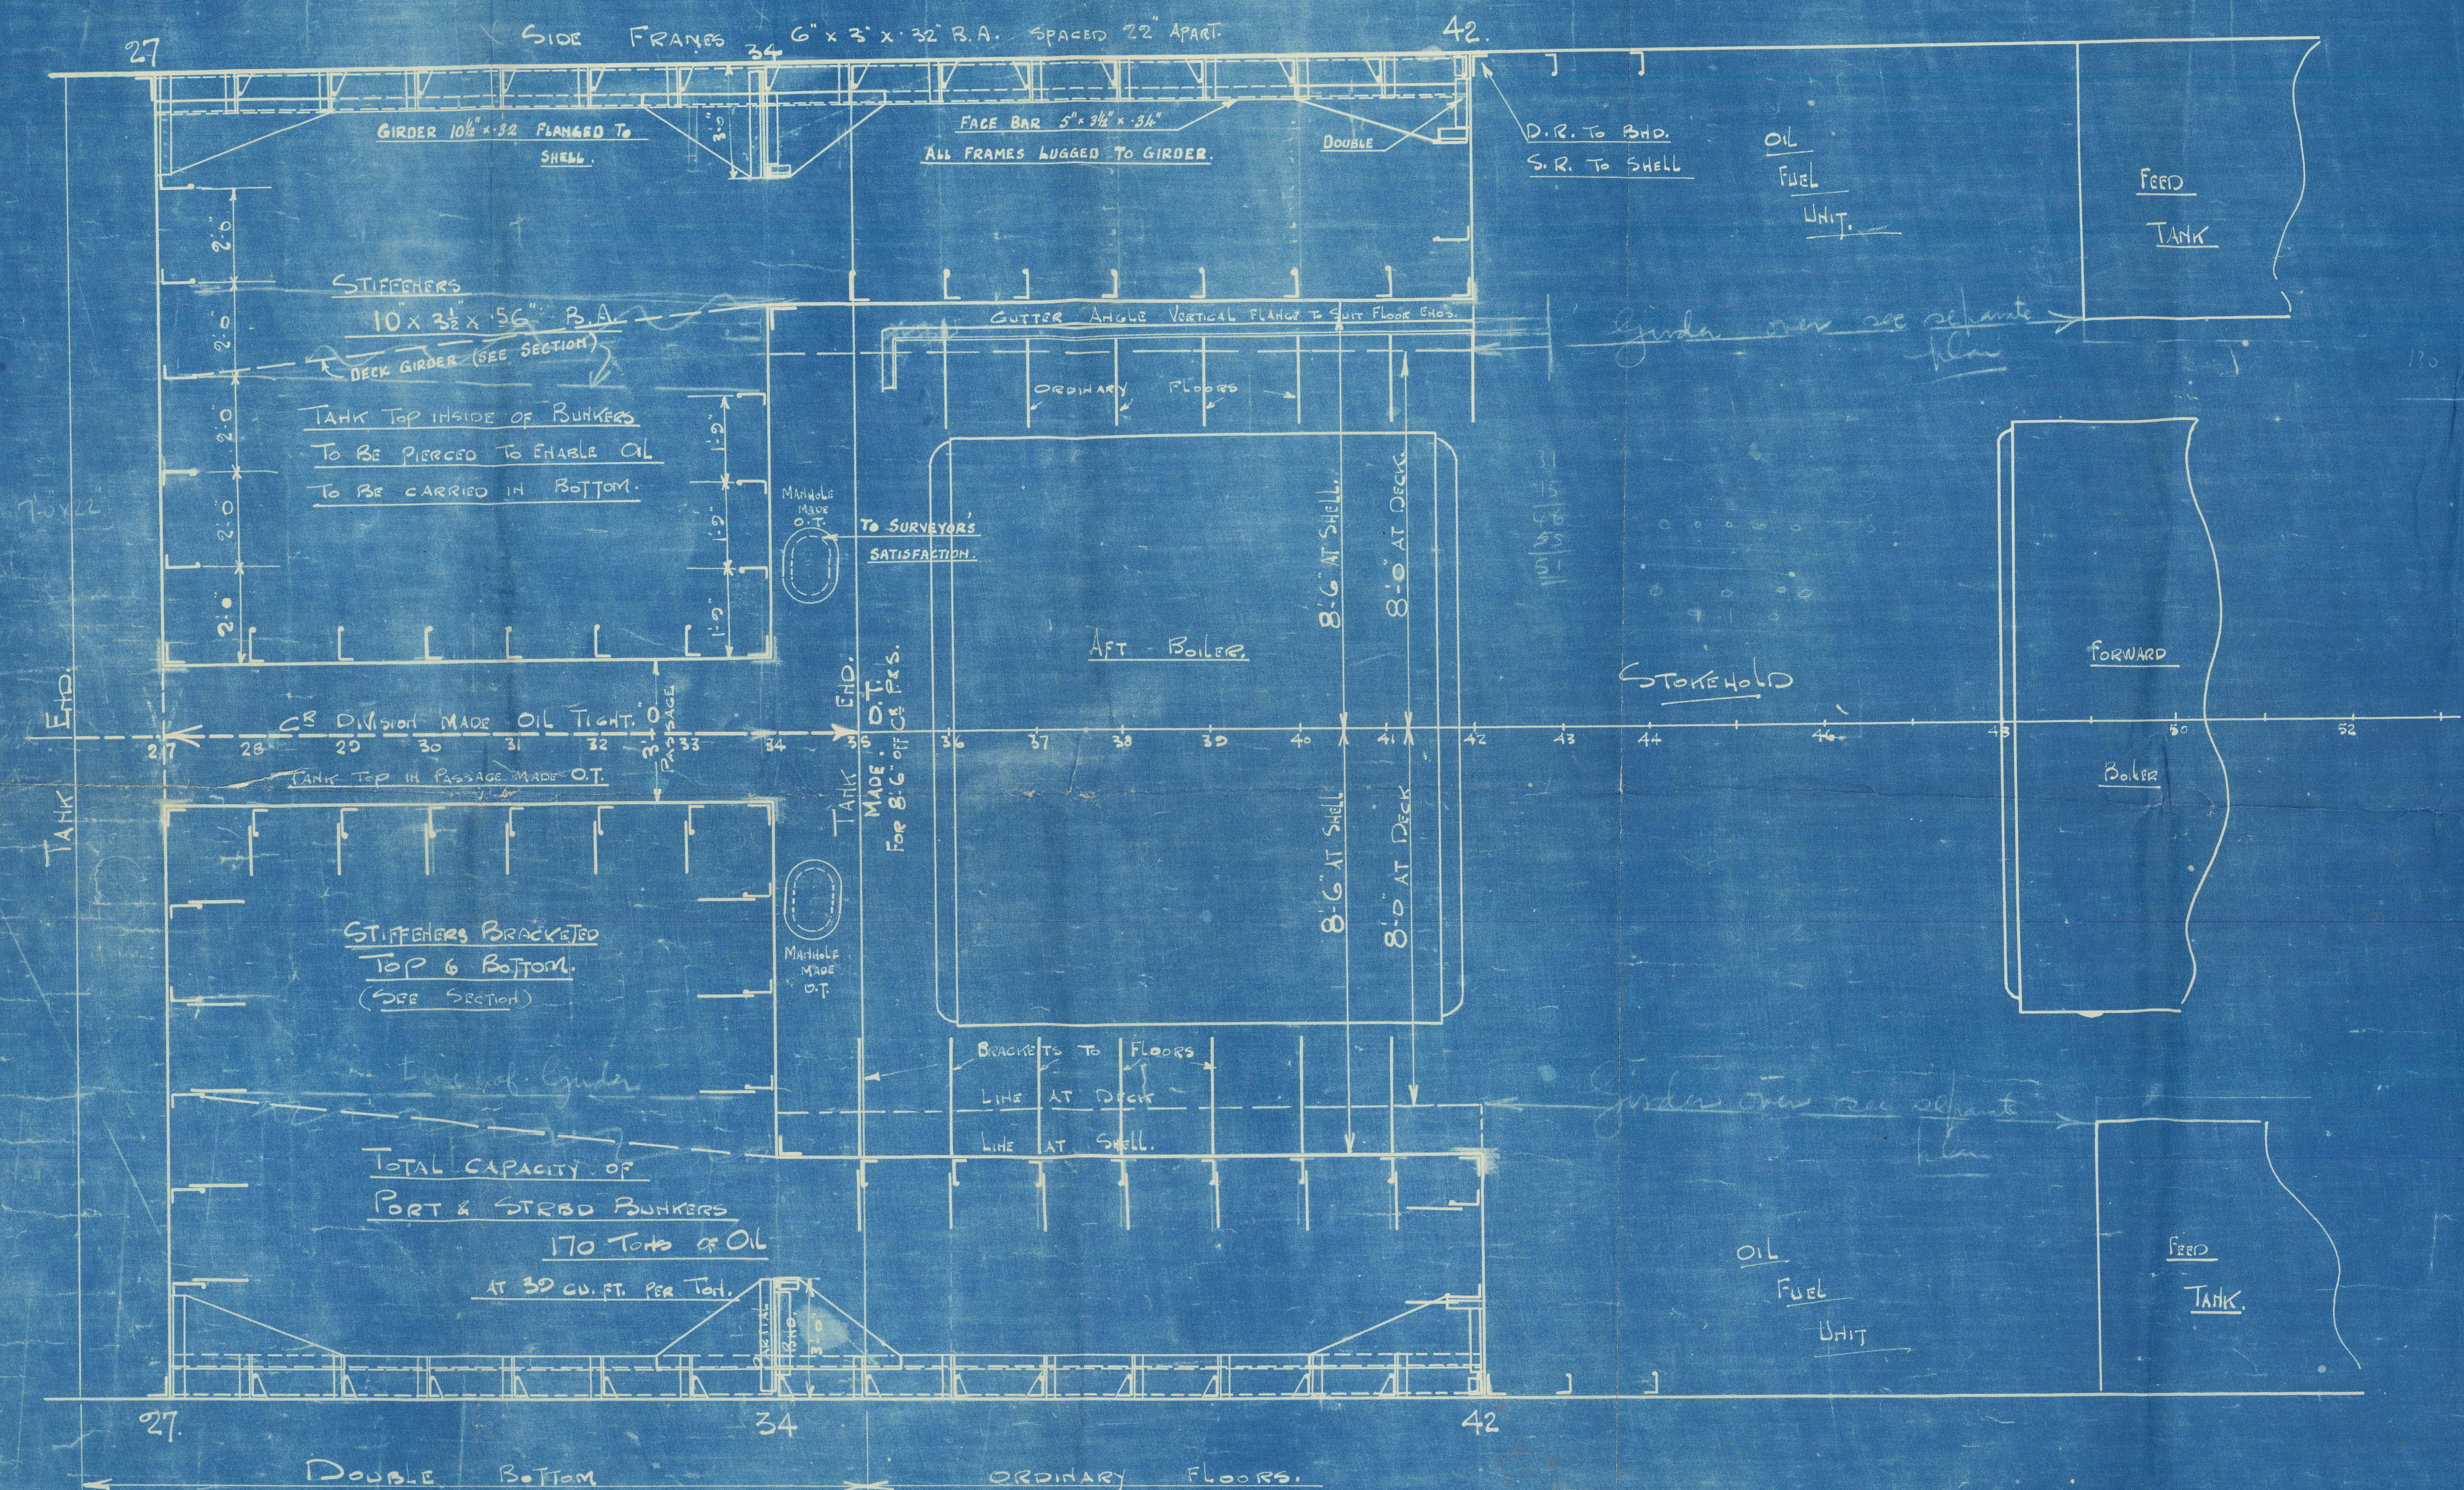

O.T. BULKHEAD No 27 P.S.

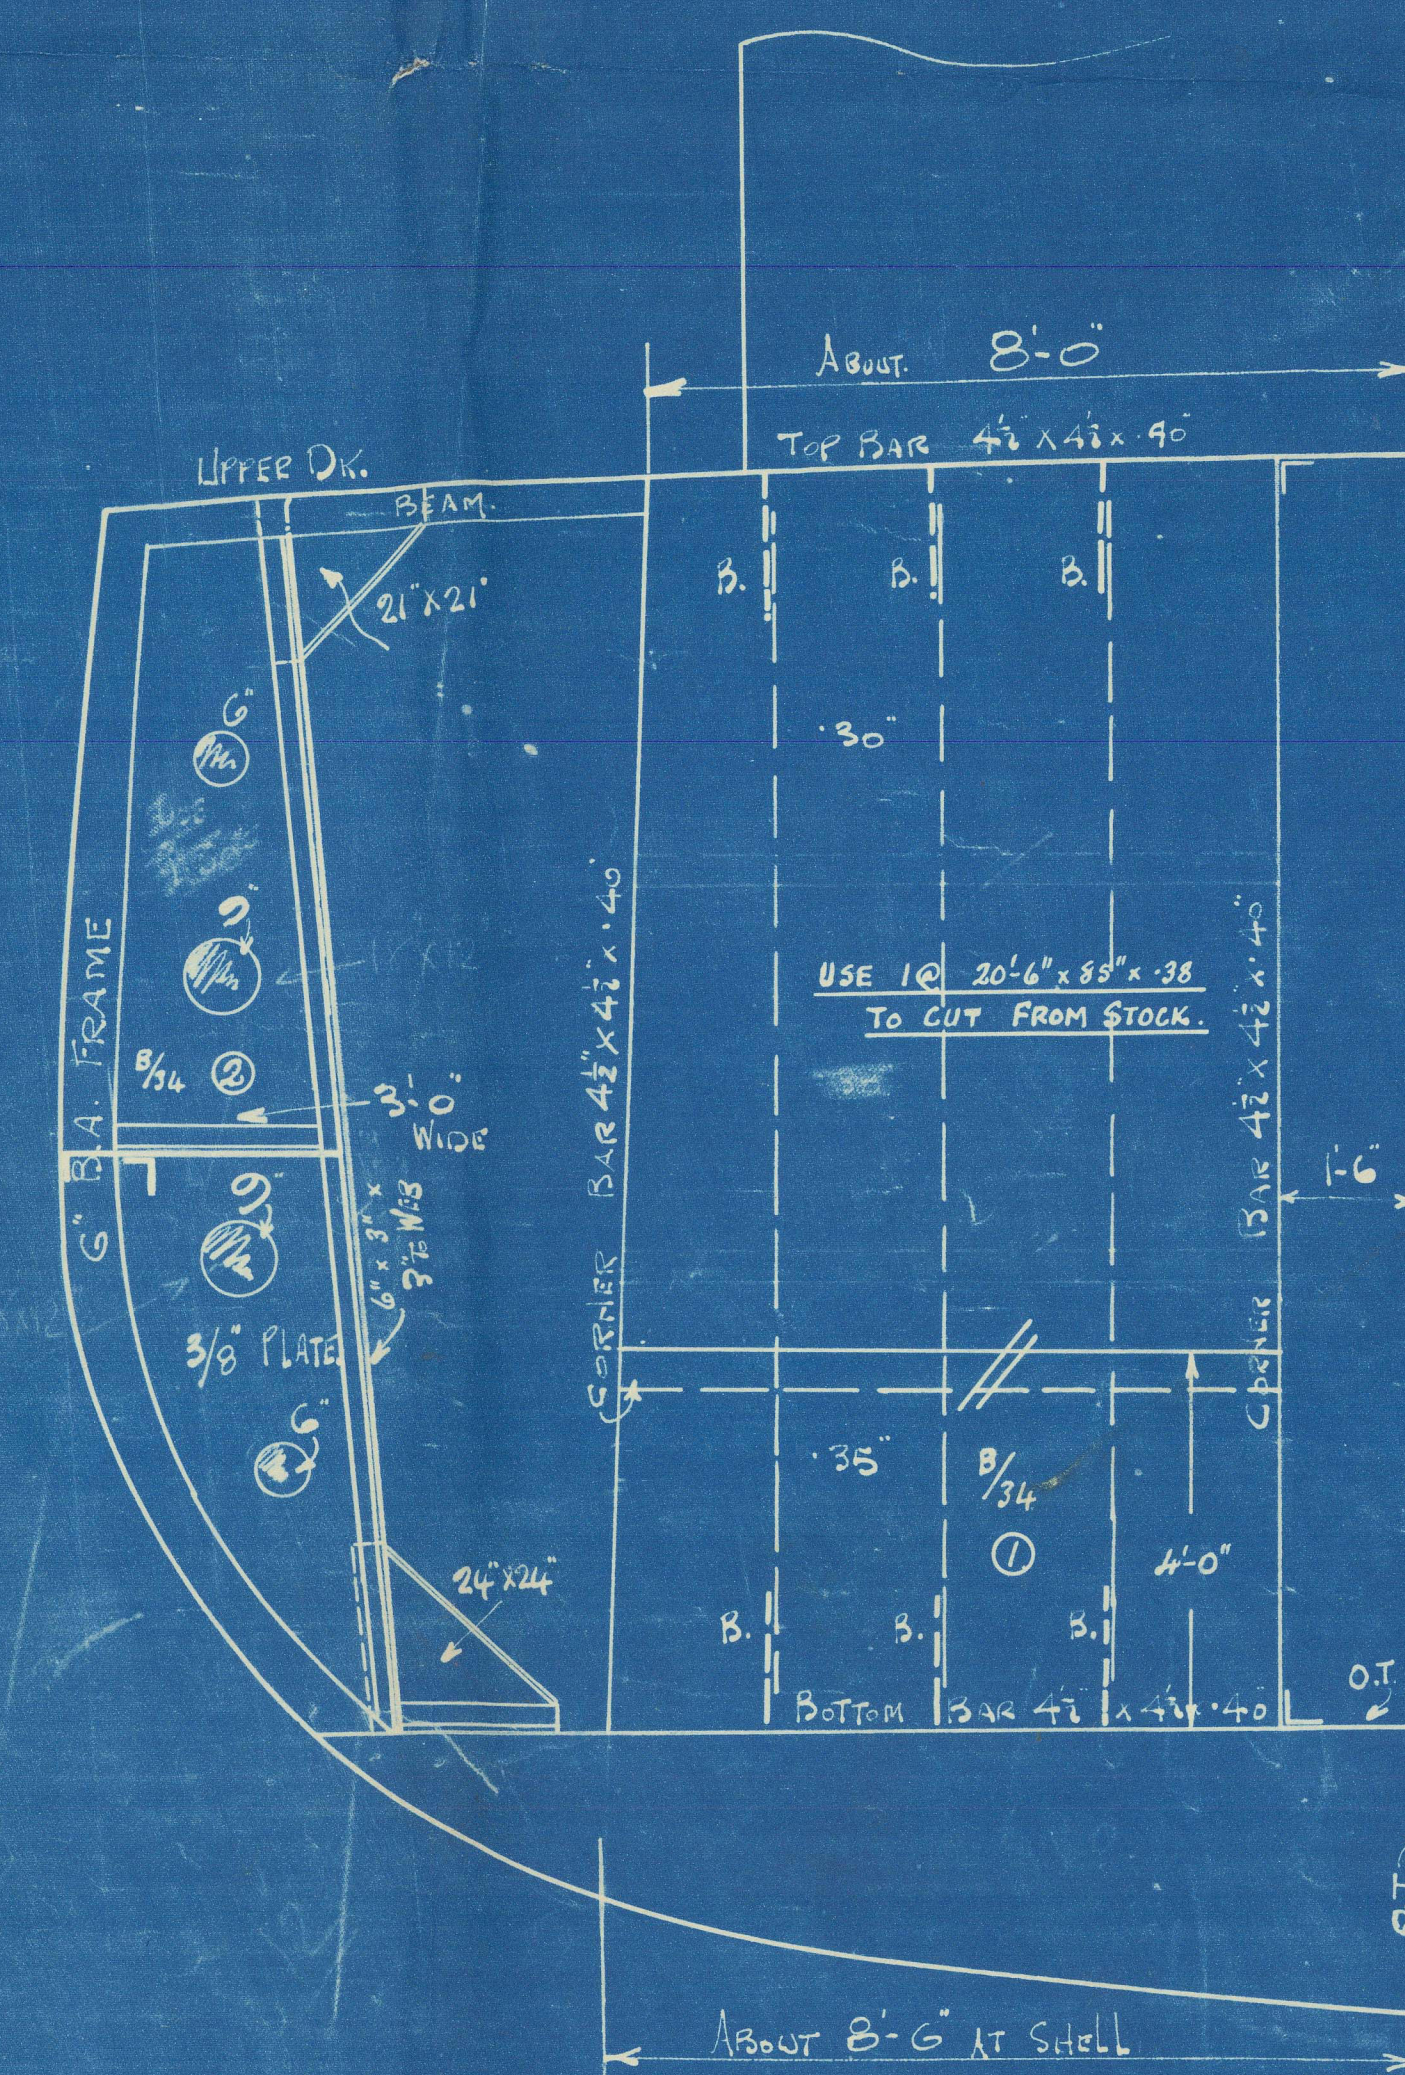


O.T. BULKHEAD No 34 P.S.

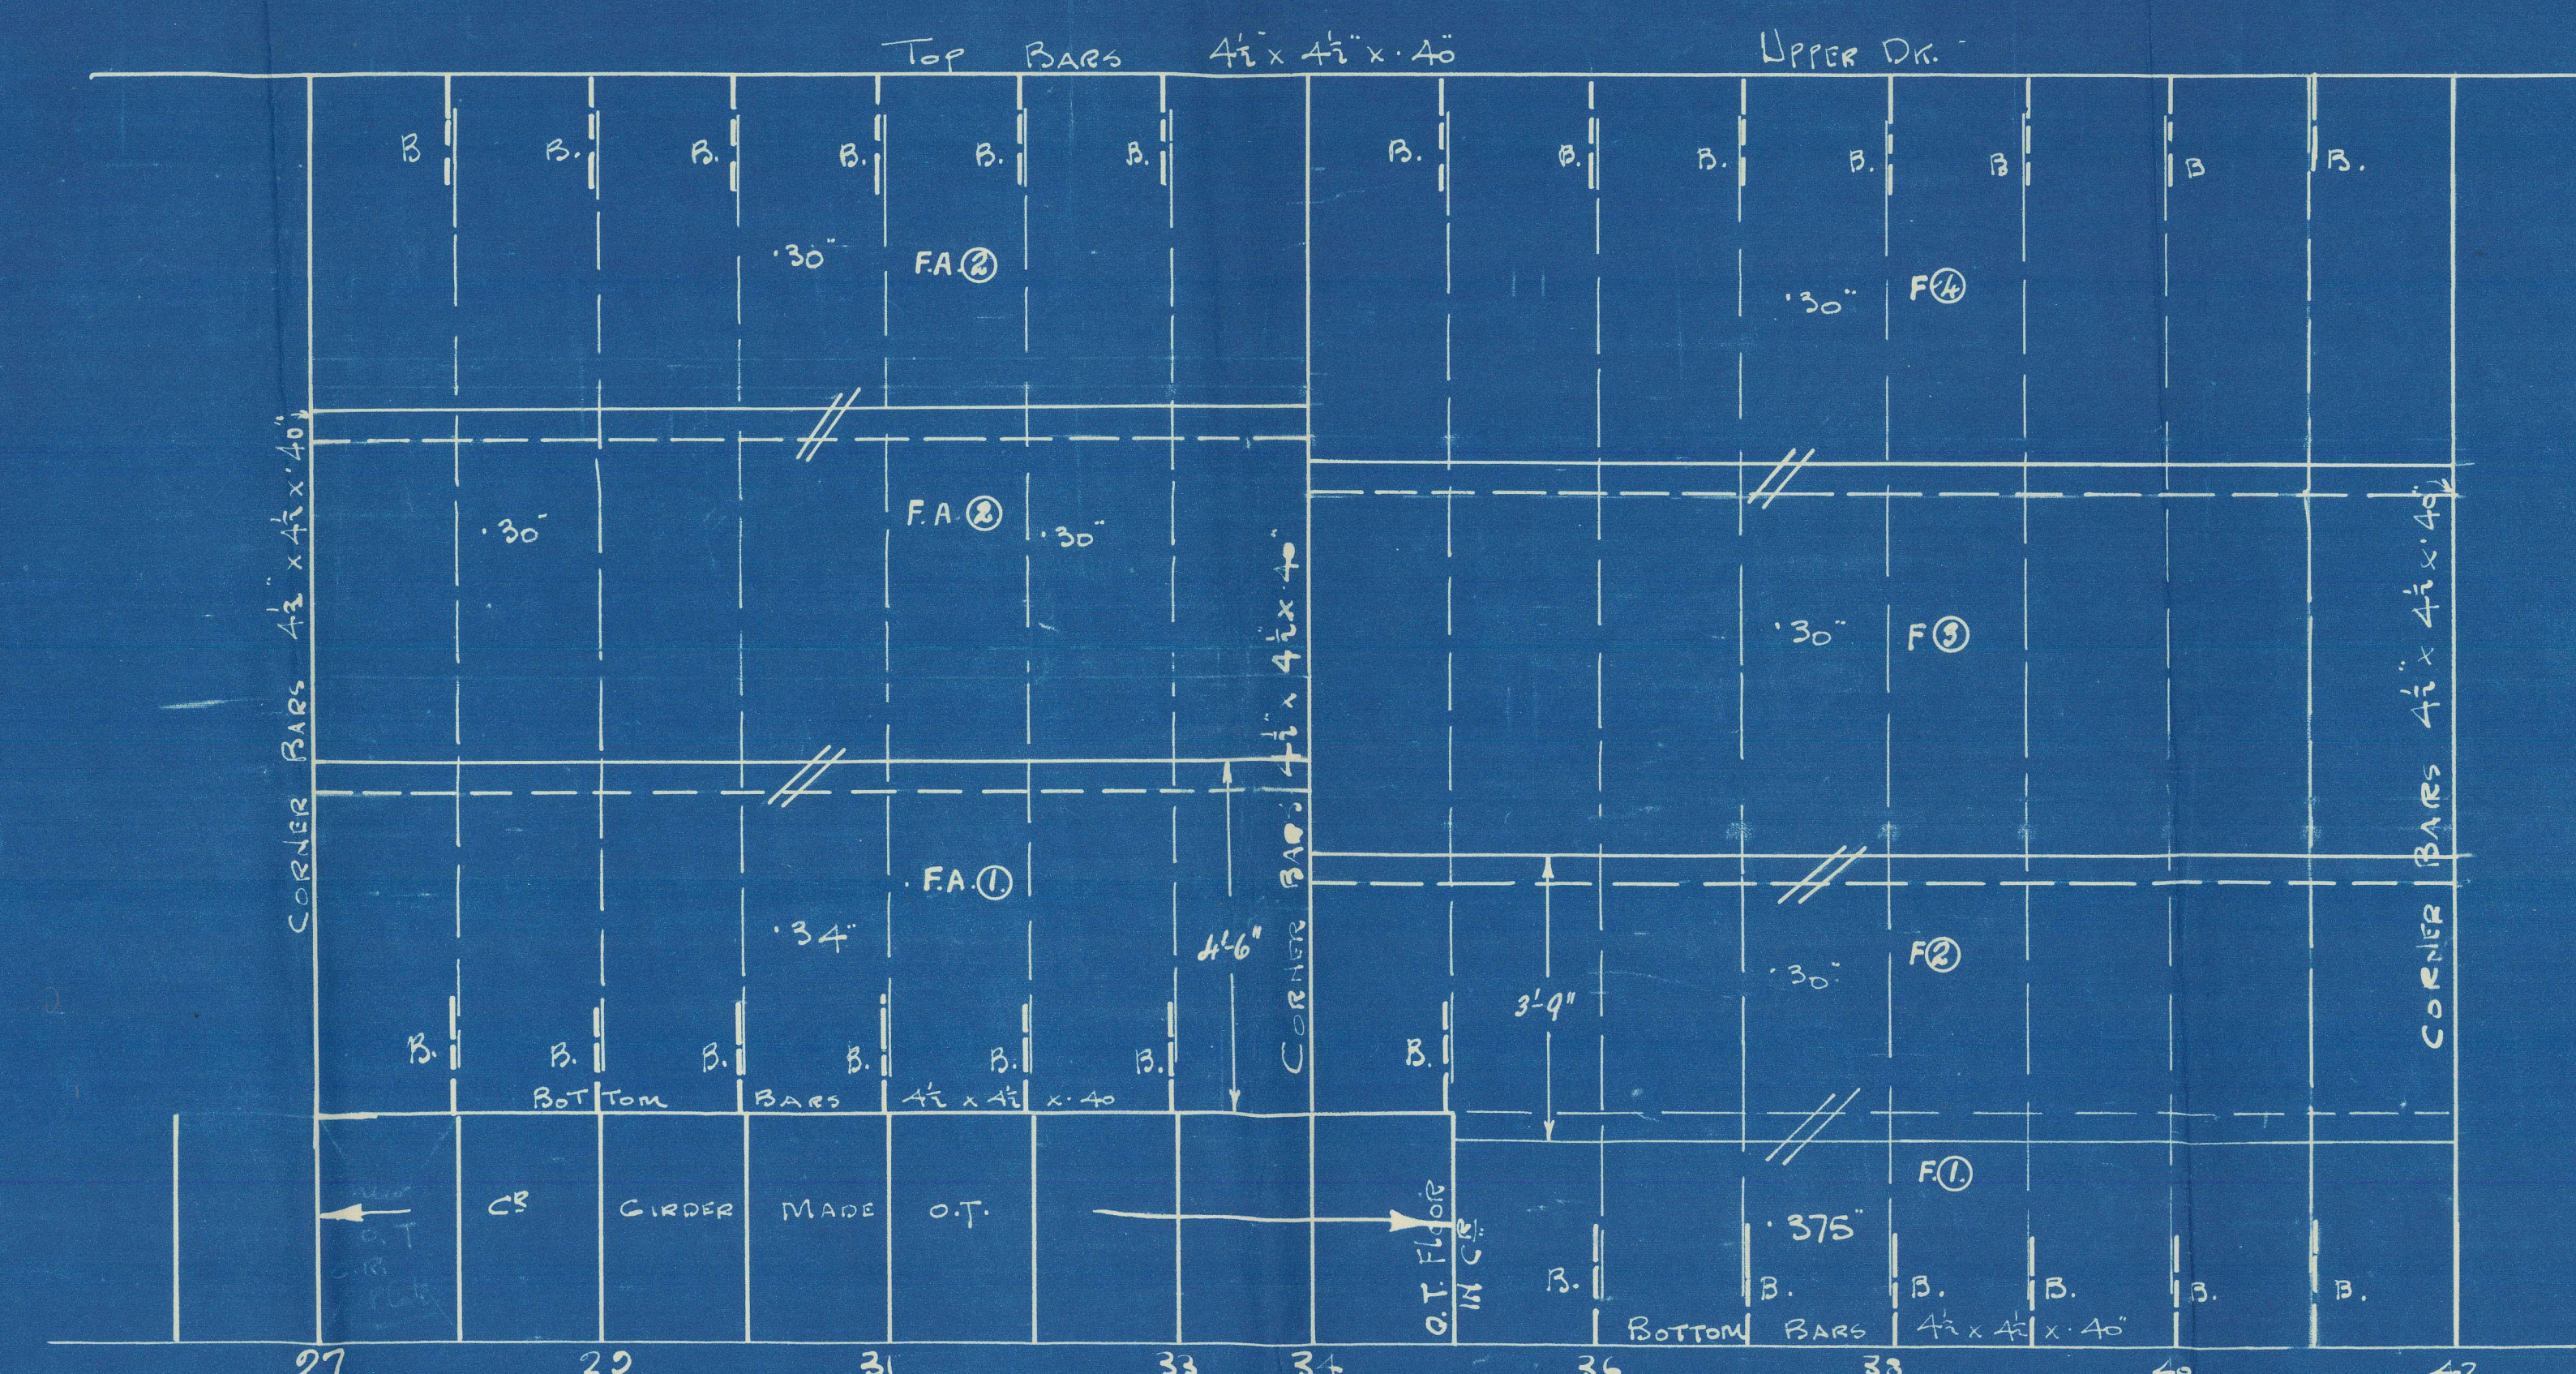


O.T. FORE & AFT BULKHEADS.




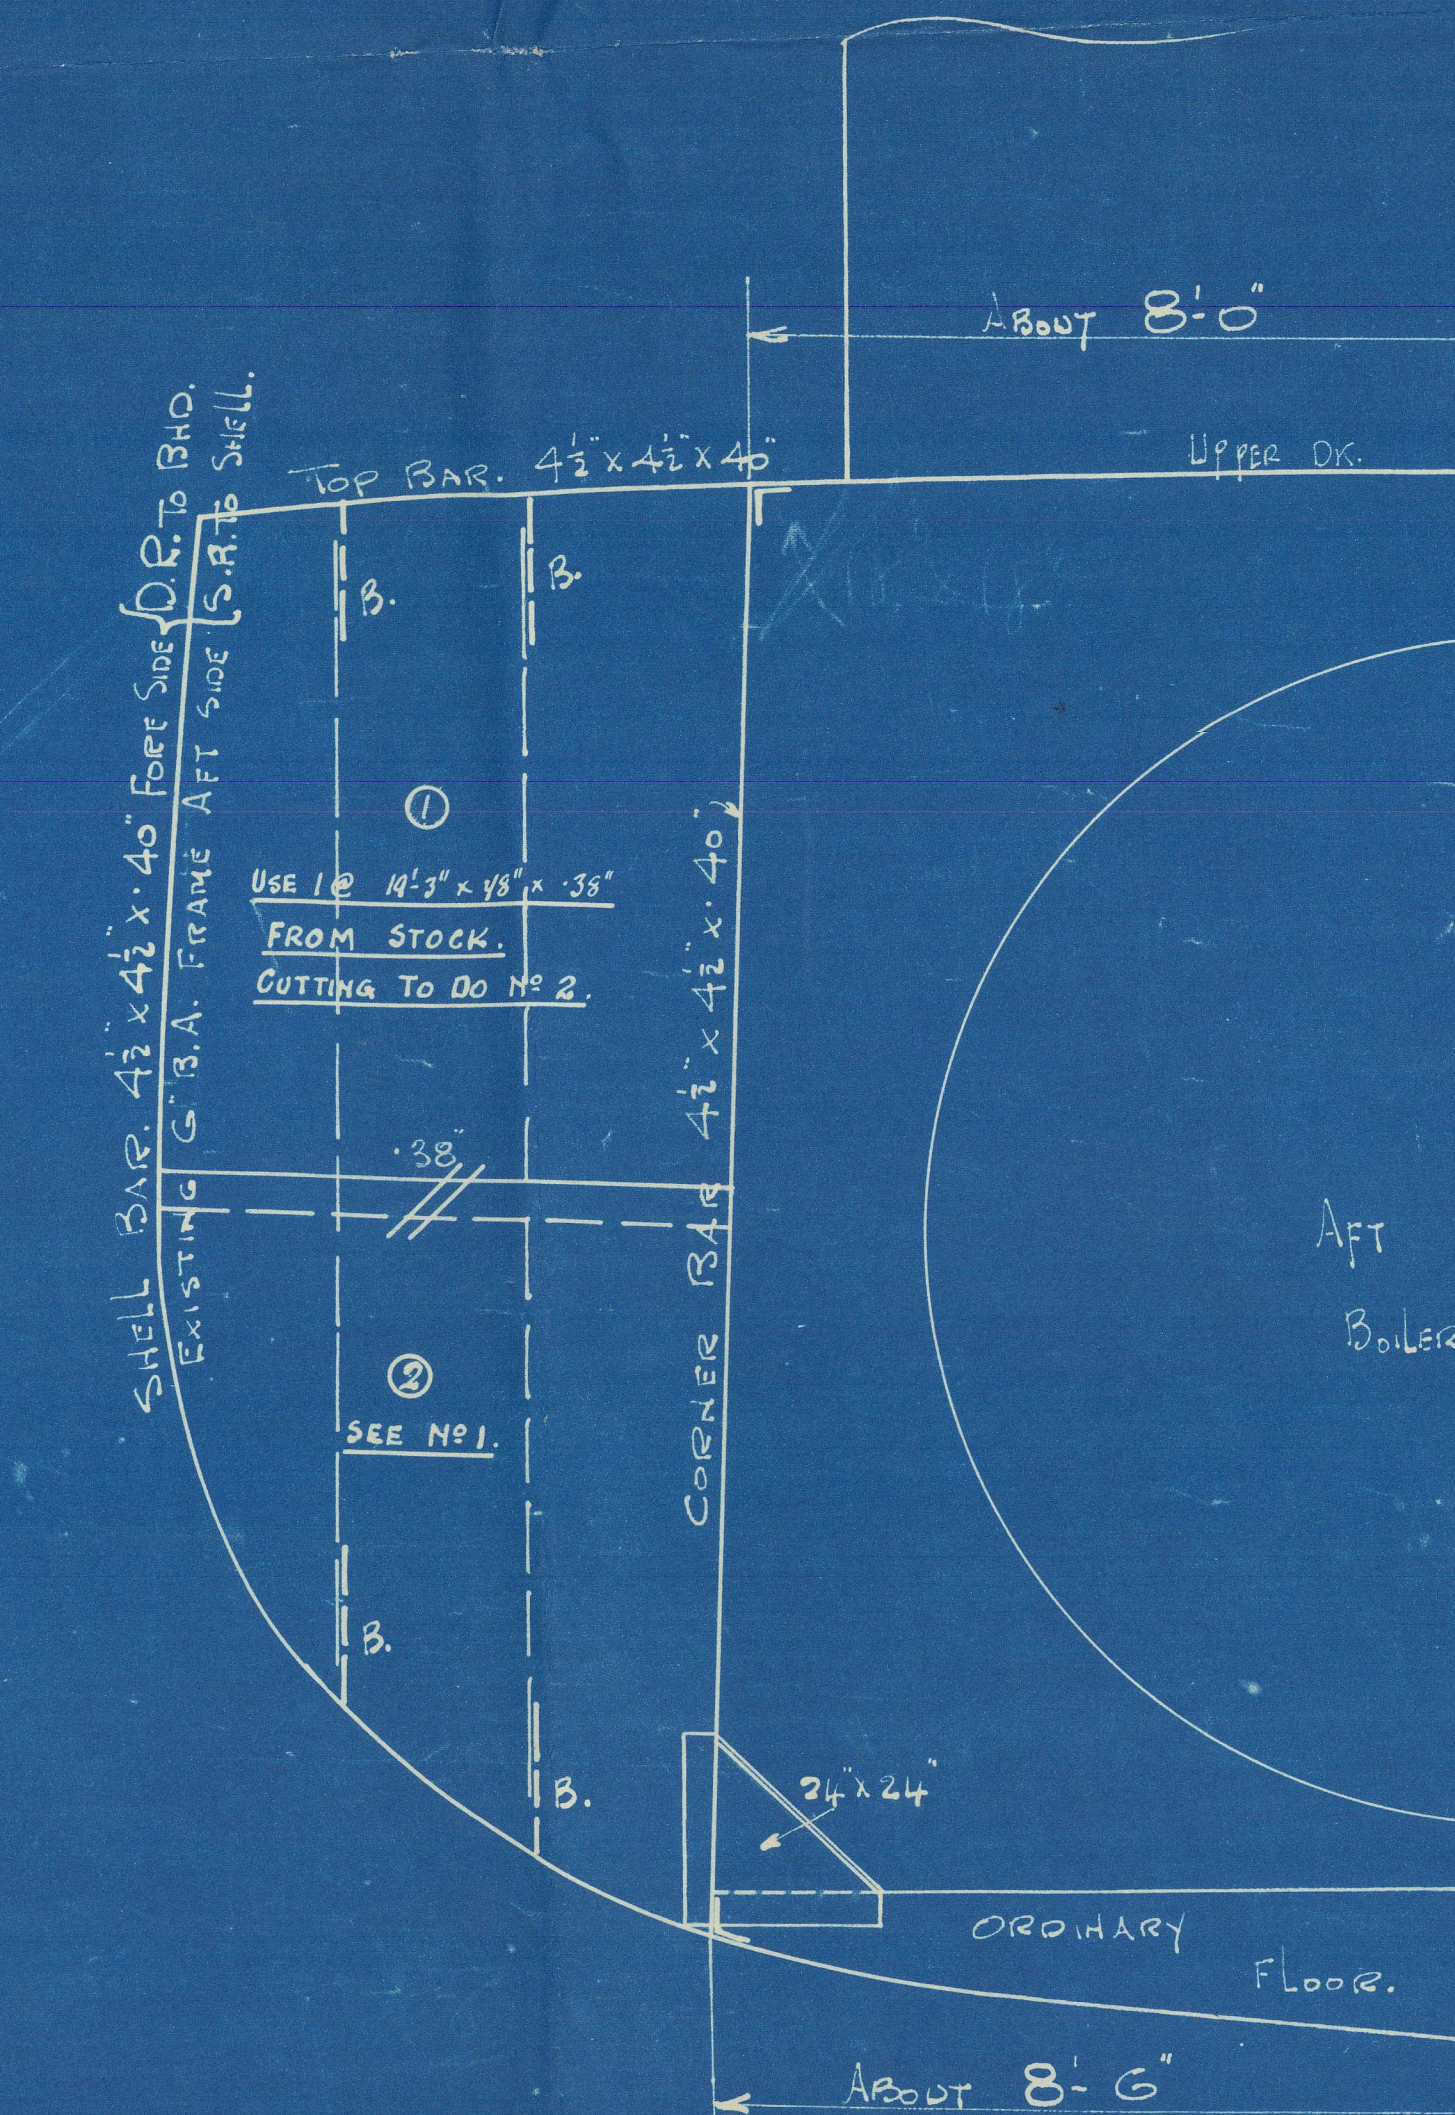

O.T. BULKHEAD No 42 P.S.

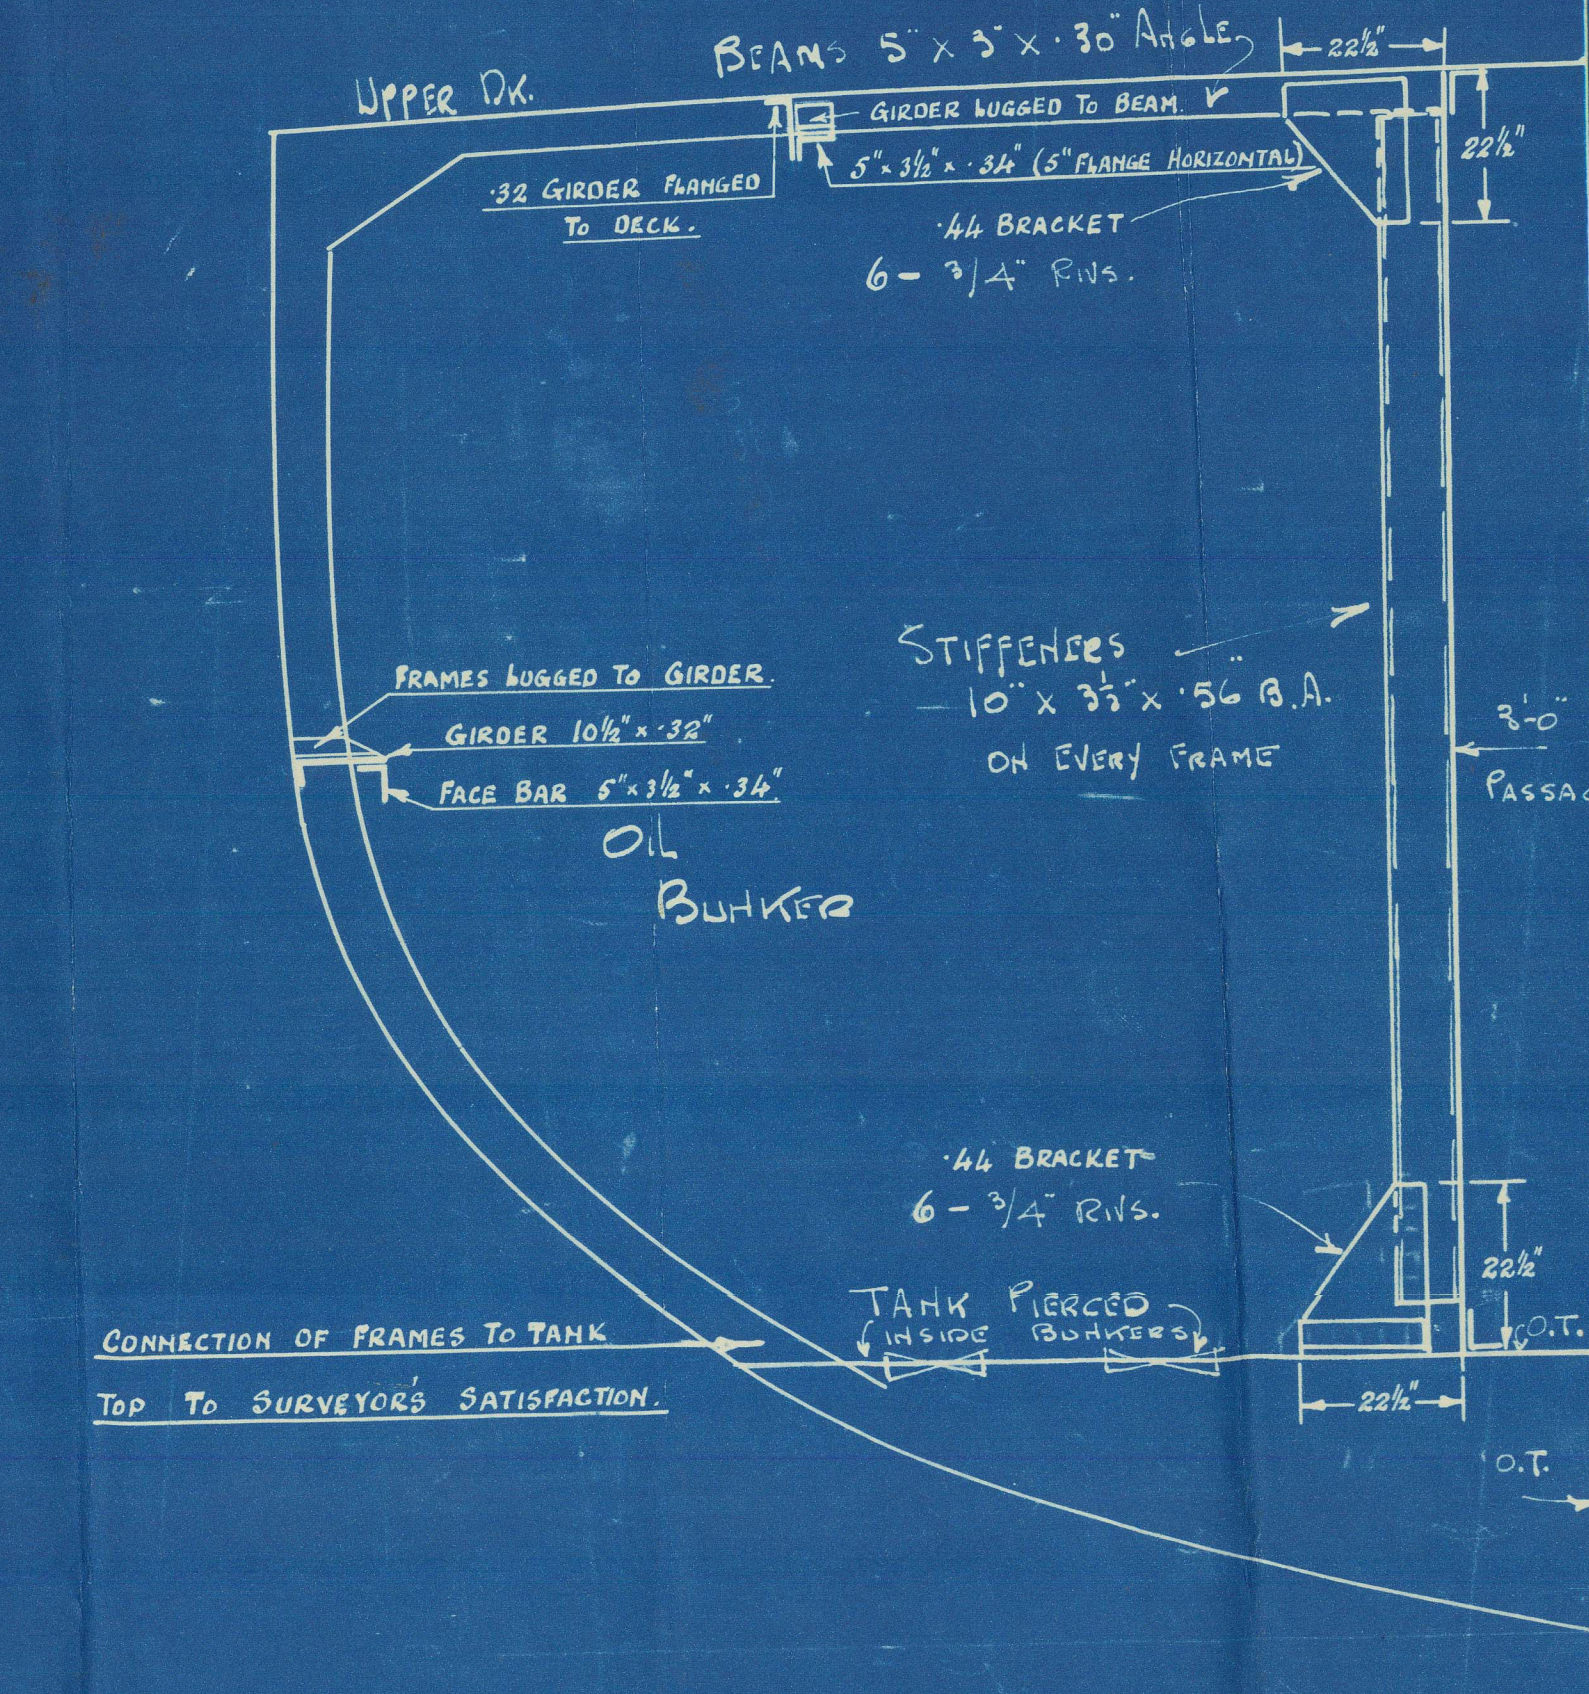

SECTION ABOUT 31.

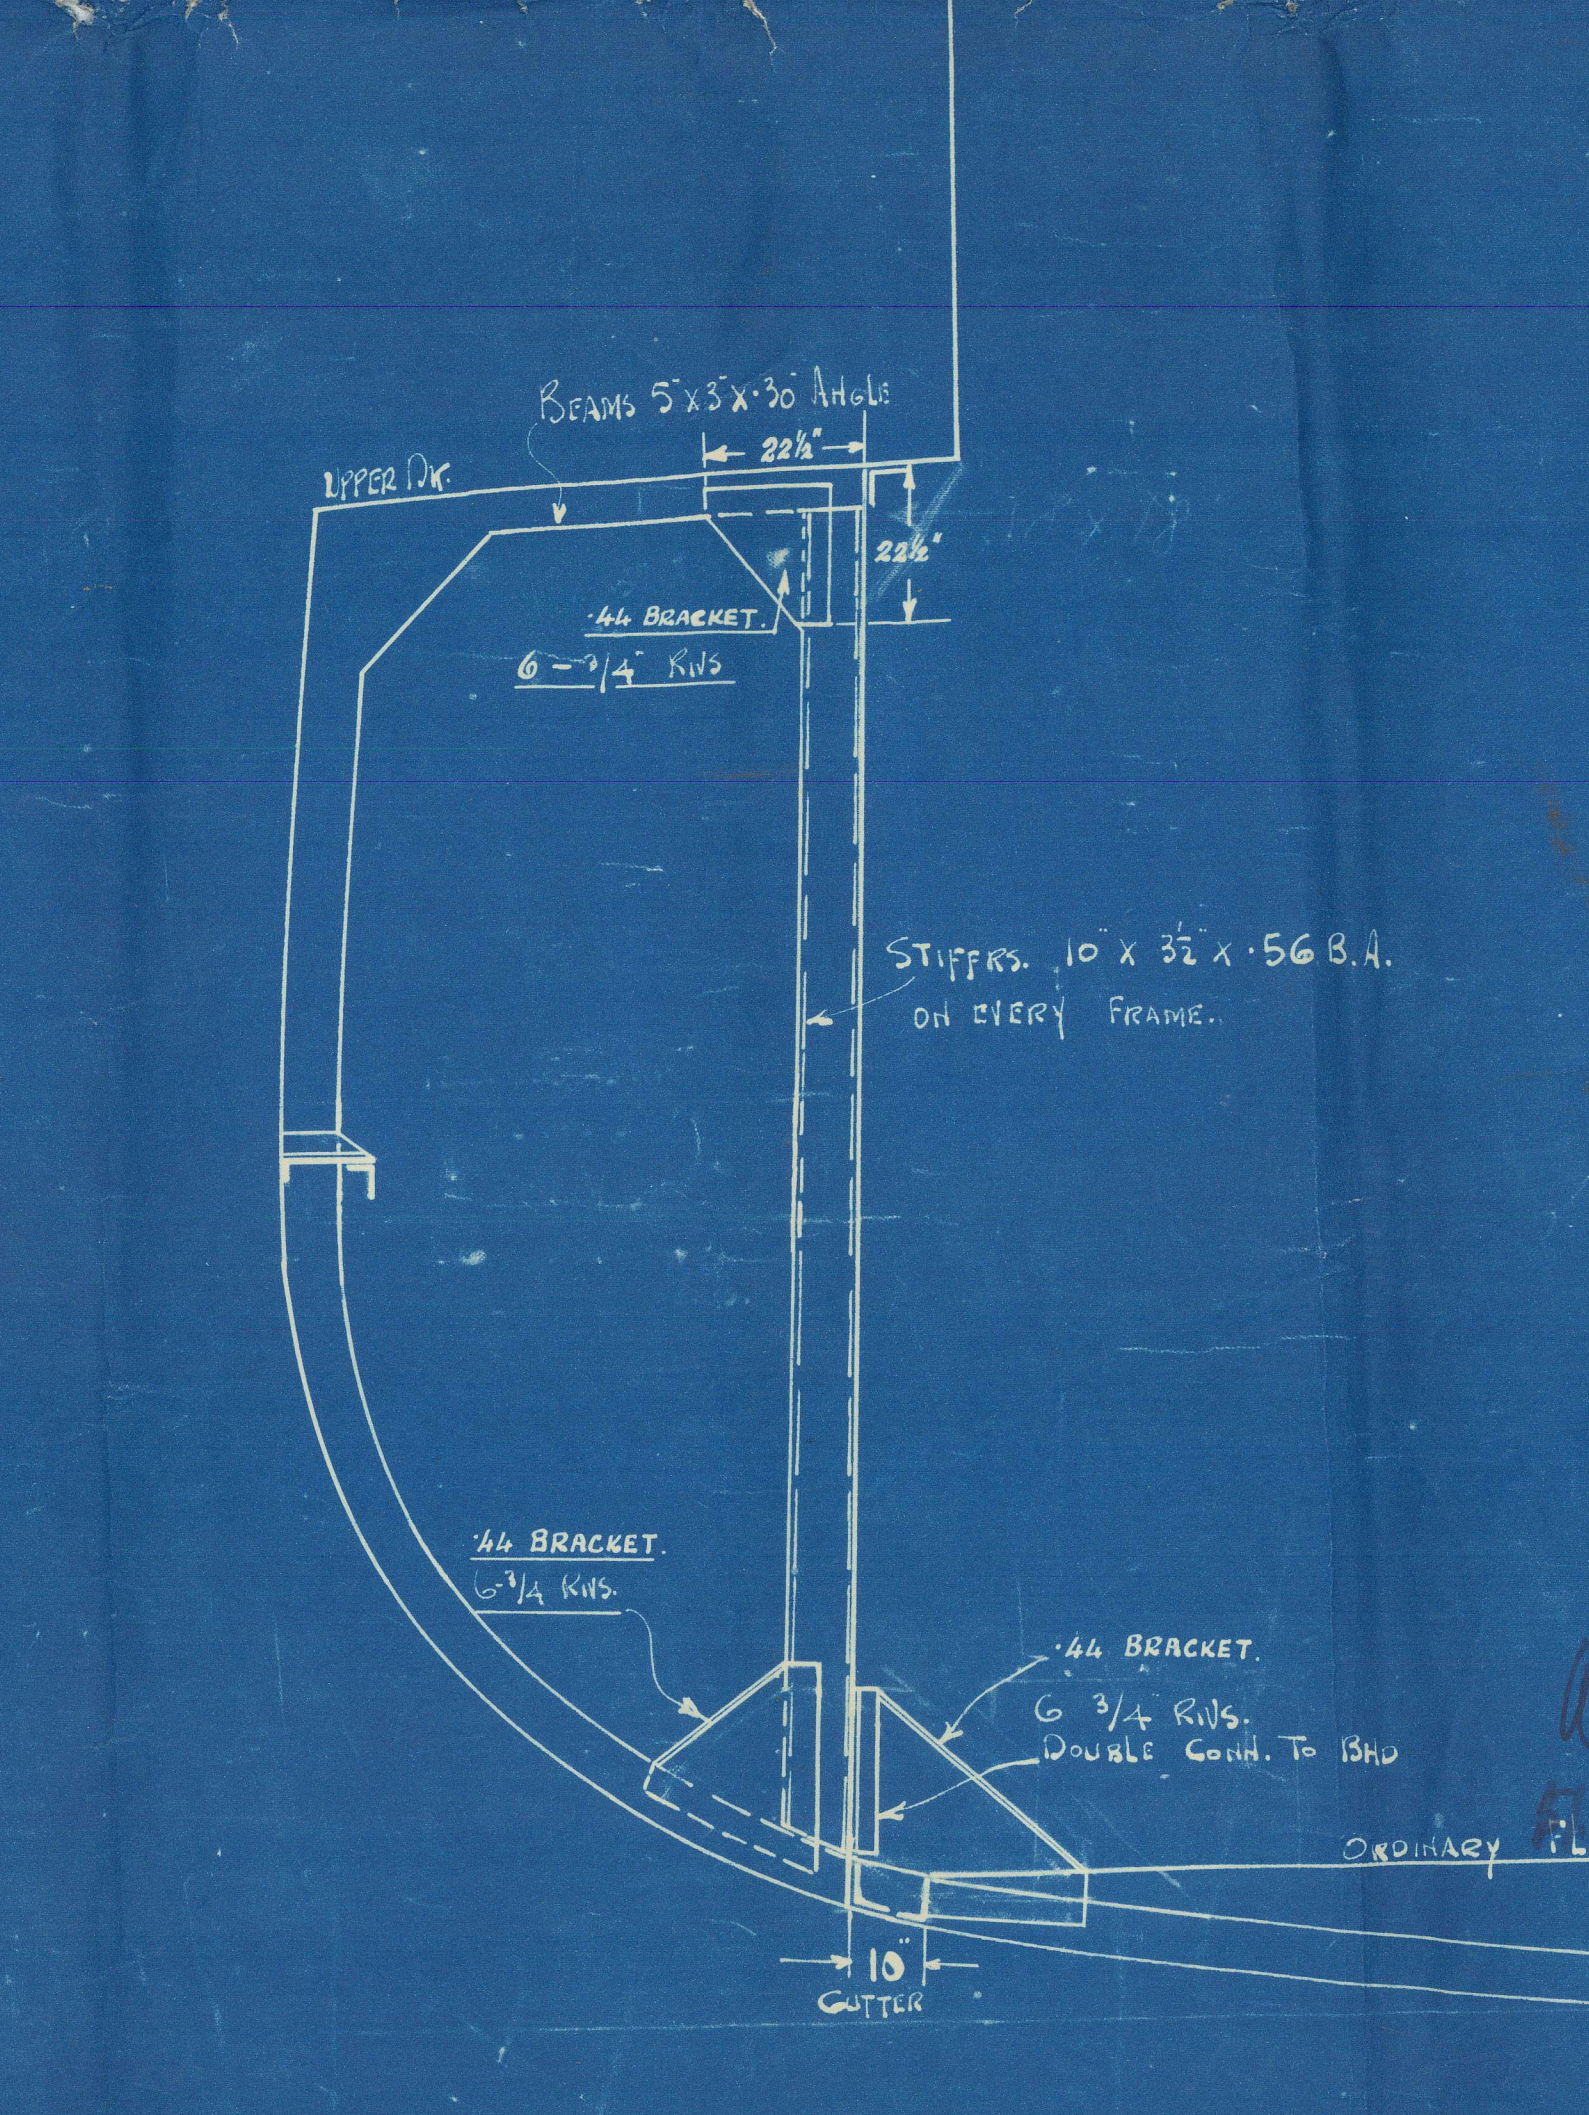


SECTION ABOUT 38.

THE REQUIREMENTS OF SEC. 47 TO BE COMPLIED WITH.
GUTTERS TO BE ARRANGED WHERE REQUIRED TO SURVEYOR'S SATISFACTION.
BEAMS & BUTTS OF DECK & SHELL PLATING WHERE SINGLE RIVETED TO BE ELECTRICALLY WELDED.

012108-01212-063

S/T SI BOTOLPH 4

Oil Fuel Bankers

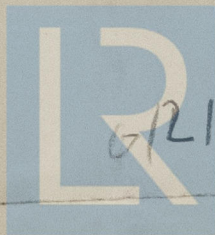

© 2021

6/2/68-6/2/12-0068

Lloyd's Register
Foundation